IREDELL COUNTY HEALTH DEPARTMENT

STATESVILLE 704-878-5305 MOORESVILLE 704-664-5281

IMPROVEMENT PERMIT / AUTHORIZATION TO CONSTRUCT / OPERATION PERMIT / EXISTING SYSTEM INSPECTION

PERMIT# 082066 PIN# 4778 17 6568 DATE 7-3-99

OWNER OR CONTRACTOR KENYA MARTIN PHONE: Business 878-9595 Home

ADDRESS 908 OSTWALT AMITY, STATESVILLE NC 28677

LOCATION US 21 N, TR CHIEF THOMAS RD, TR HARMONY BLVD,

SUBDIVISION EASTON Acres BLOCK / SECTION LOT 5 LOT AREA 0.94 ACRE SITE CLASS PS DESIGN FLOW 360 L.T.A.R. 0.33 gpd/ft2

Septic Tank: 1000 Gallons; STB 1017 Date 5-10-99

Pump Tank: Gallons; PT Date

Pump Make: Model Serial No.

Nitrification Field: No Fields 1 Square Feet 1080 Linear Feet 360

No Lines FOUR Trench Width 36" Max Trench Bottom Depth 36" Gravel Depth 12"

☑ New System ☐ Repair System Type: I II III IV V VI

System Description: CONVENTIONAL GRAVITY

Repair System Description: 25% REDUCTION, pump

Maintenance Agreement Required: ☐ Yes ☑ No

☐ House/Mod. Home ☑ Mobile Home ☐ Business ☐ Other

No. Bedrooms 3 No. Bathrooms 2 No. Employees


☐ Slab ☑ Crawl Space ☐ Basement w/plumbing ☐ Basement wo/plumbing

Water Supply: ☑ Individual ☐ Public ☐ Community WELL


Comments/Conditions: KEEP SYSTEM MINIMUM 100 FEET FROM WELL

Comments/Conditions:

INITIAL SITE SKETCH SCALE: 1" = 50'

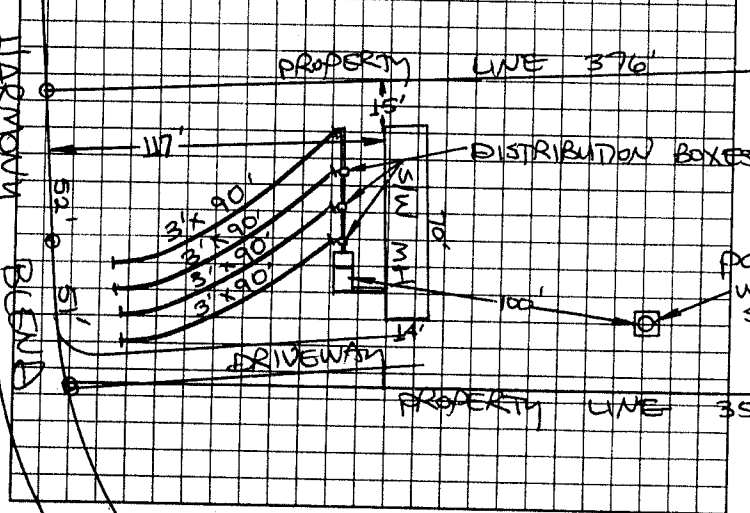

AS BUILT SKETCH

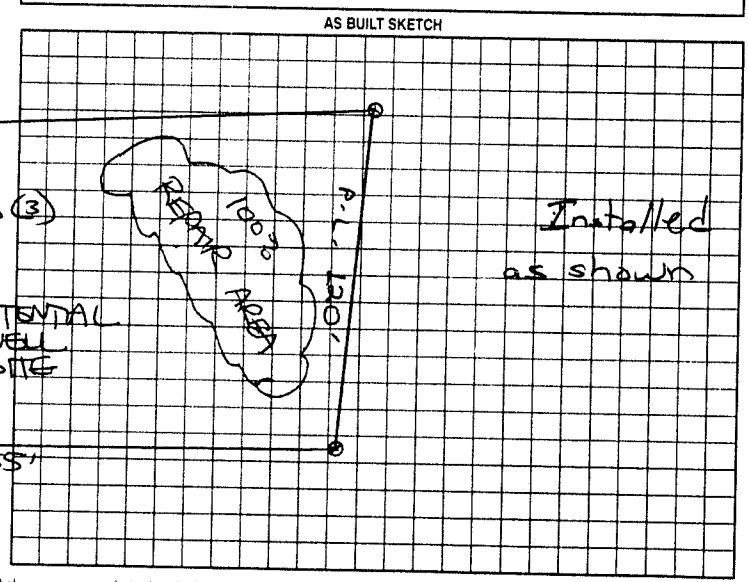

Permit can be suspended or revoked if any false information is supplied toward securing the permit/any unauthorized changes are made to the site/any unauthorized changes are made in the installation of the system. Improvement Permit with plat valid without expiration. Improvement Permit with site plan valid for sixty months. Authorization to Construct is valid for a period equal to that of Improvement Permit – not to exceed sixty months.

Signed: Sherrie Kehue - Fraster date 7-6-99 Installed by: A-1 Backhoe

Improvement Permit by: STEVE HEDRICK date 7-3-99 Operation Permit by: Mark Cox RS date 7-9-99

Authorization to Construct by: STEVE HEDRICK date 7-3-99 Existing System Inspection by: date

HEALTH DEPT. COPY: WHITE OWNER COPY (FINAL): YELLOW OWNER COPY (INITIAL): PINK