IREDELL COUNTY HEALTH DEPARTMENT

STATESVILLE 704-878-5305 MOORESVILLE 704-664-5281

IMPROVEMENT PERMIT / AUTHORIZATION TO CONSTRUCT / OPERATION PERMIT / EXISTING SYSTEM INSPECTION

PERMIT# 130246 PIN# 4778-17-6568 DATE 8-12-05

OWNER OR CONTRACTOR MOISES No. RODRIGUES PHONE: Business Home 704-450-5983

ADDRESS 2229 CASMORE RD, BOONEVILLE, NC 27011

LOCATION US 21 N, TR CHIEF THOMAS, TR HARMONY BLEND 5TH LOT ON RIGHT

SUBDIVISION EASTON Acres BLOCK / SECTION LOT 5 LOT AREA 0.94 ACRE SITE CLASS. PS DESIGN FLOW 3 L.T.A.R. EXISTING

Septic Tank: 1000 Gallons; STB 1012 Date 5-10-99

Pump Tank: Gallons; PT Date

Pump Make: Model Serial No.

Nitrification Field: No Fields 1 Square Feet 1080 Linear Feet 360

No Lines FOUR Trench Width 36" Max Trench Bottom Depth 36" Gravel Depth 12"

☐ New System ☐ Repair System Type: I, II, III, IV, V, VI

System Description: CONV - GRAVITY

Repair System Description: 25% REDUCTION, Pump

Maintenance Agreement Required: ☐ Yes ☒ No

☐ House/Mod. Home No. Bedrooms 3

☒ Mobile Home No. Bathrooms 2

☐ Business No. Employees

☐ Other


☐ Slab ☒ Crawl Space ☐ Basement w/plumbing ☐ Basement wo/plumbing

Water Supply: ☒ Individual ☐ Public ☐ Community WELL


Comments:/Conditions:

Comments:/Conditions: APPROVED FOR THREE BEDROOMS ONLY

INITIAL SITE SKETCH

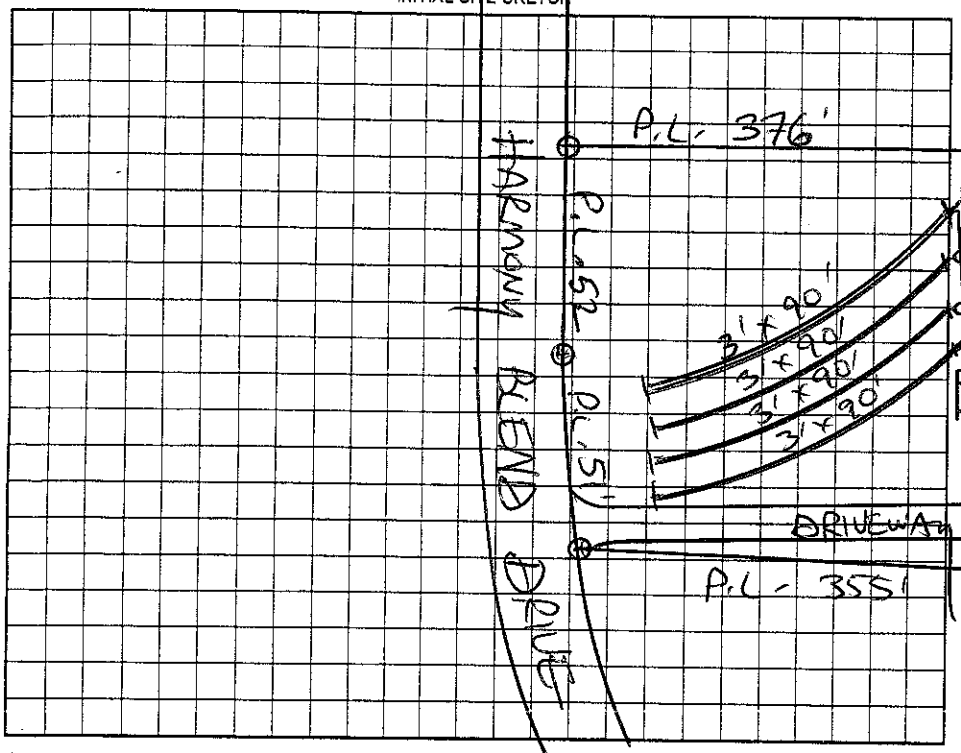

AS BUILT SKETCH

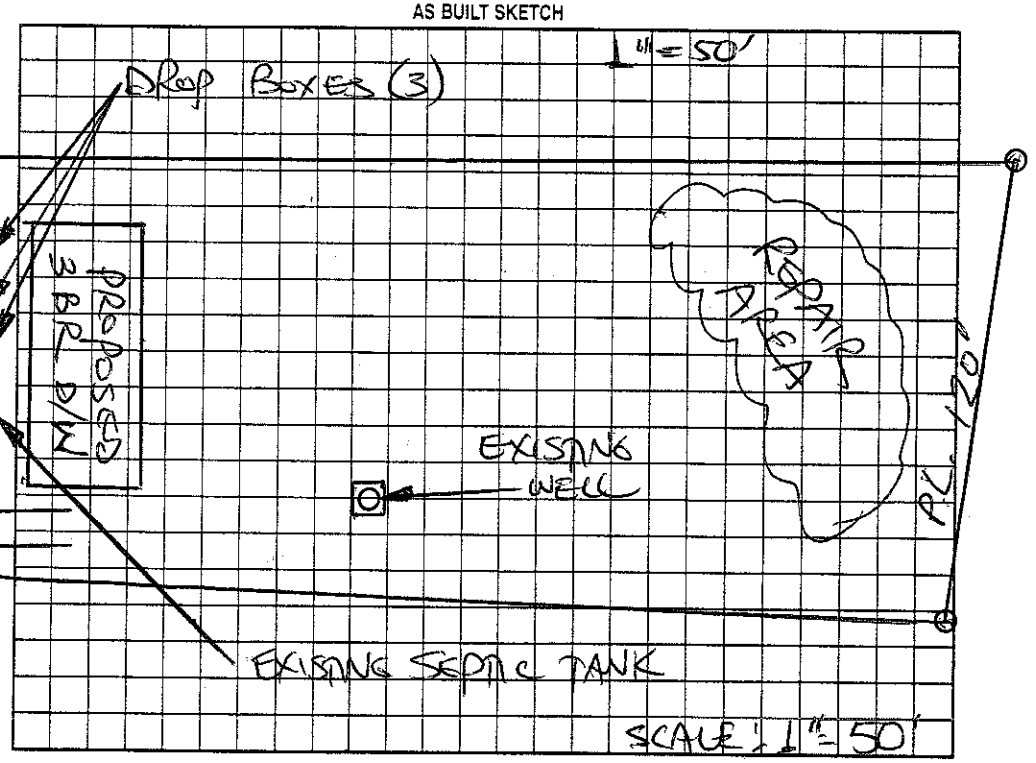

Permit can be suspended or revoked if any false information is supplied toward securing the permit/any unauthorized changes are made to the site/any unauthorized changes are made in the installation of the system. Improvement Permit with plat valid without expiration. Improvement Permit with site plan valid for sixty months. Authorization to Construct is valid for a period equal to that of Improvement Permit – not to exceed sixty months.

Signed: date Installed by:

Improvement Permit by: date Operation Permit by: date

Authorization to Construct by: date Existing System Inspection by: STEVE HEDRICK date 8-12-05

HEALTH DEPT. COPY: WHITE OWNER COPY (FINAL): YELLOW OWNER COPY (INITIAL): PINK