IREDELL COUNTY HEALTH DEPARTMENT

STATESVILLE 704-878-5305 MOORESVILLE 704-664-5281

IMPROVEMENT PERMIT / AUTHORIZATION TO CONSTRUCT / OPERATION PERMIT / EXISTING SYSTEM INSPECTION

PERMIT# 086180 PIN# 4778 17 7298 DATE 11-17-99

OWNER OR CONTRACTOR EDDIE GAITHER PHONE: Business 546-2231 Home 546-3194

ADDRESS 604 CRANFILL ROAD, HARMONY, NC 28634

LOCATION US 21 NORTH, TR CHIEF THOMAS RD, TR HARMONY BLEND, LEFT ON LEFT AT CURVE TO RIGHT

SUBDIVISION EASTON ACRES BLOCK / SECTION ____ LOT 32 LOT AREA 0.82 ACRE SITE CLASS PS DESIGN FLOW 360 L.T.A.R. 0.30 GAD/FT2

Septic Tank: 1000 Gallons; STB 1012 Date 10-18-99

Pump Tank: ____ Gallons; PT ____ Date ____

Pump Make: ____ Model ____ Serial No. ____

Nitrification Field: No Fields 1 Square Feet Eq. 1200 Linear Feet 300

No Lines FIVE Trench Width ____ Max Trench Bottom Depth ____

☑ New System ☐ Repair System Type: I. II. (III) IV. V. VI

System Description: 25% REDUCTION GRAVITY

Repair System Description: 25% REDUCTION PUMP

Maintenance Agreement Required: ☐ Yes ☑ No

Level Depth SAND 6" ☐ Slab ☑ Crawl Space ☐ Basement w/plumbing ☐ Basement wo/plumbing

☐ House/Mod. Home No Bedrooms 3

☑ Mobile Home No. Bathrooms 2

☐ Business No. Employees ____


☐ Other ____

Water Supply: ☑ Individual ☐ Public ☐ Community WELL


Comments:/Conditions: ① INSTALL 25% REDUCTION SYSTEM USING FIFTY (50) CHAMBERS OR THIRTY (30) HDS SECTIONS ② KEEP SYSTEM MINIMUM 100 FEET FROM WELL.

Comments /Conditions: SEPTIC TANK W/ RISERS INSTALLED USING "POLYLOK" FILTER

INITIAL SITE SKETCH

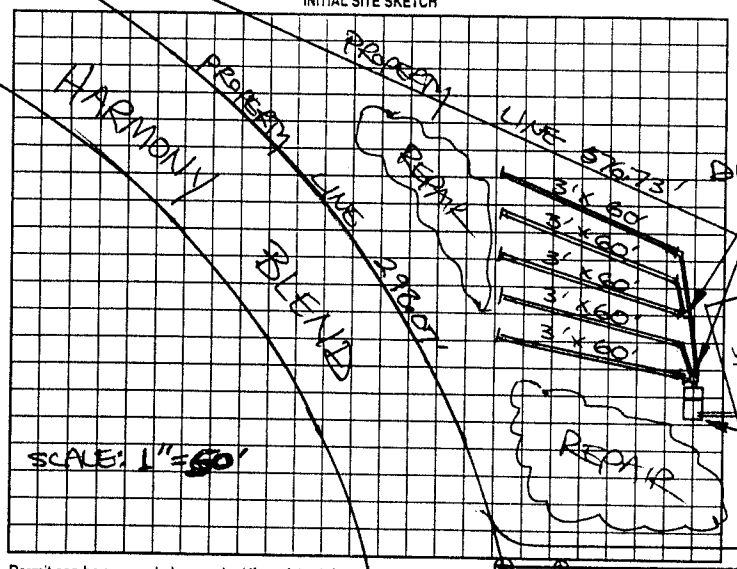

AS BUILT SKETCH

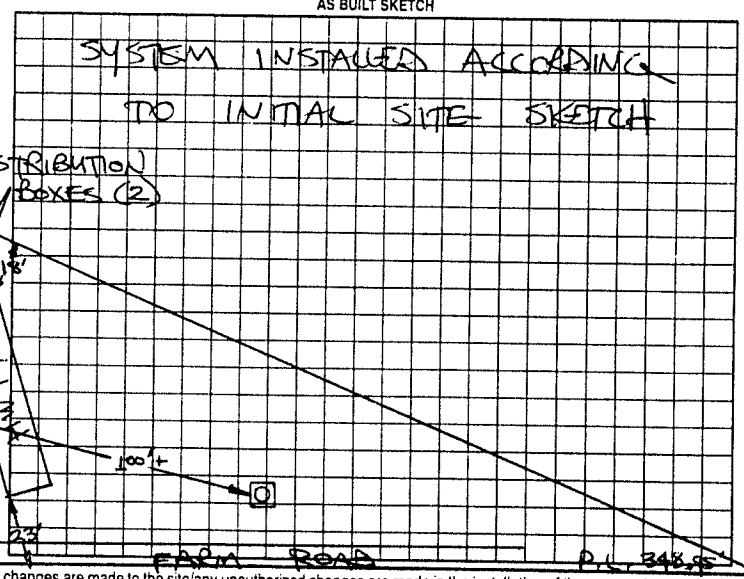

Permit can be suspended or revoked if any false information is supplied towards securing the permit/any unauthorized changes are made to the site/any unauthorized changes are made in the installation of the system. Improvement Permit with plat valid without expiration. Improvement Permit with site plan valid for sixty months. Authorization to Construct is valid for a period equal to that of Improvement Permit – not to exceed sixty months.

Signed: Eddie Gaither date 11-17-99

Improvement Permit by: STEVE HEDRICK date 11-17-99

Authorization to Construct by: STEVE HEDRICK date 11-17-99

Installed by: A-1 BACKHOE

Operation Permit by: STEVE HEDRICK date 2-9-00

Existing System Inspection by: ____ date ____

HEALTH DEPT. COPY WHITE OWNER COPY (FINAL) YELLOW OWNER COPY (INITIAL) PINK