IREDELL COUNTY HEALTH DEPARTMENT

STATESVILLE 704-878-5305 MOORESVILLE 704-664-5281

IMPROVEMENT PERMIT / AUTHORIZATION TO CONSTRUCT / OPERATION PERMIT / EXISTING SYSTEM INSPECTION

PERMIT# 077988 PIN# 4778 07 5063 (PT) DATE 12-14-98

OWNER OR CONTRACTOR AMERICAN LAND PHONE: Business 878-9595 Home

ADDRESS 1481 GARNER BAGNAL BLVD, STATESVILLE NC 28677

LOCATION US 21 NORTH, TR CHIEF THOMAS, TR HARMONY BLEND, 2ND LOT ON RIGHT

SUBDIVISION EASTON ACRES BLOCK / SECTION LOT 2 LOT AREA 0.86 ACRE SITE CLASS PS DESIGN FLOW 360 L.T.A.R 0.25 GPD/FT²

Septic Tank: 1000 Gallons: STB 794 Date 11-4-98
Pump Tank: Gallons: PT Date
Pump Make: Model: Serial No:
Nitrification Field: No. Fields 1 Square Feet Eq.Fo 1440 Linear Feet 240
No. Lines SIX Trench Width 24" Max. Trench Bottom Depth 36" Depth SAND 6'

New System / Repair System Type I II III IV V
System Description PPBPS, GRAVITY
Repair System Description PPBPS, LOW PRESSURE
Maintenance Agreement Required Yes / No


House/Mod. Home: No. Bedrooms 3
Mobile Home: No. Bathrooms 2
Business: No. Employees
Other:

Water Supply: Individual / Public / Community
WELL

Comments/Conditions: ① KEEP SYSTEM MINIMUM 100 FEET FROM WELLS (.1956)(6)(9) ② INSTALL SUBSURFACE INTERCEPT DRAINAGE DITCH BEGINNING 48 INCHES DEEP ③ INSTALL 54 PPBPS PANELS IN SIX EQUAL LINES, (AS FLAGGED)

Easement / Encroachment

INITIAL SITE SKETCH

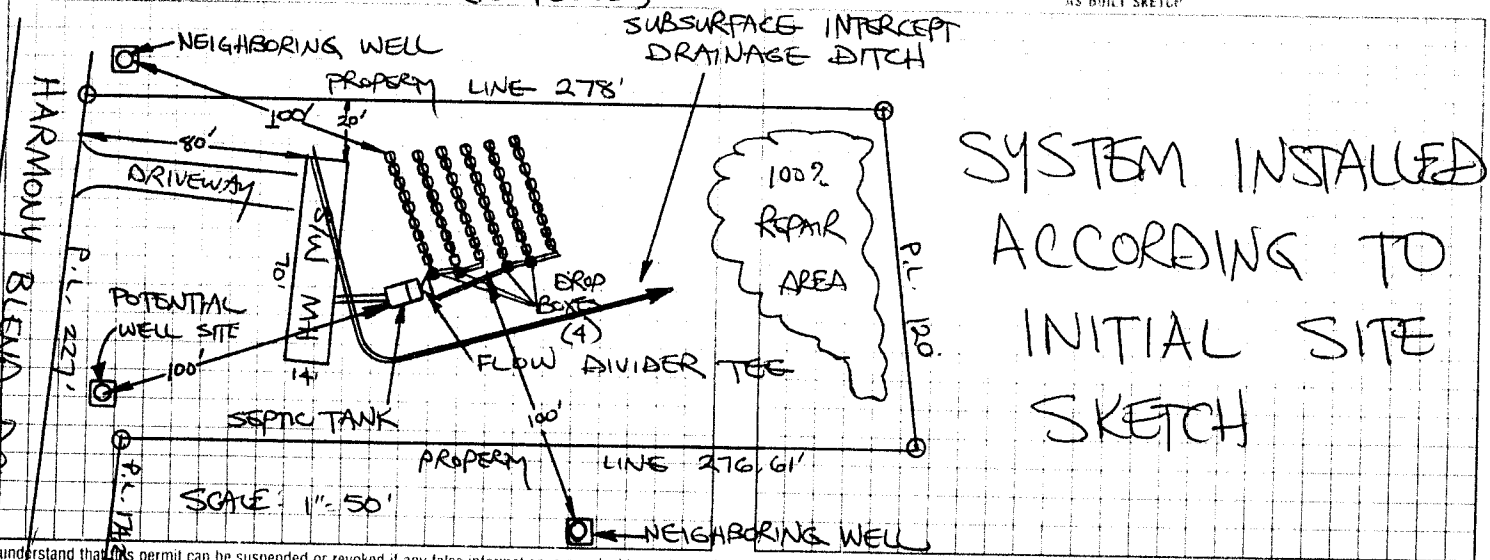

AS BUILT SKETCH

SYSTEM INSTALLED ACCORDING TO INITIAL SITE SKETCH

I understand that this permit can be suspended or revoked if any false information is supplied toward securing the permit/any unauthorized changes are made to the site/any unauthorized changes are made in the installation of the system. Improvement Permit with plat valid without expiration. Improvement Permit with site plan valid for sixty months. Authorization to Construct is valid for a period equal to that of Improvement Permit – not to exceed sixty months.

Signed: Claudette Ballard date 12-17-98

Improvement Permit by: STEVE HEDRICK date 12-14-98

Authorization to Construct by: STEVE HEDRICK date 12-14-98

Installed by: JAMES HUMBER

Operation Permit by: STEVE HEDRICK date 1-14-99

Existing System Inspection by: date

HEALTH DEPT. COPY: WHITE INSPECTION COPY (FINAL) GREEN OWNER COPY (FINAL) YELLOW INSPECTION COPY (INITIAL) PINK OWNER COPY (INITIAL) GOLD