IREDELL COUNTY HEALTH DEPARTMENT

STATESVILLE 704-878-5305 MOORESVILLE 704-664-5281

IMPROVEMENT PERMIT / AUTHORIZATION TO CONSTRUCT / OPERATION PERMIT / EXISTING SYSTEM INSPECTION

PERMIT# 103400 PIN# 4778-17-8885 DATE 12-3-01

OWNER OR CONTRACTOR AMERICAN LAND CORPORATION PHONE: Business 704-965-8963 Home

ADDRESS 3126 MILTON RD SUITE 227 CHARLOTTE NC 28215

LOCATION OLD MOCKSVILLE NORTH, (L) CHIEF THOMAS, (C) HARMONY BLEND, 2ND LOT ON RT

SUBDIVISION EASTERN ACRES BLOCK / SECTION LOT 2 LOT AREA .76 SITE CLASS. PS DESIGN FLOW 360 L.T.A.R. 0.25

Septic Tank: 1000 Gallons; STB 794 Date 11-4-98
Pump Tank: Gallons; PT Date
Pump Make: Model Serial No.
Nitrification Field: No Fields 1 Square Feet 60x140 Linear Feet 240'
No Lines 6 Trench Width 24" Max Trench Bottom Depth 36

☐ New System ☐ Repair System Type: I, II, (III), IV, V, VI
System Description: GRAVITY PANEL
Repair System Description: LP PANEL
Maintenance Agreement Required: ☐ Yes ☒ No

☐ House/Mod. Home No. Bedrooms 3
☒ Mobile Home No. Bathrooms 2
☐ Business No. Employees
☐ Other

Gravel Depth N/A ☐ Slab ☒ Crawl Space ☐ Basement w/plumbing ☐ Basement wo/plumbing


Water Supply: ☑ Individual ☐ Public ☐ Community WELL

Comments/Conditions:

Comments/Conditions (1) MAINTAIN SETBACKS

INITIAL SITE SKETCH

AS BUILT SKETCH "NOT TO SCALE"

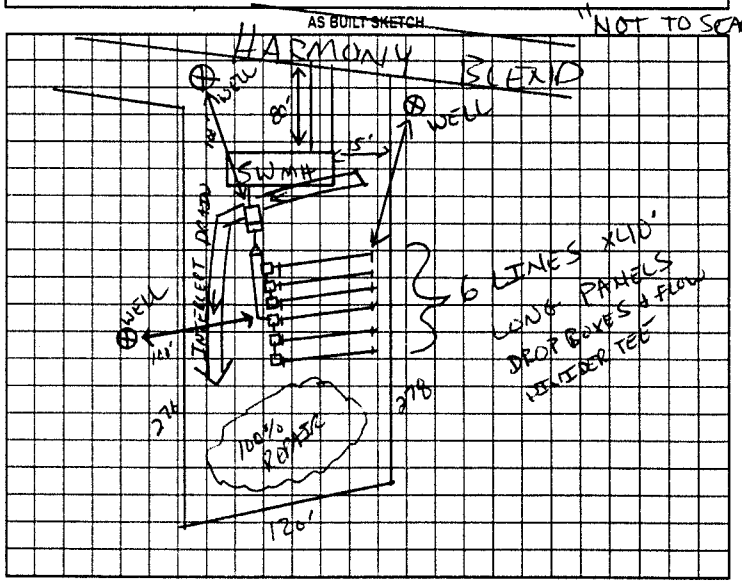

Permit can be suspended or revoked if any false information is supplied toward securing the permit/any unauthorized changes are made to the site/any unauthorized changes are made in the installation of the system. Improvement Permit with plat valid without expiration. Improvement Permit with site plan valid for sixty months. Authorization to Construct is valid for a period equal to that of Improvement Permit – not to exceed sixty months.

Signed: [signature] date 12/3/01 Installed by: JAMES HUDLER

Improvement Permit by: date Operation Permit by: date

Authorization to Construct by: date Existing System Inspection by: [signature] date 12-3-01

HEALTH DEPT. COPY WHITE OWNER COPY (FINAL) YELLOW OWNER COPY (INITIAL) PINK