IREDELL COUNTY HEALTH DEPARTMENT

STATESVILLE 704-878-5305 (LV) MOORESVILLE 704-664-5281

IMPROVEMENT PERMIT / AUTHORIZATION TO CONSTRUCT / OPERATION PERMIT / EXISTING SYSTEM INSPECTION

PERMIT# 110052 PIN# 4778-18-0365 DATE 1-6-03

OWNER OR CONTRACTOR TONY ROSEBORO PHONE: Business 704-878-3102 Home 704-546-7072

ADDRESS 425 CHIEF THOMAS ROAD, HARMONY, NC 28634

LOCATION US 21 NORTH, TR CHIEF THOMAS ROAD, 1 LOT ON RIGHT 1.2 MILES (2ND LOT PAST CHADWICK RD)

SUBDIVISION _____ BLOCK / SECTION _____ LOT _____ LOT AREA 2.5+ ACRES SITE CLASS. PS DESIGN FLOW 360 L.T.A.R. 0.35 GPD/FT2

Septic Tank: 1000 Gallons; STB 760 Date 10-25-02

Pump Tank: _____ Gallons; PT _____ Date _____

Pump Make: _____ Model _____ Serial No. _____

Nitrification Field: No Fields 1 Square Feet 1035 Linear Feet 345

No Lines FIVE Trench Width 36" Max Trench Bottom Depth 36" Gravel Depth 12"

☑ New System ☐ Repair System Type: I, II, III, IV, V, VI

System Description: CONVENTIONAL GRAVITY

Repair System Description: CONVENTIONAL, GRAVITY

Maintenance Agreement Required: ☐ Yes ☒ No

☐ House/Mod. Home No. Bedrooms 3

☑ Mobile Home No. Bathrooms 2

☐ Business No. Employees ____

☐ Other _____

☐ Slab ☑ Crawl Space ☐ Basement w/plumbing ☐ Basement wo/plumbing


Water Supply: ☑ Individual ☐ Public ☐ Community

WELL

Comments/Conditions: KEEP SYSTEM MINIMUM 100 FEET FROM WELL

Comments/Conditions: SEPTIC TANK WITH MARKER INSTALLED USING "ZABEL" FILTER

INITIAL SITE SKETCH

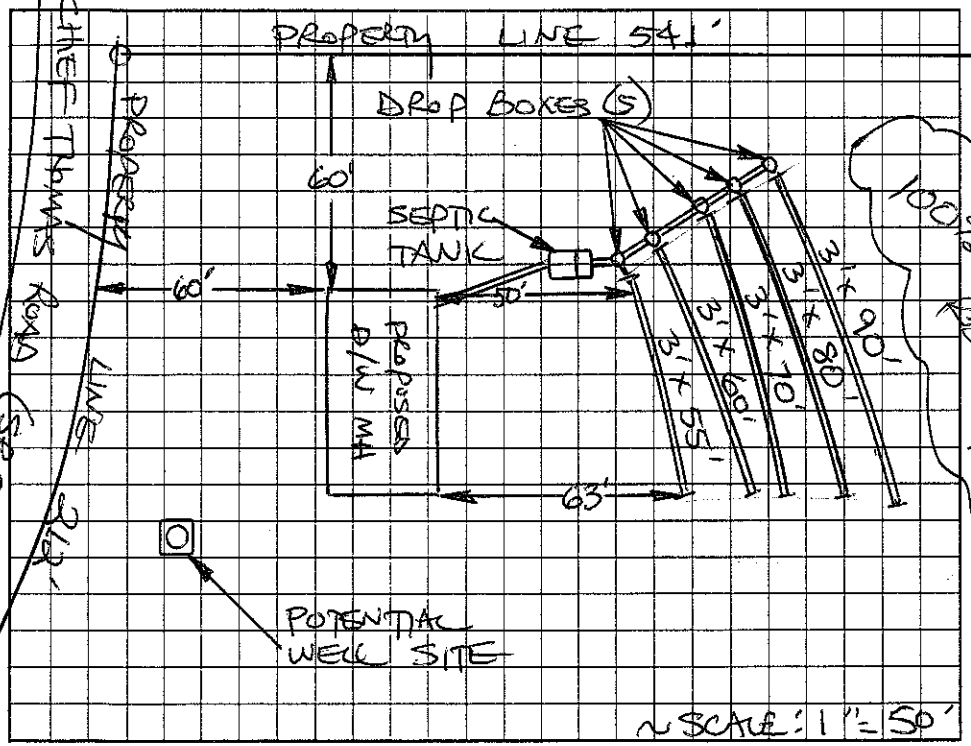

AS BUILT SKETCH

SYSTEM INSTALLED ACCORDING TO INITIAL SITE SKETCH

Permit can be suspended or revoked if any false information is supplied toward securing the permit/any unauthorized changes are made to the site/any unauthorized changes are made in the installation of the system. Improvement Permit with plat valid without expiration. Improvement Permit with site plan valid for sixty months. Authorization to Construct is valid for a period equal to that of Improvement Permit – not to exceed sixty months.

Signed: Tony L. Roseboro date 1-8-03

Improvement Permit by: STEVE HEDRICK date 1-6-03

Authorization to Construct by: STEVE HEDRICK date 1-6-03

Installed by: BRENT GALLIHER

Operation Permit by: STEVE HEDRICK date 3-27-03

Existing System Inspection by: _____ date _____

HEALTH DEPT. COPY: WHITE OWNER COPY (FINAL): YELLOW OWNER COPY (INITIAL): PINK