Jesse Ballard

IREDELL COUNTY HEALTH DEPARTMENT

STATESVILLE 704-878-5305 (O) (M) MOORESVILLE 704-664-5281

IMPROVEMENT PERMIT / AUTHORIZATION TO CONSTRUCT / OPERATION PERMIT / EXISTING SYSTEM INSPECTION

PERMIT # 156729 PIN # 4778203511 4778202530 DATE 6-15-09

OWNER or APPLICANT America's Home Place PHONE: Business Home: 704-872-4400

OWNER or APPLICANT ADDRESS 1010 Graveland Drive Statesville NC 28677

LOCATION / DIRECTIONS 21 N TR Chief Thomas beside #971 Chief Thomas

SUBDIVISION BLOCK / SECTION LOT # LOT AREA 1.159 DESIGN FLOW 360 L.T.A.R. .25 (.2 Repair)

Septic Tank 1000 Gallons: STB 1012 Date 4-8-08

Pump Tank Gallons: PT Date

Pump Make Model Serial #

Nitrification Field No Fields No Lines Linear Feet 360

Trench Width 36" Max. Trench Bottom Depth 36" Gravel Depth NR

☑ New System ☐ Repair ☐ Expansion System Type I II III IV V VI

System Description: 25% Grant

Repair System Description: 50% Lost

Maintenance Agreement Required ☐ YES ☐ NO

☑ GRAVITY ☐ PRESSURE

☑ Residence No. Bedrooms 3

☐ Business No. Persons

☐ Other No. Employees

☐ Slab ☐ Crawl Space


☐ Basement w/plumbing ☑ Basement w/o plumbing

Water Supply: ☐ Private ☑ Public ☐ Community


Comments / Conditions

Protect or Locate Maintain all setbacks must not drop pipes

INITIAL SITE SKETCH

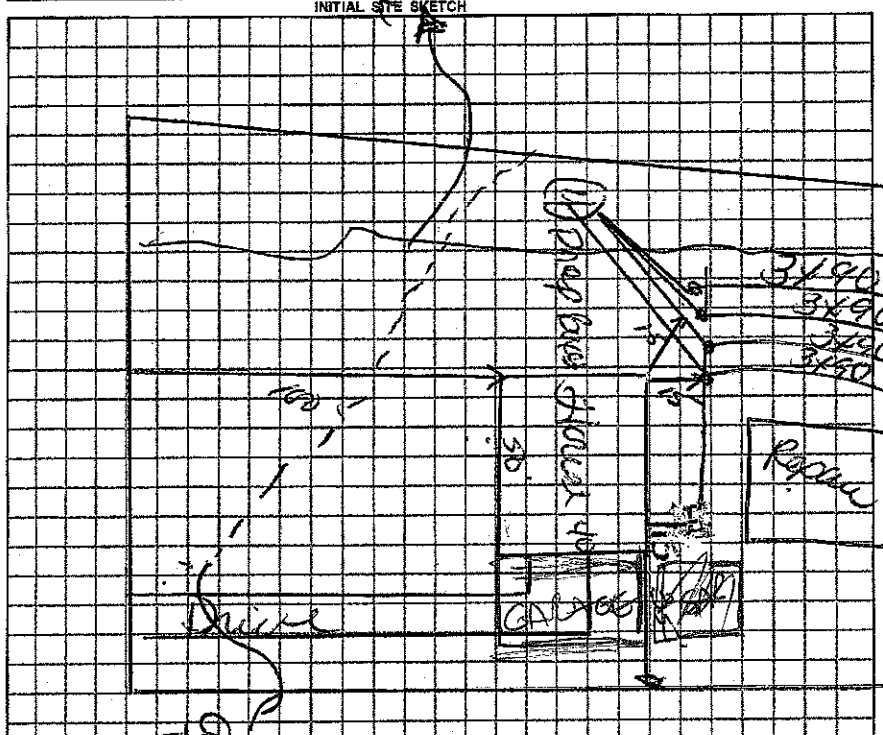

AS BUILT SKETCH

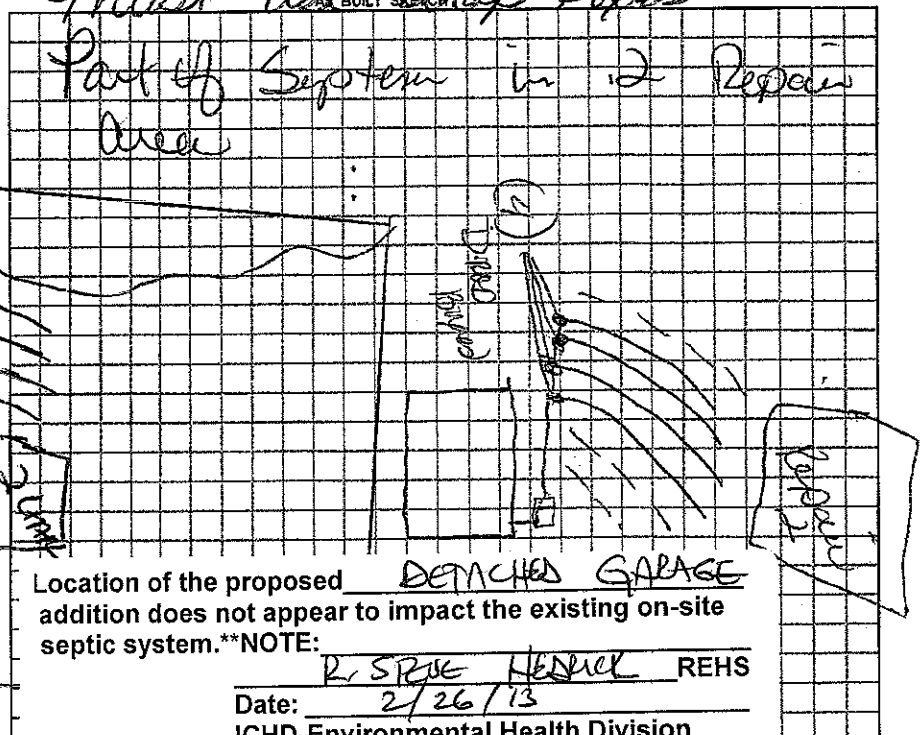

Location of the proposed DETACHED GARAGE addition does not appear to impact the existing on-site septic system.**NOTE:

R. STEVE HENDRICK REHS

Date: 2/26/13

ICHD-Environmental Health Division

Permit can be suspended or revoked if any false information is supplied toward securing the permit / any unauthorized changes are made to the site / any unauthorized changes are made in the installation of the system.

☐ IMPROVEMENT PERMIT w / plat valid without expiration. ☐ IMPROVEMENT PERMIT w / site plan valid for 60 mos. ☑ AUTHORIZATION TO CONSTRUCT valid for period equal to IMPROVEMENT PERMIT-not to exceed 60 mo.

Owner / Applicant Signature: [signature] Date 6-19-09

Improvement Permit by: [signature] Date 6-15-09

Authorization to Construct by: [signature] Date 6-15-09

Installed by: Gunter Grading

Operation Permit by: [signature] Date: 7-15-09

Existing System Inspected by: Date:

YOU SHOULD CONTACT A LOCATOR SERVICE PRIOR TO ANY EXCAVATION.

WHITE COPY Environmental Health YELLOW COPY (Final) Owner / Applicant PINK COPY (Initial) Owner / Applicant