1:30

IREDELL COUNTY HEALTH DEPARTMENT

STATESVILLE 704-878-5305 (@) MOORESVILLE 704-664-5281 A

IMPROVEMENT PERMIT / AUTHORIZATION TO CONSTRUCT / OPERATION PERMIT / EXISTING SYSTEM INSPECTION

PERMIT # 160766 PIN # 4778-21-1655 DATE 1 June 10

OWNER or APPLICANT Benny Wilhelm / Emily Lambert PHONE: Business (704) 873-7475 Home: (704) 871-8551

OWNER or APPLICANT ADDRESS 866 Chief Thomas Rd. Statesville.

LOCATION / DIRECTIONS Old Mucksville Rd. TL Chief Thomas Rd. 5th House on Left.

SUBDIVISION — BLOCK / SECTION — LOT # — LOT AREA 4.98ac. DESIGN FLOW 120g/d L.T.A.R. 0.2g/FT/d

Septic Tank Exist. Gallons: STB — Date —
Pump Tank — Gallons: P T — Date —
Pump Make — Model — Serial # —
Nitrification Field No Fields 1 No Lines 1 Linear Feet 150
Trench Width 36" Max. Trench Bottom Depth 36" Gravel Depth N/A

☑ New System ☐ Repair ☑ Expansion System Type I II (III) IV V VI
System Description: 25% Reduction
Repair System Description: 25% Reduction
Maintenance Agreement Required ☐ YES ☑ NO
☑ GRAVITY ☐ PRESSURE

☑ Residence No. Bedrooms 3
☐ Business No. Persons —
☐ Other No. Employees —
☐ Slab ☑ Crawl Space
☐ Basement w/plumbing ☐ Basement w/o plumbing

Water Supply
☑ Private — Exist.
☐ Public
☐ Community


Comments / Conditions: Old House to be demolished / Keep 100' From well / Follow contour / Keep 100'+ From well.

Comments / Conditions: Addition of 1 bedroom.


459'
393'

INITIAL SITE SKETCH

1" = 60'

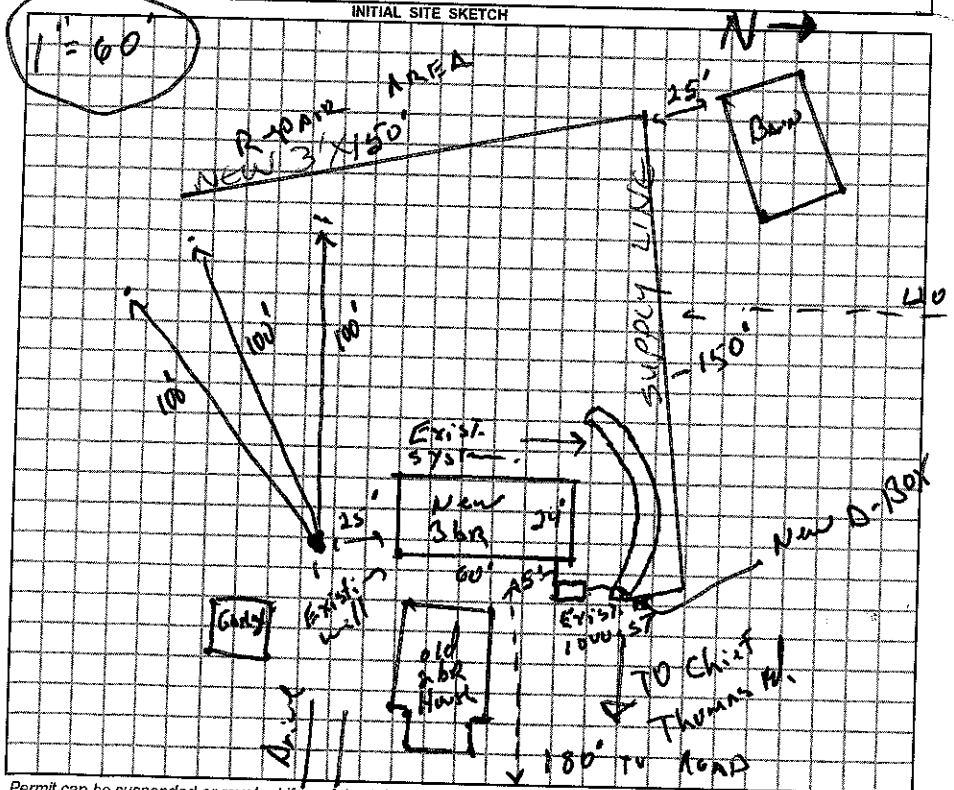

AS BUILT SKETCH

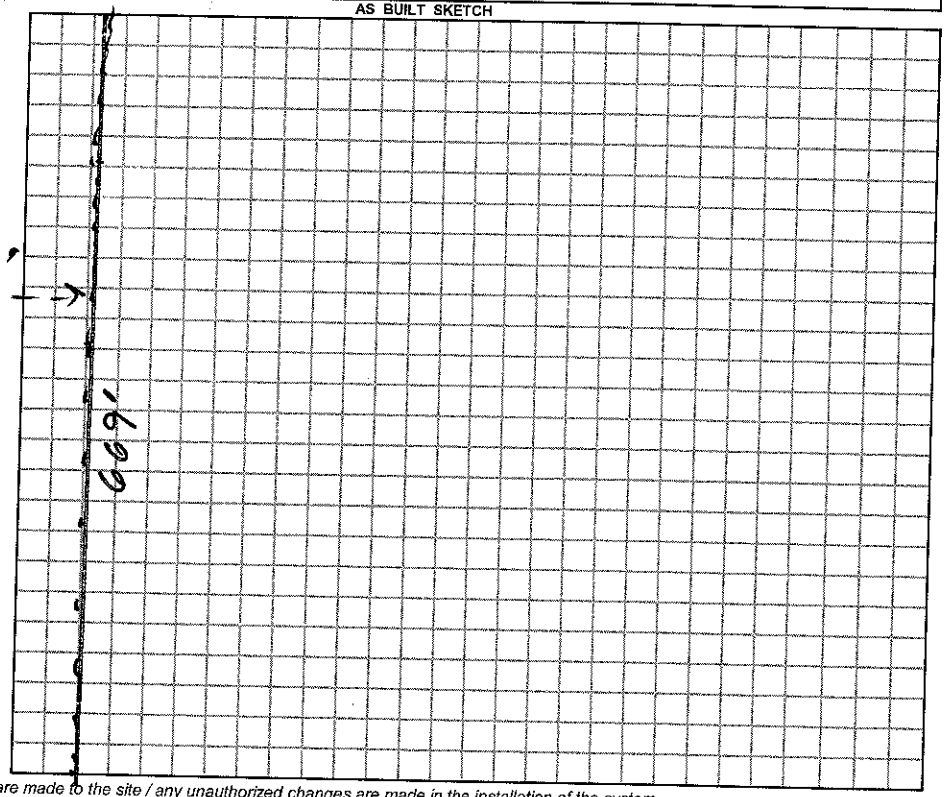

Permit can be suspended or revoked if any false information is supplied toward securing the permit / any unauthorized changes are made to the site / any unauthorized changes are made in the installation of the system.

☐ IMPROVEMENT PERMIT w / plat valid without expiration ☑ IMPROVEMENT PERMIT w / site plan valid for 60 mos.

☑ AUTHORIZATION TO CONSTRUCT valid for period equal to IMPROVEMENT PERMIT-not to exceed 60 mo.

Owner / Applicant Signature: [signature] Date 6/2/10

Improvement Permit by: [signature], R.S. Date 2 June 10

Authorization to Construct by: [signature], R.S. Date 2 June 10

YOU SHOULD CONTACT A LOCATOR SERVICE PRIOR TO ANY EXCAVATION.

Installed by: Tucker Grading

Operation Permit by: [signature] Date: 4-21-11

Existing System Inspected by: — Date: —

WHITE COPY Environmental Health YELLOW COPY (Final) Owner / Applicant PINK COPY (Initial) Owner / Applicant