ICHD - ENVIRONMENTAL HEALTH DIVISION

Statesville Office (704) 878-5305 Mooresville Office (704) 660-3625 (BB)

PERMIT # 308225

SEPTIC: IMPROVEMENT PERMIT / AUTHORIZATION TO CONSTRUCT / OPERATION PERMIT / EXISTING SYSTEM

PIN # 4778480178

APPLICANT/OWNER: Freedom Homes

APPLICANT ADDRESS: 1124 Charlotte Hwy, Troutman

SITE ADDRESS: 549 Chief Thomas Rd, Harmony 28634

PHONE: 704-881-7326

ALT. PHONE —

SITE DIRECTIONS: 21N → R Chief Thomas → on L

SAP CONTROLLED: ☐ YES ☒ NO

SUBDIVISION: —

SECTION: — LOT # — LOT AREA: 3.02 ac

DESIGN FLOW: 480 gpd L.T.A.R.: 3

Septic Tank 1000 (gal) STB 760 Date 7/17/2020

Pump Tank — (gal) PT — Date —

Pump Make — Model — Serial # —

Nitrification Fields 1 # Lines 5 Linear Ft 400'

Trench Width 36" Trench Bottom Depth ~~(Low Side)~~ 36" max Gravel Depth —

☒ New System ☐ Repair ☐ Expansion System Type: I II (III) IV V VI

System Description: 25% reduction

Repair System Description: 25% reduction

Maintenance Agreement Required: ☐ YES ☒ NO

☒ GRAVITY ☐ PRESSURE

☒ Residence ☐ Business ☐ Other ☐ Slab ☐ Basement w/ plumbing

No. Bedrooms 4 No. Persons 8 No. Employees —


☒ Crawl Space

☐ Basement w/o plumbing

Water Supply: ☐ Private ☒ Public ☐ Community


Comments / Conditions: Install on contour + utilize serial distribution. Do not exceed max depth of 36". Maintain minimum 5' from house (no fondation drains allowed)

INITIAL SITE SKETCH

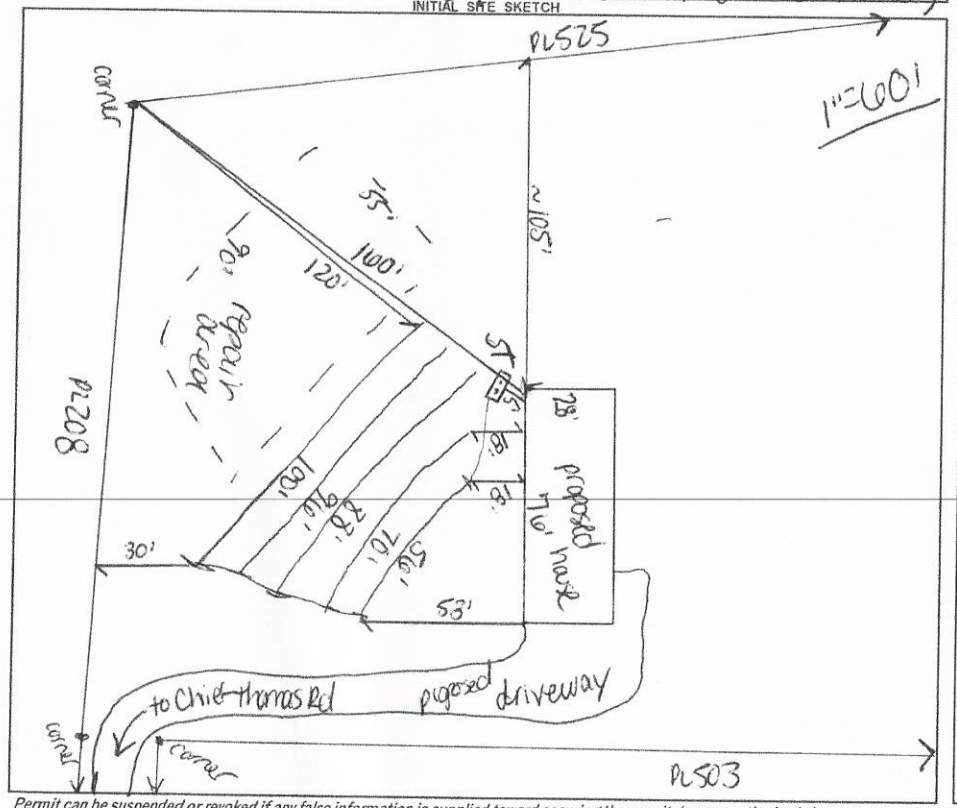

AS BUILT SKETCH

FOR SEPTIC FINAL INSPECTION CALL: 704-664-3703 between 8am-9am the day the inspection is needed. Be sure to speak with an inspector to confirm your time.

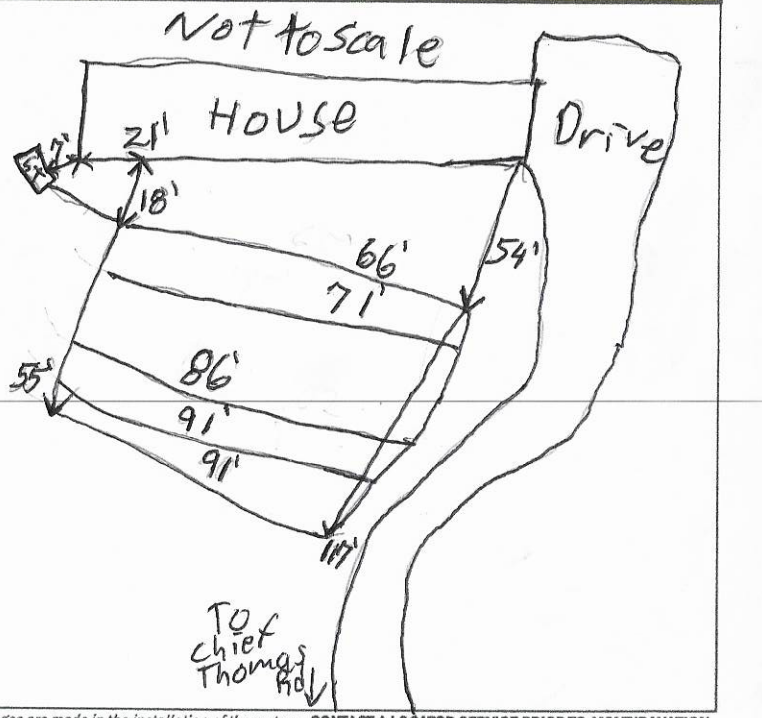

Permit can be suspended or revoked if any false information is supplied toward securing the permit / any unauthorized changes are made to the site / any unauthorized changes are made in the installation of the system. CONTACT A LOCATOR SERVICE PRIOR TO ANY EXCAVATION

☐ **IMPROVEMENT PERMIT** *with plat valid without expiration.* ☒ **IMPROVEMENT PERMIT** *with site plan valid for 60 mos.* ☒ **AUTHORIZATION TO CONSTRUCT** *valid for period equal to IMPROVEMENT PERMIT--not to exceed 60 mo.*

Owner / Applicant Signature: Kimberly Sumpter Date: 7-7-2020 Installed by: Abee's Grading

IMPROVEMENT PERMIT by: Carla C. Nicks Date: 6-30-20 OPERATION PERMIT by: Patrick J Pigott III Date: 9/14/2020

AUTHORIZATION TO CONSTRUCT by: Carla C. Nicks Date: 6-30-20 Existing System Inspected by: Date:

FOR SEPTIC FINAL INSPECTION: CALL 704-664-3703 between 8am-9am the day the inspection is needed.

DEPARTMENT OF HEALTH AND HUMAN SERVICES
DIVISION OF PUBLIC HEALTH, ENVIRONMENTAL HEALTH SECTION
ON-SITE WATER PROTECTION BRANCH

Sheet 1 of 2
PROPERTY ID #: 4782180178
COUNTY: Iredell

SOIL/SITE EVALUATION
for ON-SITE WASTEWATER SYSTEM
(Complete all fields in full)

OWNER: Freedom Homes
ADDRESS: 1124 Charlotte Hwy
PROPOSED FACILITY: 4BR
LOCATION OF SITE: 549 Chief Thomas Rd
APPLICATION DATE: 6-18-20
DATE EVALUATED: 6-30-20
PROPOSED DESIGN FLOW (.1949): 480gpd
PROPERTY SIZE:
PROPERTY RECORDED:

WATER SUPPLY: ☐ Private ☑ Public ☐ Well ☐ Spring ☐ Other
EVALUATION METHOD: ☐ Auger Boring ☑ Pit ☐ Cut
TYPE OF WASTEWATER: ☑ Sewage ☐ Industrial Process ☐ Mixed

PROFILE #	.1940 LANDSCAPE POSITION/ SLOPE %	HORIZON DEPTH (IN.)	SOIL MORPHOLOGY (.1941) .1941 STRUCTURE/ TEXTURE	SOIL MORPHOLOGY (.1941) .1941 CONSISTENCE/ MINERALOGY	OTHER PROFILE FACTORS .1942 SOIL WETNESS/ COLOR	.1943 SOIL DEPTH	.1956 SAPRO CLASS	.1944 RESTR HORIZ	PROFILE CLASS & LTAR
1	L 0%	0-28	SBK C	Fr SS SP SBP	few sap inc thru out CL	48"	-	-	PS .3
		28-48	SBK CL	" "					
2	L 0%	0-30	SBK C	Fr SS SP SBP	→ slightly compacted 0-12" 44-52 sap inc	52"	-	-	PS .3
		30-52	SBK CL	" "					
3	L 0%	0-28	SBK C	Fr SS SP SBP	sap inc in CL	48"	-	-	PS .3
		28-48	SBK CL	" "					
4	L 0%	0-32	SBK C	Fr SS SP SBP	-	49"	-	-	PS .3
		32-49	SBK CL	" "					

DESCRIPTION	INITIAL SYSTEM	REPAIR SYSTEM
Available Space (.1945)	400'	400'
System Type(s)	2SC	2SC
Site LTAR	.3	.3

OTHER FACTORS (.1946): N/A
SITE CLASSIFICATION (.1948): PS
EVALUATED BY: C. NICKS
OTHER(S) PRESENT:

COMMENTS:

SOIL/SITE EVALUATION

(Continuation Sheet-Complete all field in full)

DEPARTMENT OF HEALTH AND HUMAN SERVICES
DIVISION OF PUBLIC HEALTH
ENVIRONMENTAL HEALTH SECTION
ON-SITE WATER PROTECTION BRANCH

PROPERTY ID #: 477847017
DATE OF EVALUATION: 4-30-20
COUNTY: Iredell

PROFILE #	.1940 LANDSCAPE POSITION/ SLOPE %	HORIZON DEPTH (IN.)	SOIL MORPHOLOGY (.1941) .1941 STRUCTURE/ TEXTURE	SOIL MORPHOLOGY (.1941) .1941 CONSISTENCE/ MINERALOGY	OTHER PROFILE FACTORS .1942 SOIL WETNESS/ COLOR	.1943 SOIL DEPTH	.1956 SAPRO CLASS	.1944 RESTR HORIZ	PROFILE CLASS & LTAR
5	C 6%	B-37	SBK C	FR SS SP SSP	–	49"	–	–	PS .3
		37-49	SBK CL	" "					

COMMENTS:

LEGEND

use the following standard abbreviations

LANDSCAPE POSITION	GROUP	SOIL TEXTURE	CONVENTIONAL .1955 LTAR*	LPP .1957 LTAR*	MINERALOGY/ CONSISTENCE	STRUCTURE
CC (Concave Slope) CV (Convex Slope) D (Drainage Way) DS (Debris Slump) FP (Flood Plain) FS (Foot Slope) H (Head Slope) L (Linear Slope) N (Nose Slope) R (Ridge) S (Shoulder Slope) T (Terrace)	I	S (Sand) LS (Loamy Sand)	1.2 - 0.8	0.6 - 0.4	SEXP (Slightly Expansive) EXP (Expansive)	G (Single Grain) M (Massive) CR (Crumb) GR (Granular) SBK (Subangular Blocky) ABK (Angular Blocky) PL (Platy) PR (Prismatic)
	II	SL (Sandy Loam) L (Loam)	0.8 - 0.6	0.4 - 0.3		
	III	Si (Silt) SiCL (Silty Clay Loam) CL (Clay Loam) SCL (Sandy Clay Loam) SiL (Silt Loam)	0.6 - 0.3	0.3 - 0.15		
	IV	SC (Sandy Clay) SiC (Silty Clay) C (Clay) O (Organic)	0.4 - 0.1	0.2 - 0.05		
			None	None		

MOIST	WET
VFR (Very Friable)	NS (Non-sticky)
FR (Friable)	SS (Slightly Sticky)
FI (Firm)	S (Sticky)
VFI (Very Firm v. Very Sticky)	VS (Very Sticky)
EFI (Extremely Firm)	NP (Non-plastic)
	SP (Slightly Plastic)
	P (Plastic)
	VP (Very Plastic)

*Adjust LTAR due to depth, consistence, structure, soil wetness, landscape, position, wastewater flow and quality.


NOTES

HORIZON DEPTH	In inches below natural soil surface
DEPTH OF FILL	In inches from land surface
RESTRICTIVE HORIZON	Thickness and depth from land surface
SAPROLITE	S(suitable) or U(unsuitable)
SOIL WETNESS	Inches from land surface to free water or inches from land surface to soil colors with chroma 2 or less - record Munsell color chip designation
CLASSIFICATION	S (Suitable), PS (Provisionally Suitable), or U (Unsuitable)

Evaluation of saprolite shall be by pits.

Long-term Acceptance Rate (LTAR): gal/day/ft^2

Show profile locations and other site features (dimensions, reference or benchmark, and North).

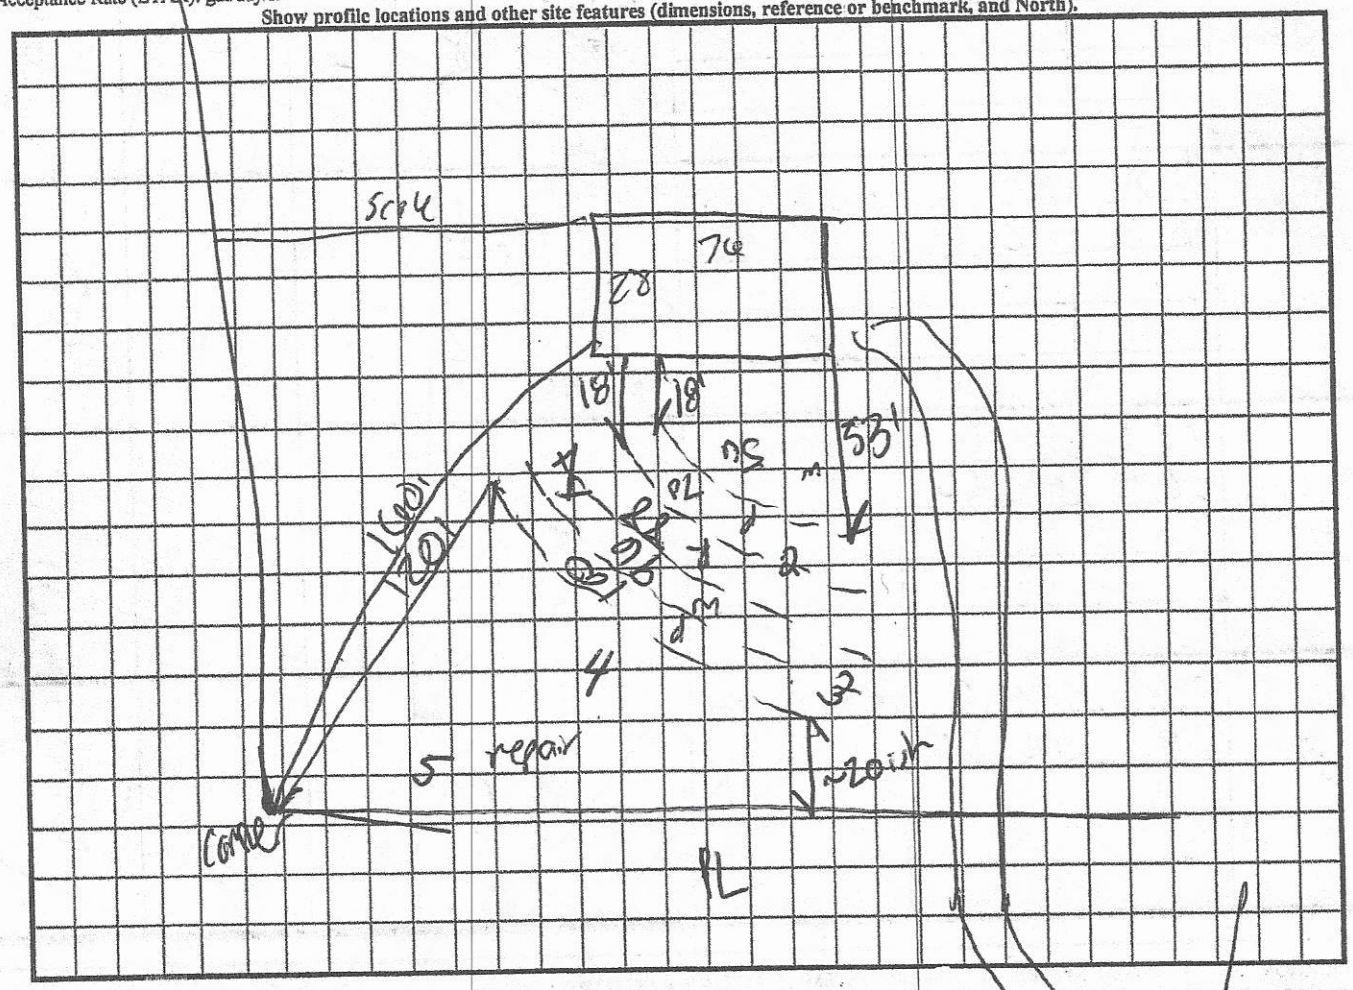

5) 0-37 C
37-49 CL

RECEIVED JUN 18 2020

AP-308225
$500.00

IREDELL COUNTY DEPARTMENT of ENVIRONMENTAL HEALTH

APPLICATION FORM

Application For:

( ) Septic Improvement Permit (X) New Well Permit ( ) Authorization to Construct ( ) Well Repair Permit ( ) Existing System Inspection ( ) Well Abandonment ( ) Septic System Repair

THE ABOVE PERMIT DOCUMENTS WILL BECOME INVALID IF INFORMATION PROVIDED ON THIS APPLICATION IS FALSIFIED OR CHANGED, OR IF THE SITE IS ALTERED. THE IMPROVEMENT PERMIT IS VALID FOR EITHER 60 MONTHS OR WITHOUT EXPIRATION DEPENDING UPON DOCUMENTATION SUBMITTED. APPLICATION WITH SITE PLAN 60 MONTHS, APPLICATION WITH COMPLETE, SCALED PLAT WITHOUT EXPIRATION. SEE 15A NCAC 18A .1937(f) FOR DETAILS.

Page 2: *Site Plan Worksheet* form MUST accompany this application

The following optional attachments may also be submitted: ( ) Survey Plat, scaled no more than 1 inch = 60 feet

Place an (X) beside whichever is submitted if applicable ( ) Custom Site Plan, scaled no more than 1 inch = 60 feet

Applicant Information: (PRINT CLEARLY)

Applicant Name: Freedom Homes / Kimberly Sneed Address: 1124 Charlotte Hwy Troutman NC Zip: 28166

Applicant Email: Kimsneed.Sneed04@gmail Phone: 704-881-2326 Alt. Phone: _____

Owner Name: Lisa Creason Address: 150 Durand LN Statesville, NC Zip: 28625

Owner Email: _____ Phone: 704-880-1884 Alt. Phone: _____

Property Information:

Street Address: 549 Cheif Thomas Rd Harmony NC. 28634

Subdivision Name: _____ Section/Phase: _____ Lot Number: _____

Driving Directions: I-40 East 77 toward Elkin Exit 54 @ Turnersburg Hwy, @ Chief Thomas Rd, 549 is on the Left 0.77 miles

Site Development Information: *(check or complete ALL that apply*

(X) New Single Family Residence
( ) New Multi-Family Residence
( ) Accessory Building
( ) Bedroom(s) Addition
( ) Repair to failing septic system ___ Tank ___ Drain lines Describe Problem: _____

Maximum Number of Bedrooms: 4
Maximum Number of Occupants: 2
( ) Swimming Pool
( ) Other Addition/Structure: _____

CHECK FOUNDATION TYPE

(X) Crawl Space Foundation
( ) Concrete Slab Foundation
( ) Basement with Plumbing
( ) Basement without Plumbing

Non-Residential Site Development:
Square Footage of Building: _____ Type of Business: _____
Max. Number of Employees: _____ Max. Number of Seats/Beds/Other: _____

Water Supply: ( ) Replacement Well – Reason: _____
( ) Multi-connection Well Number of Houses: _____ Number of Persons: _____
( ) New Well ( ) Existing Well ( ) Community Well ( ) City Water (X) Other Public Water

Desired Septic System Type: *(you may rank in order of preference)* Year existing system installed: _____
( ) No Preference ( ) Alternative (X) Conventional ( ) Innovative ( ) Modified Conventional ( ) Other: _____

Please answer the following to the best of your ability:

( ) Yes (X) No Does the site contain any jurisdictional wetlands?
( ) Yes (X) No Is any non-domestic sewage (i.e. industrial) to be generated?
( ) Yes (X) No Is the site subject to approval by any other public agency?

I have read this application and certify that the information provided herein is true, complete, and correct. Authorized county and state officials are granted right of entry to conduct necessary inspections to determine compliance with applicable laws and rules. I understand that I am solely responsible for the proper identification and labeling of all property lines and corners and making the site accessible so that a complete site evaluation can be performed.

Signature: Kimberly Sneed
Property owner or owner's legal representative signature (SIGNATURE REQUIRED)

6-5-2020
DATE


IREDELL COUNTY DEPARTMENT of ENVIRONMENTAL HEALTH

SITE PLAN WORKSHEET

SEE THE "SAMPLE SITE PLAN" BELOW. *INCOMPLETE SITE PLANS WILL BE RETURNED TO YOU FOR COMPLETION AND MAY RESULT IN A DELAY IN THE ISSUANCE OF YOUR SEPTIC SYSTEM OR WELL PERMIT!!!*

Place an (X) beside each item as you complete the site plan:

- (X) Property Line measurements are clearly identified
- (X) All proposed structures are indicated
- (X) Front and side setbacks from property line
- (X) Preferred driveway location
- (X) Preferred well location
- (X) Preferred septic system location
- ( ) North arrow, or other sufficient indicator of direction

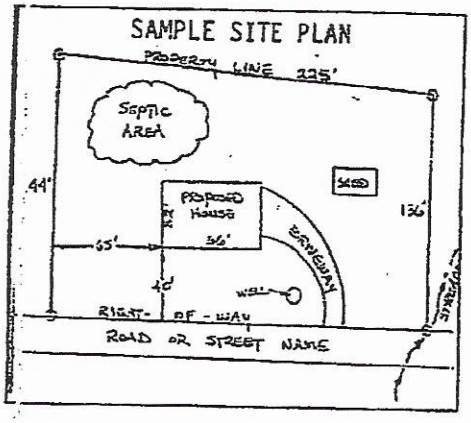

Circle N/A on the following if appropriate:

Location of septic systems and wells within 100' of your property (N/A)
Location of easements and rights of ways on your property (N/A)
Location of any designated wetlands on the property (N/A)

USE THIS SPACE TO DRAW YOUR SITE PLAN

Show: proposed house or business footprint, wells, water lines, patios, pools and decks, and any other item that will occupy space on the site


See Attached

Signature: [signature]
Property owner or owner's legal representative signature (SIGNATURE REQUIRED)

6-5-2020
DATE

Creason
543 Chief Thomas Rd.
Harmony, NC

PLOT PLAN
N.T.S.

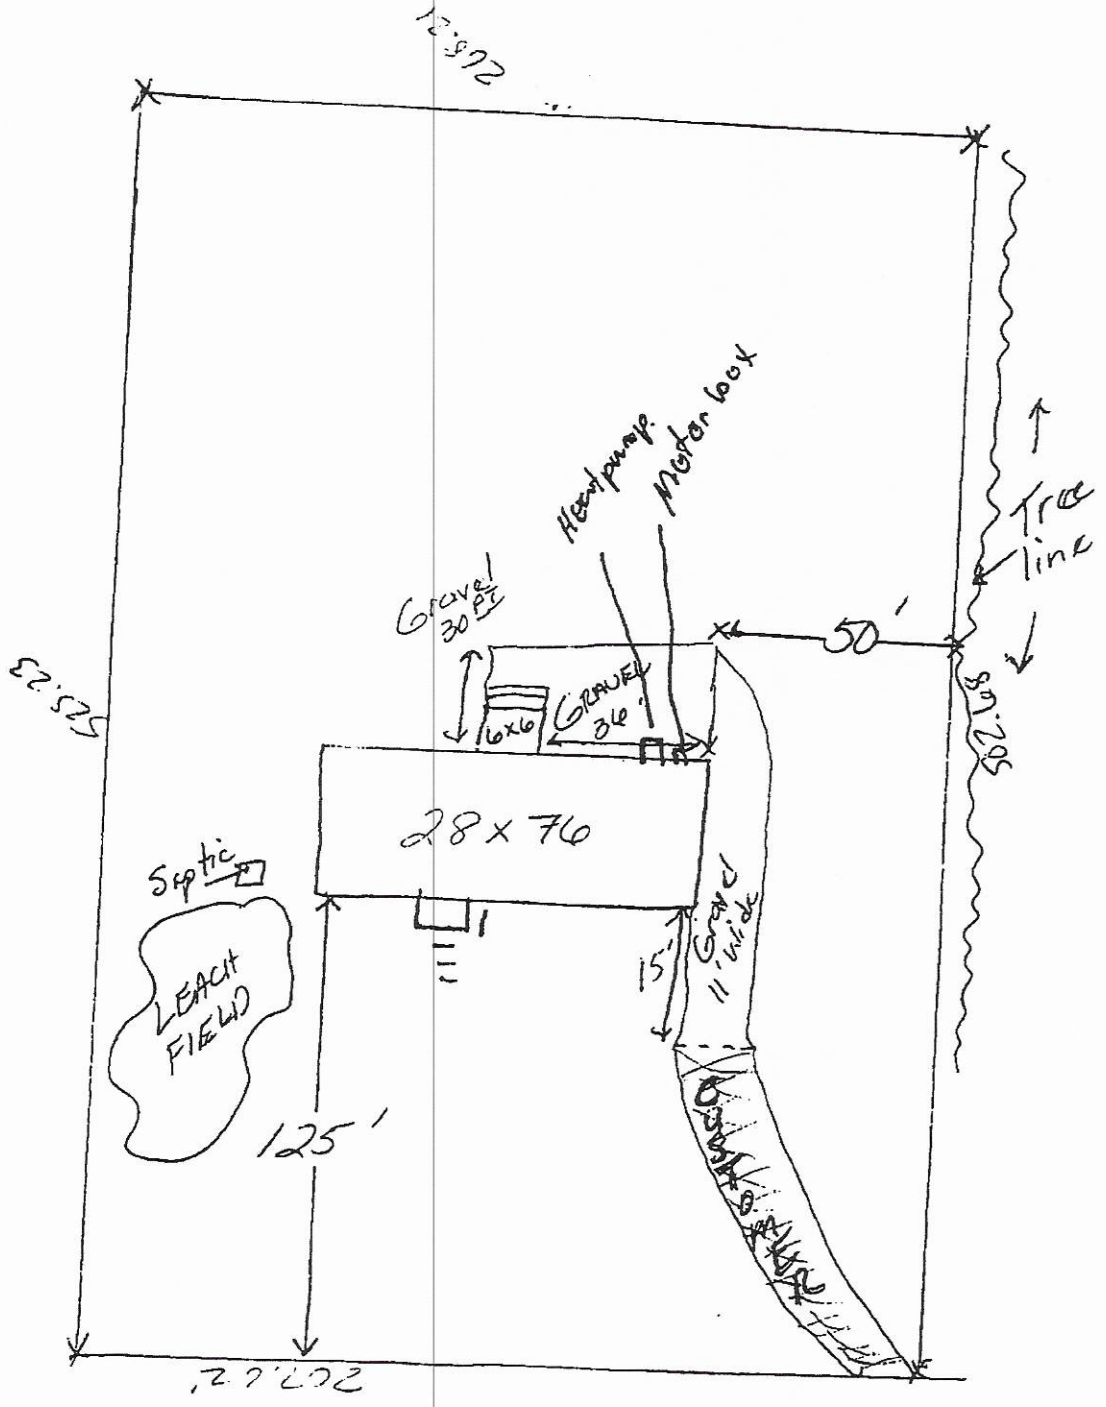


Chas C Creason

DocuSign Envelope ID: 94BD4D49-8662-41B9-8ED4-BAAAE81A0BEE

Breeze II 28x76

Kimberly Sund 6-5-2020

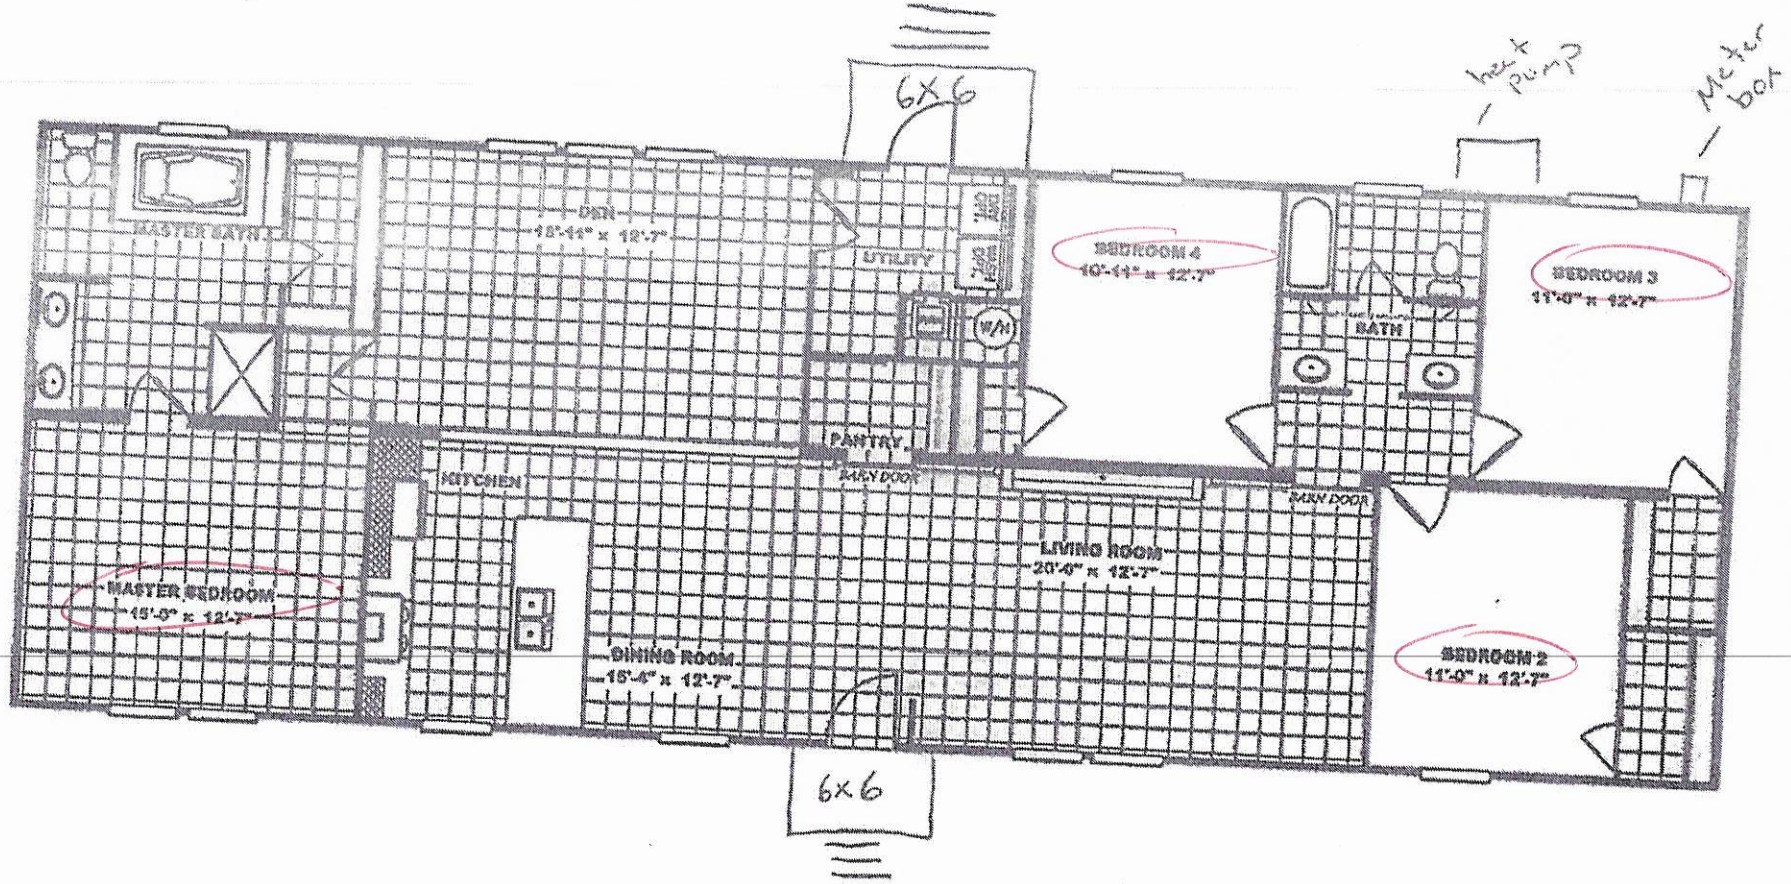

APPROVED
SIGNATURE: DocuSigned by: 34EF3AEACF10408...
DATE: 6/1/2020

Carla C. Nichols 6-30-20

APPROVED
SIGNATURE: DocuSigned by: 34EF3AEACF10408...
DATE: 6/1/2020

DocuSign Envelope ID: E037720B-9AD6-4AA2-A14A-AE0C1DF1536E

IREDELL COUNTY DEPARTMENT OF ENVIRONMENTAL HEALTH

DOCUMENTATION TO AUTHORIZE AN OWNER'S LEGAL REPRESENTATIVE

Applications for permits require the "signature of the owner or owner's legal representative" (15A NCAC 18A .1937). If the owner does not sign the application himself or herself, they can submit any one of the following documents to designate their legal representative:

Power of Attorney; Real Estate Contract; Estate executor; Bankruptcy trustee; Court ordered guardianship

In the absence of the above documentation, the property owner may provide the local health department with documentation that designates a legal representative. A property owner may:
Complete this form to document his or her legal representative, or provide his or her own form that contains the information in this form.
If there are multiple property owners, then all property owners must sign the form that designates a legal representative.

By signing a form that designates a legal representative for purposes of 15A NCAC 18A .1937, the property owner authorizes that representative to act on their behalf in matters pertaining to the application and permitting process, including signing or receiving any application, document or permit. The owner retains full responsibility to meet all permit conditions specified by the local health department

I, Christopher Crosby, am the legal owner(s) of the property located at 130 Chris Thomas Road Harmony, NC, identified as PIN (Parcel Identification Number) 4771-36-5419, located in Iredell County, North Carolina.

I do hereby authorize (print legal representative/company name) Freedom Homes, Kimberly Sneed to act as an agent on my behalf in applying for/signing/obtaining any of the documents described below.

- Application for Improvement Permit (IP) / Authorization to Construct (AC)
- Improvement Permit (IP) / Authorization to Construct (AC)
- Application for soil-site evaluation (new/repair)
- Application/permit for private drinking water well/well abandonment
- Application for Compliance Inspection

I agree to abide by all decisions and/or conditions between the legal representative acting on my behalf and the Iredell County Department of Public Health, Environmental Health Division.

Signature of Owner(s) — Date 6/4/2020

Signature of Witness — Date 6-4-2020

Please return this signed form to the appropriate office:

Mooresville - Environmental Health
ronda.hart@co.iredell.nc.us
Fax: 704-662-3239
610 E. Center Avenue, Mooresville, NC 28115

Statesville - Environmental Health
adrienne.shea@co.iredell.nc.us
Fax: 704-871-3483
349 N. Center Street, Statesville, NC 28677

Family Subdivision For:

Ricky Lance Crutchfield

Turnersburg Township, Iredell County, NC
Owners of Record: Ricky Lance Crutchfield and wife, Jo Ann M. Crutchfield
Deed Reference: D.B. 1653, Pg. 1778
PIN: 4778-38-5419
Job Number: 200566.DWG (200566.CRD)
Field Work: 5-14-2020
Plat Date: 5-22-2020

Legend


CAPS ON MONUMENTS SET CONTAIN THE SURVEYORS NAME AND LICENSE NUMBER.


- EIP ..... EXISTING IRON PIPE AS SHOWN
- EIR ..... EXISTING IRON ROD AS SHOWN
- CP ..... COMPUTED POINT
- IRS ..... 1/2" IRON ROD SET WITH YELLOW CAP
- MNF ..... MAG. NAIL FOUND
- RS ..... ROAD SIGN
- UP ..... UTILITY POLE
- EP ..... EDGE OF PAVEMENT
- R/W ..... RIGHT OF WAY
- PIN ..... PARCEL IDENTIFICATION NUMBER
- NTS ..... NOT TO SCALE
- LINE NOT SURVEYED
- LINE SURVEYED
- OHU OVERHEAD UTILITIES
- SURVEYED LINE NOT TO SCALE


Zoning

ZONING: RA (Residential Agricultural)
Building Setback
Front = 35'
Side = 35'
Rear = 35'

BUILDING HEIGHT RESTRICTIONS AS FOLLOWS:
Maximum Height 35'

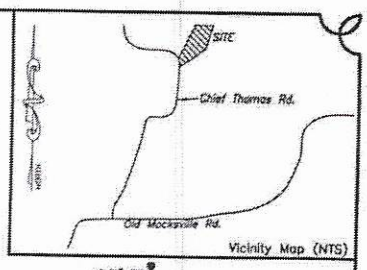

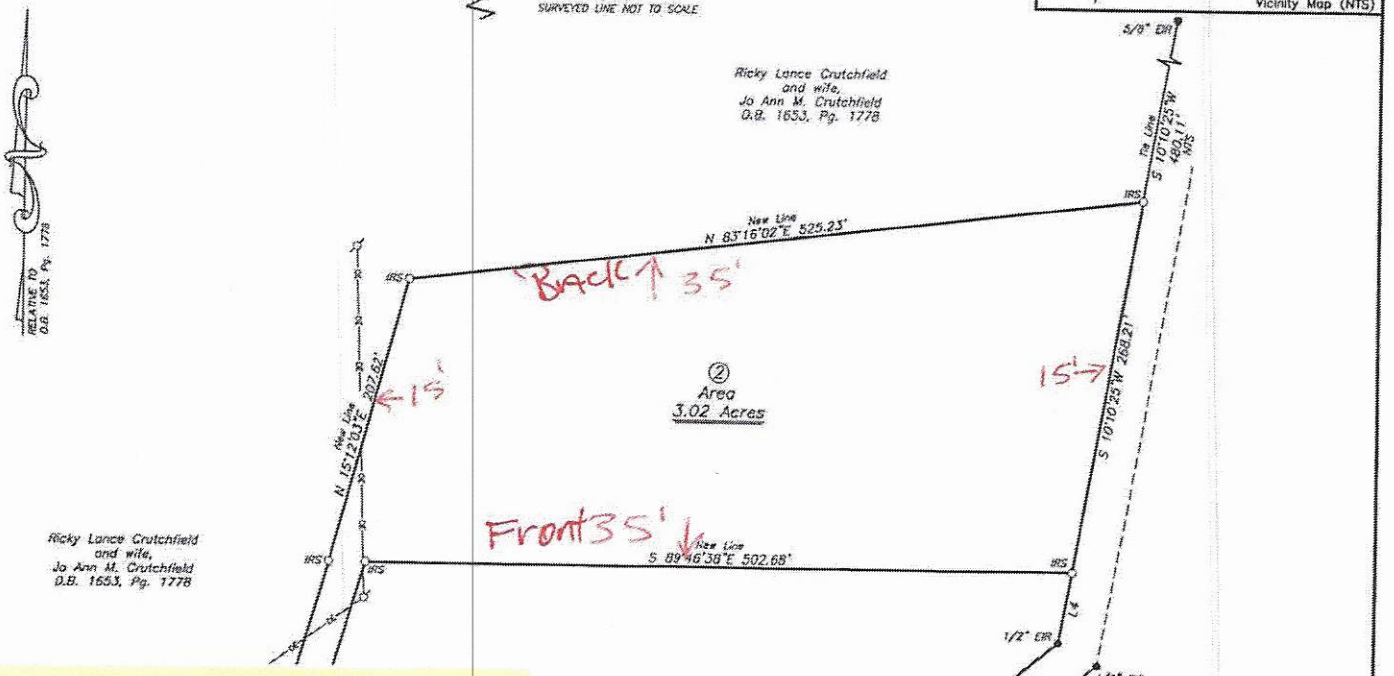

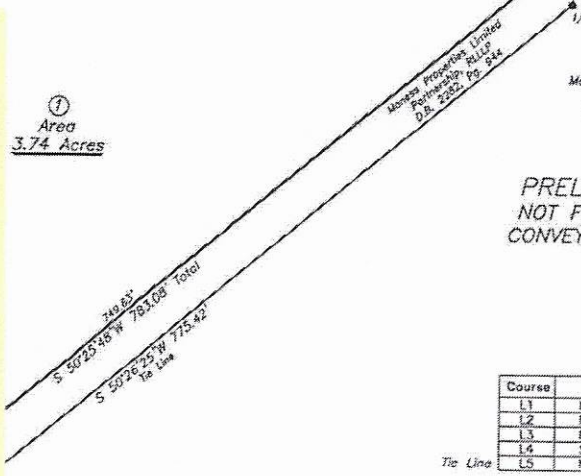

Maness Properties Limited Partnership, RLLLP

PRELIMINARY PLAT: NOT FOR RECORDATION, CONVEYANCES, OR SALES

	Course	Bearing	Distance
	L1	N 13°18'29" W	96.11'
	L2	N 13°18'29" W	39.98'
	L3	N 17°00'58" W	9.82'
	L4	S 10°10'25" W	51.26'
Tie Line	L5	N 13°15'30" W	33.33'

PRELIMINARY APPROVAL

WILLIAM ALLISON
COUNTY PLANNER

HOLD BUILDING PERMIT UNTIL LOT IS DEEDED OFF. (LOT MUST HAVE ROAD FRONTAGE ONTO CHIEF THOMAS ROAD)

W. Allison 6-12-20

60 120 180
= FEET 1" = 60'

Notice

* Property subject to any easements and right of way on record, and all NCDOT easements and rights of way.
* This survey is subject to any facts that may be disclosed by a full and accurate title search.
* This survey plat does not show any unrecorded, written or unwritten easements, dedications or other encumbrances. Such burdens could exist on this property and not appear on this plat. Accordingly, users of this plat are warned to remain alert for the existence of such unrecorded burdens not shown hereon.
* This plat was drawn for the exclusive use of the party named hereon. Said certificates do not extend to any unnamed person without an express recertification by the surveyor naming said person.
* This plat represents an actual field survey that meets or exceeds the minimum requirements of a Class C Survey in accordance with the Standards of Practice for Land Surveying in North Carolina according to North Carolina Administrative Code Title 21, Chapter 56, Section 1600.
* The ratio of precision before any adjustments is 1:35,573.
* Area determined by coordinate computations.
* No NGS or NCGS Horiz. Control Monument found within 2,000 feet of the site.

Witness this my original signature, registration number and seal this _____ day of _____, 2020 A.D.

_____
Ted M. Benbow NC PLS L-3175
Firm License # C-1588

NORTH CAROLINA PROFESSIONAL SEAL L-3175 LAND SURVEYOR TED M. BENBOW

rtificate

rdered Emergency Management Agency and e Map (DFIRM) Panel 4778, Iredell County, 3710477800J, effective date:March 18, located within a special flood hazard area. signated "Zone X - other areas". Areas of chance floodplain; areas outside future

ZONING SETBACKS / PRELIMINARY APPROVAL W. Allison 6-12-20
WILLIAM ALLISON
COUNTY PLANNER

IREDELL COUNTY · NC

IREDELL COUNTY
PO Box 788
349 North Center St.
Statesville, NC 28677

APPLICATION NUMBER

308225
Issue Date:

Permit Type: ZONING

Parcel Number	Street Address	Jurisdiction
4778385419.000	549 CHIEF THOMAS RD	IREDELL COUNTY

Owner Information	Applicant Information
Name: CRUTCHFIELD RICKY L+JO ANN M	Name: FREEDOM HOMES-TROUTMAN #667- USE THIS ONE
Address:	Address: 1124 CHARLOTTE HWY TROUTMAN, NC 28166
Phone:	Phone: (704)801-2326

Use Requested	Zone Code
Double-Wide Mobile Home	RA

Lot Acreage	F Setback	B Setback	L Setback	R Setback	Watershed	Flood Zone
0	35	35	15	15		NO

Remarks

DOUBLEWIDE SEE NOTES BEFORE ISSUING

REQUIREMENTS FOR ALL MULTI -SECTIONAL MOBILE HOMES Must meet requirement R9 of the LDC. Minimum size of main body is at least 22 feet by 40 feet; Must have standard residential shingles; Minimum of 3/12 roof pitch; Must have continuous masonry underpinning; Must have minimum roof eave and raker projections of 6 inches; Must have a 36 square foot deck or porch at all front entrances; Exterior siding must consist of vinyl or aluminum lap siding, wood, or hardboard, comparable in composition, appearance and durability to residential siding; Must remove towing apparatus; Must face front property line and be no less than 20 degrees from parallel to the front property line. Original mobile home must be removed before Certificate of Occupancy can be approved.


The applicant certifies that there are no deed restrictions, contractual agreements or governmental regulations of any kind that interfere with or prohibit the use of the property or the use for which this permit is requested. The applicant further acknowledges that enforcement of deed restrictions, plat conditions and other contractual agreements will not be undertaken by Iredell County and is the sole responsibility of the affected parties.

Signature of Owner/Contractor

Date: 06/12/2020

Permit Number	308225	TOTAL FEES:	$77.25

ZONING DISCLAIMER

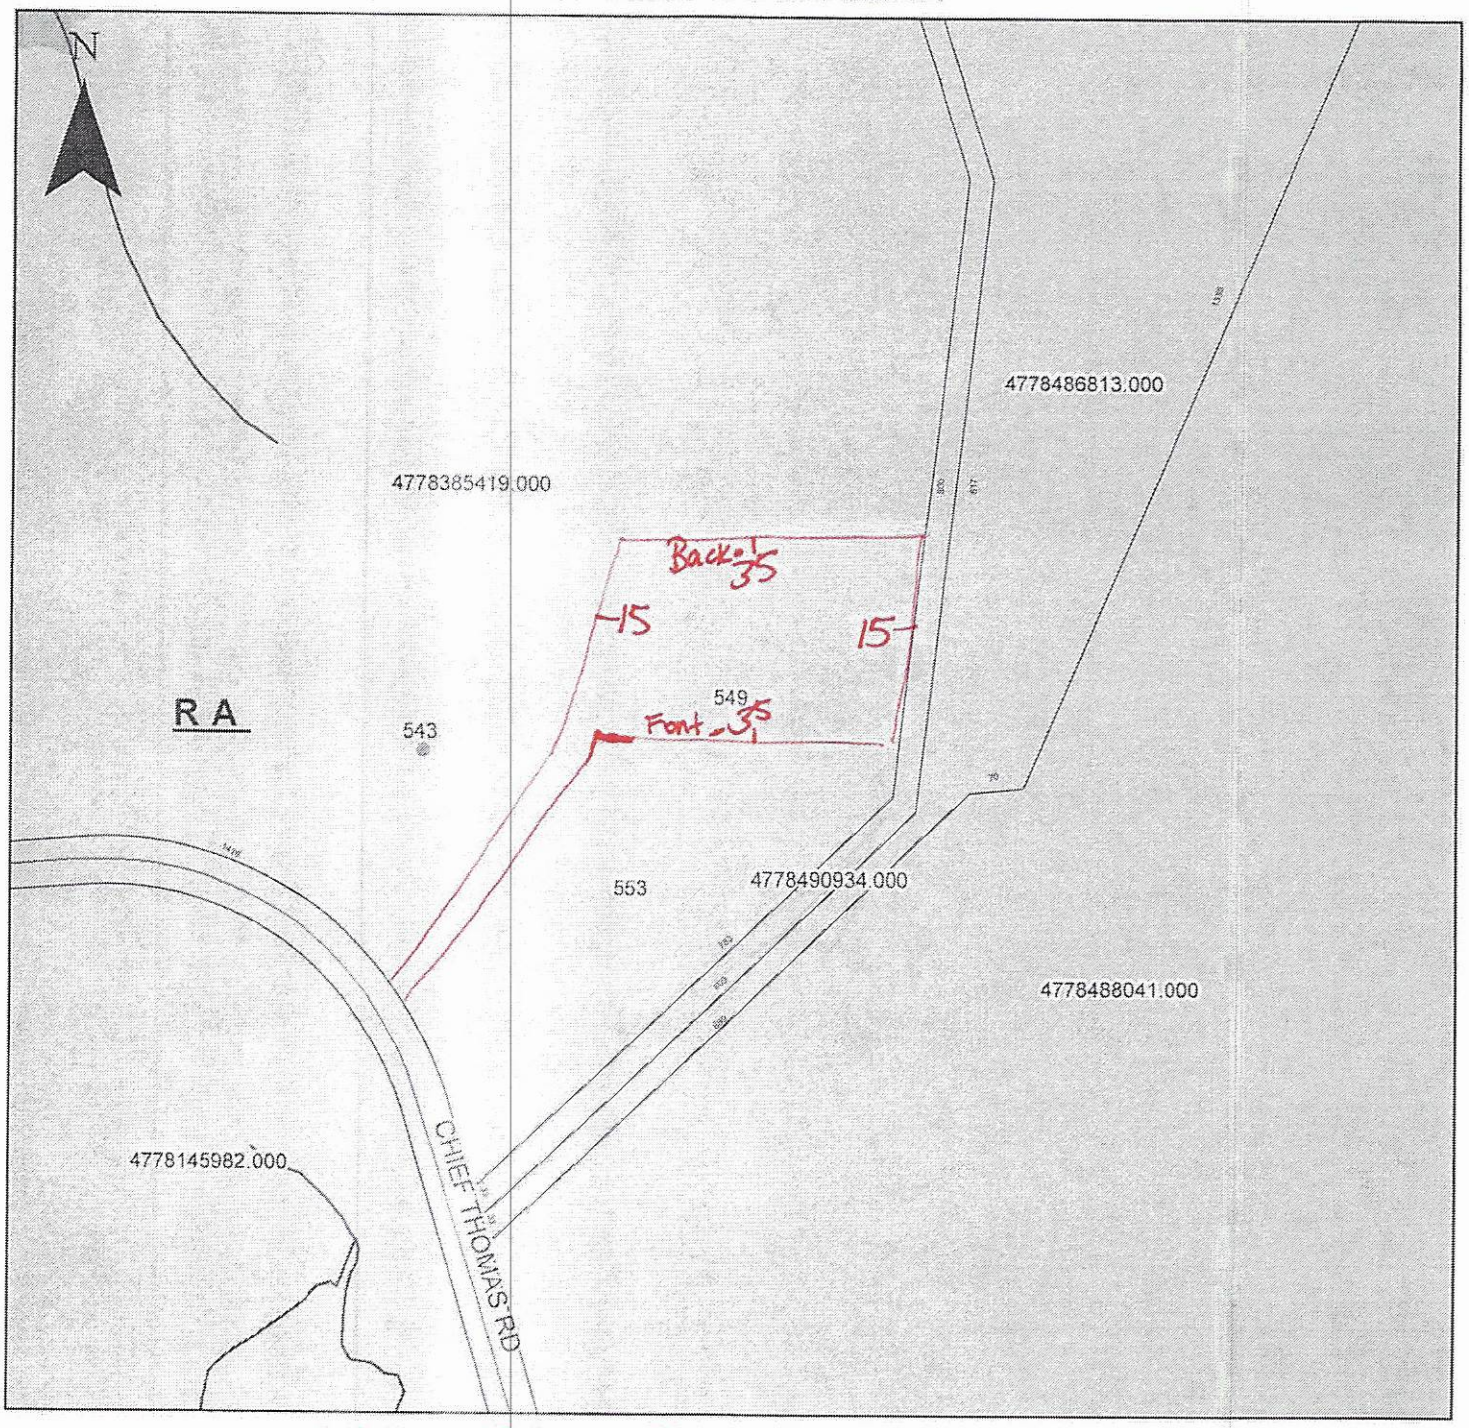

Property Address 549 Cheif Thomas

The applicant certifies that there are no deed restrictions, contractual agreements or governmental regulations of any kind that interfere with or prohibit the use of the property or the use for which this permit is requested. Applicant further acknowledges that the enforcement of deed restrictions, plat conditions, and other contractual agreements will not be undertaken by Iredell County and is the sole responsibility of the affected parties.

Applicant

Date