CATHY NORRIS

IREDELL COUNTY HEALTH DEPARTMENT

STATESVILLE 704-878-5305 MOORESVILLE 704-664-5281

IMPROVEMENT PERMIT / AUTHORIZATION TO CONSTRUCT / OPERATION PERMIT / EXISTING SYSTEM INSPECTION

(1)

PERMIT# 14858 PIN# 4778-51-3819 3219 DATE 8-19-03

OWNER OR CONTRACTOR J. TODD ELLIS BUILDERS PHONE: Business 704-968-3728 Home 704-924-7830

ADDRESS 1785 OLD MOCKSVILLE ROAD STATESVILLE NC 28625

LOCATION OLD MOCKSVILLE ROAD NE, DRIVEWAY ON LEFT JUST PAST WHITE OAK BRANCH ROAD, 1200' BACK OFF ROAD

SUBDIVISION _____ BLOCK / SECTION _____ LOT _____ LOT AREA 64.53 ACRES SITE CLASS. PS DESIGN FLOW 360 L.T.A.R. 0.30 GPD/FT²

Septic Tank: 1000 Gallons; STB 1012 Date 5-14-04

Pump Tank: _____ Gallons; PT _____ Date _____

Pump Make: _____ Model _____ Serial No. POND

Nitrification Field: No Fields 1 Square Feet 1200 Linear Feet 400

No Lines FOUR Trench Width 36" Max Trench Bottom Depth 36" Gravel Depth 12"

☑ New System ☐ Repair System Type: I, II, III, IV, V, VI

System Description: CONVENTIONAL GRAVITY

Repair System Description: CONVENTIONAL GRAVITY

Maintenance Agreement Required: ☐ Yes ☑ No

☑ House/Mod. Home No. Bedrooms 3

☐ Mobile Home No. Bathrooms 2.5

☐ Business No. Employees ____

☐ Other _____


☐ Slab ☑ Crawl Space ☐ Basement w/plumbing ☐ Basement wo/plumbing

Water Supply: ☑ Individual ☐ Public ☐ Community WELL


Comments:/Conditions: KEEP SYSTEM MINIMUM 100' FROM WELL, INSTALL LINES ON CONTOUR AT LOCATION SHOWN

Comments:/Conditions: SEPTIC TANK WITH MARKER INSTALLED ~~ACCORDING TO INITIAL SITE~~ USING "TUFTITE" FILTER. HOUSE RELOCATED AS SHOWN BELOW

INITIAL SITE SKETCH

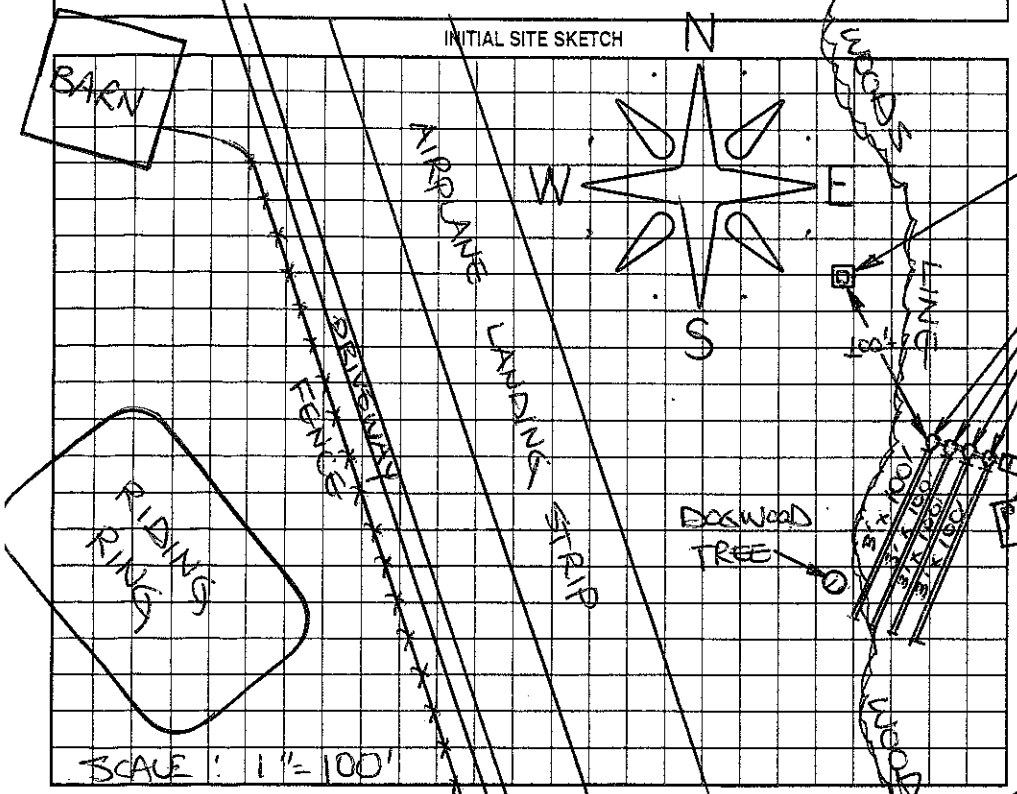

AS BUILT SKETCH

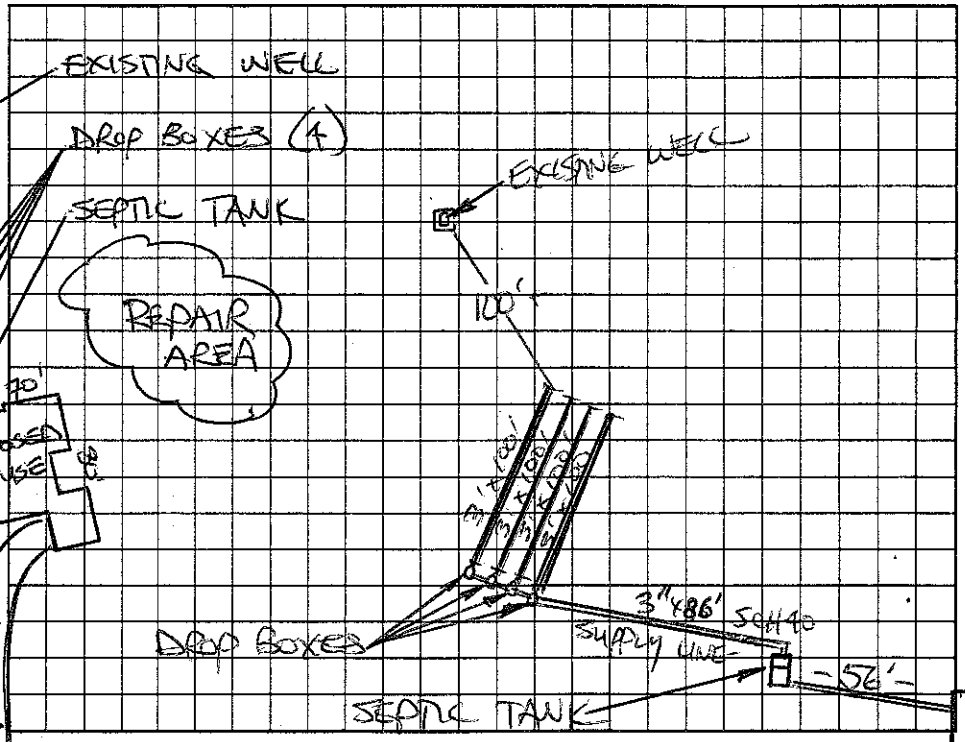

Permit can be suspended or revoked if any false information is supplied toward securing the permit, any unauthorized changes are made to the site/any unauthorized changes are made in the installation of the system. Improvement Permit with plat valid without expiration. Improvement Permit with site plan valid for sixty months. Authorization to Construct is valid for a period equal to that of Improvement Permit – not to exceed sixty months.

Signed: Dana Cecil date 9-17-03 Installed by: DAVID YOUNTZ

Improvement Permit by: STEVE HEDRICK date 8-19-03 Operation Permit by: STEVE HEDRICK date 10-14-04

Authorization to Construct by: STEVE HEDRICK date 8-19-03 Existing System Inspection by: _____ date _____

HEALTH DEPT. COPY: WHITE OWNER COPY (FINAL): YELLOW OWNER COPY (INITIAL): PINK