THIS PERMIT VOIDS PREVIOUS ISSUED 3-16-2000

IREDELL COUNTY HEALTH DEPARTMENT

STATESVILLE 704-878-5305 (2) MOORESVILLE 704-664-5281

IMPROVEMENT PERMIT / AUTHORIZATION TO CONSTRUCT / OPERATION PERMIT / EXISTING SYSTEM INSPECTION

PERMIT# 087485 PIN# 4778-79-4377 (A) DATE 5-22-02

OWNER OR CONTRACTOR ANDY BROWN PHONE Business 704-872-0227 Home

ADDRESS P.O. BOX 1651, STATESVILLE, NC 28687

LOCATION US 21 N, TR BETHEL RD, TR FOUR ANDREWS DR, LOT AT END OF CUL-DE-SAC

SUBDIVISION ROCK GATE EST. BLOCK / SECTION LOT 45 LOT AREA 1.58 ACRES SITE CLASS PS DESIGN FLOW 360 LTAR 0.30 GPD/FT²

Septic Tank: 1000 Gallons: STB 1012 Date 1-20-02
Pump Tank: Gallons: PT Date
Pump Make: Model Serial No
Nitrification Field: No Fields 1 Square Feet 1200 Linear Feet 300
No Lines FOUR Trench Width 36" Max Trench Bottom Depth 36" Gravel Depth N/A

✓ New System Repair System Type I II III IV V
System Description 25% REDUCTION, GRAVITY
Repair System Description 50% REDUCTION, LOW-FLOW
Maintenance Agreement Required Yes ✓ No


House/Mod Home No Bedrooms 3
✓ Mobile Home No Bathrooms 2
Business No Employees
Other
Slab ✓ Crawl Space Basement w/plumbing Basement wo/plumbing

Water Supply
☐ Individual
✓ Public
☐ Community


Comments/Conditions: CONTACT HEALTH DEPT. AFTER STAKING OUT MH TO FLAG OUT DRAINFIELD

Comments Continued: (1) SYSTEM INSTALLED USING THREE HDS SECTIONS AS SHOWN BELOW (2) SEPTIC TANK WITH MARKER INSTALLED USING "PECKOK" FILTER

INITIAL SITE SKETCH

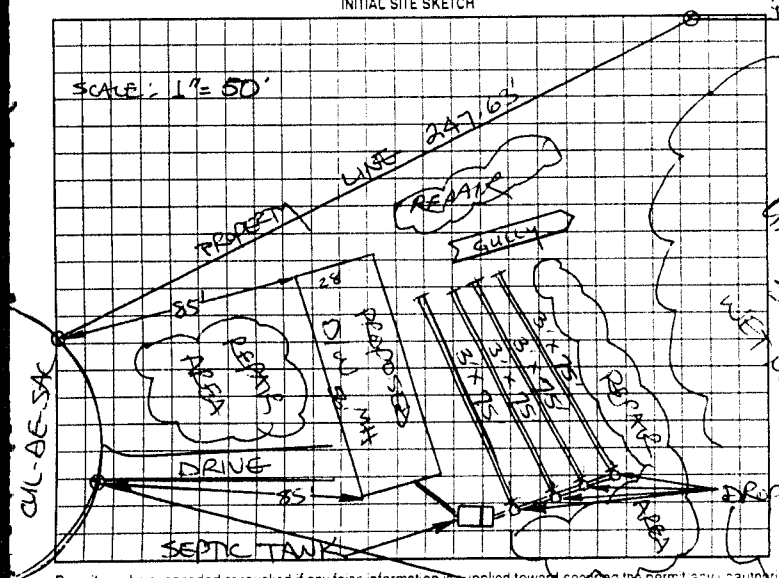

AS BUILT SKETCH

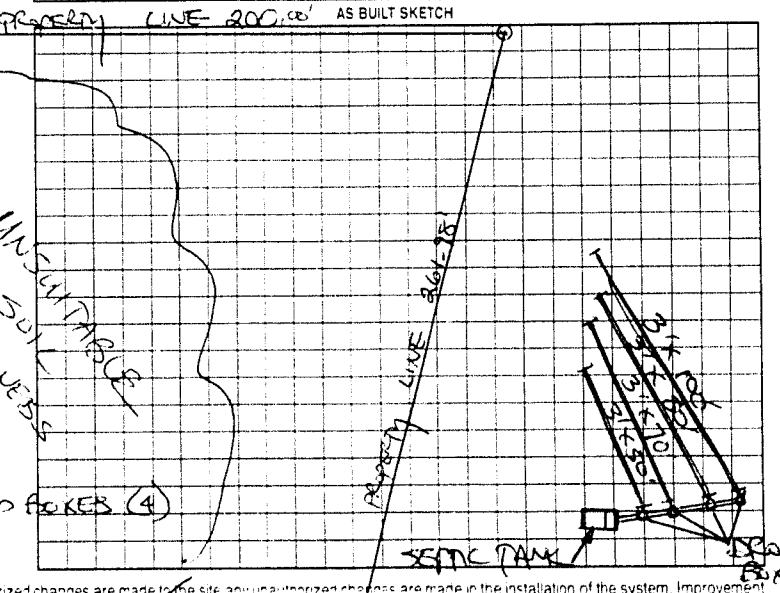

Permit can be suspended or revoked if any false information is supplied toward securing the permit, any unauthorized changes are made to the site, any unauthorized changes are made in the installation of the system. Improvement Permit with plat valid without expiration. Improvement Permit with site plan valid for sixty months. Authorization to Construct is valid for a period equal to that of Improvement Permit - not to exceed sixty months.

Signed: [signature] date 5/22/02 Installed by TOMMY FRYE

Improvement Permit by: STEVE HENDRICK date 5-22-02 Operation Permit by STEVE HENDRICK date 8-23-02

Authorization to Construct by: STEVE HENDRICK date 5-22-02 Existing System Inspection by date

HEALTH DEPT COPY WHITE OWNER COPY (FINAL) YELLOW OWNER COPY (INITIAL) PINK