IREDELL COUNTY HEALTH DEPARTMENT

STATESVILLE 704-878-5305 MOORESVILLE 704-664-5281

IMPROVEMENT PERMIT / AUTHORIZATION TO CONSTRUCT / OPERATION PERMIT / EXISTING SYSTEM INSPECTION

PERMIT# 808443 PIN# 4778609223 DATE 5-20-99

OWNER OR CONTRACTOR New Hope Bapt. Church PHONE: Business 872-5849 Home

ADDRESS 1986 old mocksville Rd statesville

LOCATION old mocksville Rd TR

SUBDIVISION BLOCK / SECTION LOT LOT AREA 5 acres SITE CLASS P3 DESIGN FLOW 750 L.T.A.R. .3

Septic Tank: 1500 Gallons; STB 1011 Date 3-28-99
Pump Tank: 1500 Gallons; PT 99 Date 12-15-98
Pump Make: Goulds Model 3885 Serial No. WE1012H
Nitrification Field: No Fields 1 Square Feet 2410 Linear Feet 800
No Lines 5 Trench Width 36" Max Trench Bottom Depth 36" Gravel Depth 12"

☒ New System ☐ Repair System Type: I, II, III, IV, V, VI
System Description: Pump To Conv.
Repair System Description: " " "
Maintenance Agreement Required: ☐ Yes ☒ No
☐ Slab ☐ Crawl Space ☒ Basement w/plumbing ☐ Basement wo/plumbing


☐ House/Mod. Home No. Bedrooms
☐ Mobile Home No. Bathrooms
☐ Business No. Employees
☒ Other Church (150 seats)

Water Supply: ☐ Individual ☒ Public ☐ Community


Comments/Conditions:

Comments/Conditions: See Attached Sheets for Pump to Manifold set up

INITIAL SITE SKETCH

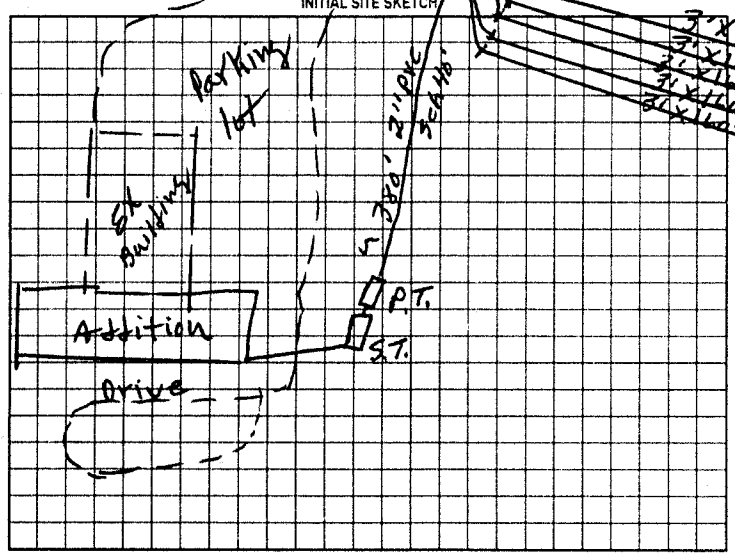

AS BUILT SKETCH

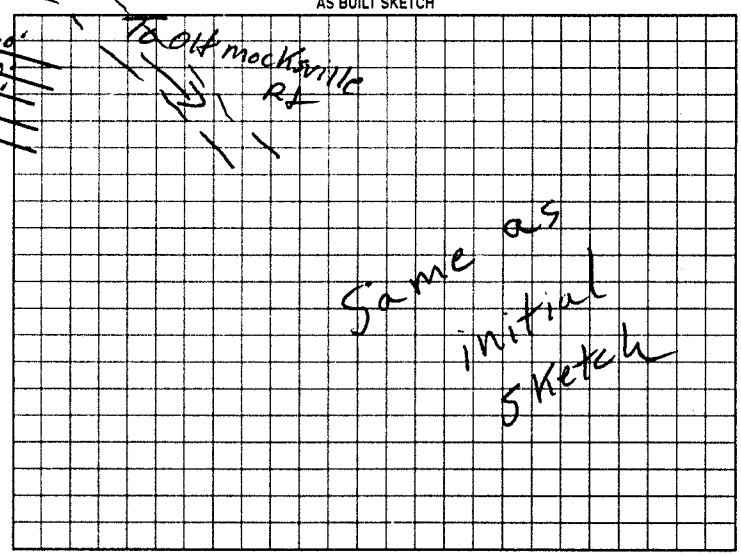

Permit can be suspended or revoked if any false information is supplied toward securing the permit/any unauthorized changes are made to the site/any unauthorized changes are made in the installation of the system. Improvement Permit with plat valid without expiration. Improvement Permit with site plan valid for sixty months. Authorization to Construct is valid for a period equal to that of Improvement Permit - not to exceed sixty months.

Signed: Clyde Feller date 5-21-99 Installed by: David Yountz

Improvement Permit by: P.C. Moore date 5-20-99 Operation Permit by P.C. Moore date 6-9-99

Authorization to Construct by: P.C. Moore date 5-20-99 Existing System Inspection by: date

HEALTH DEPT COPY WHITE OWNER COPY (FINAL) YELLOW OWNER COPY (INITIAL) PINK