IREDELL COUNTY HEALTH DEPARTMENT

Statesville Office (704) 878-5305 Mooresville Office (704) 660-3625 PERMIT # 209379 / 209446

IMPROVEMENT PERMIT / AUTHORIZATION TO CONSTRUCT / OPERATION PERMIT / EXISTING SYSTEM

PIN # 4778612899

APPLICANT: Dale Gish APPLICANT ADDRESS: 817 Chief Thomas Rd.

SITE ADDRESS: 1905 Old Mocksville Rd. PHONE: 704-798-3265 ALT. PHONE: N/A

SITE DIRECTIONS: Hwy 64E TL Old Mocksville Rd. Property on Left


SUBDIVISION: N/A SECTION: N/A LOT # N/A LOT AREA: 6.32 acres DESIGN FLOW: Existing L.T.A.R.: Existing

Septic Tank	Existing (gal)	STB		Date		☐ New System ☐ Repair ☐ Expansion System Type: I (II) III IV V VI		☑ Residence	No. Bedrooms	Ex	Water Supply
Pump Tank	(gal)	PT		Date		System Description: Existing		☐ Business	No. Persons		☑ Private
Pump Make		Model		Serial #		Repair System Description:		☐ Other	No. Employees		☐ Public
# Nitrification Fields	Ex	# Lines	Ex	Linear Ft:	Ex	Maintenance Agreement Required: ☐ YES ☑ NO		☐ Slab	☑ Crawl Space		☐ Community
Trench Width	Ex	Max. Trench Bottom Depth	Ex	Gravel Depth	Ex	☑ GRAVITY ☐ PRESSURE		☐ Basement w/plumbing	☐ Basement w/o plumbing		


Comments / Conditions:

- Maintain a minimum of 5' between all building foundations & all components of septic tank system.

INITIAL SITE SKETCH

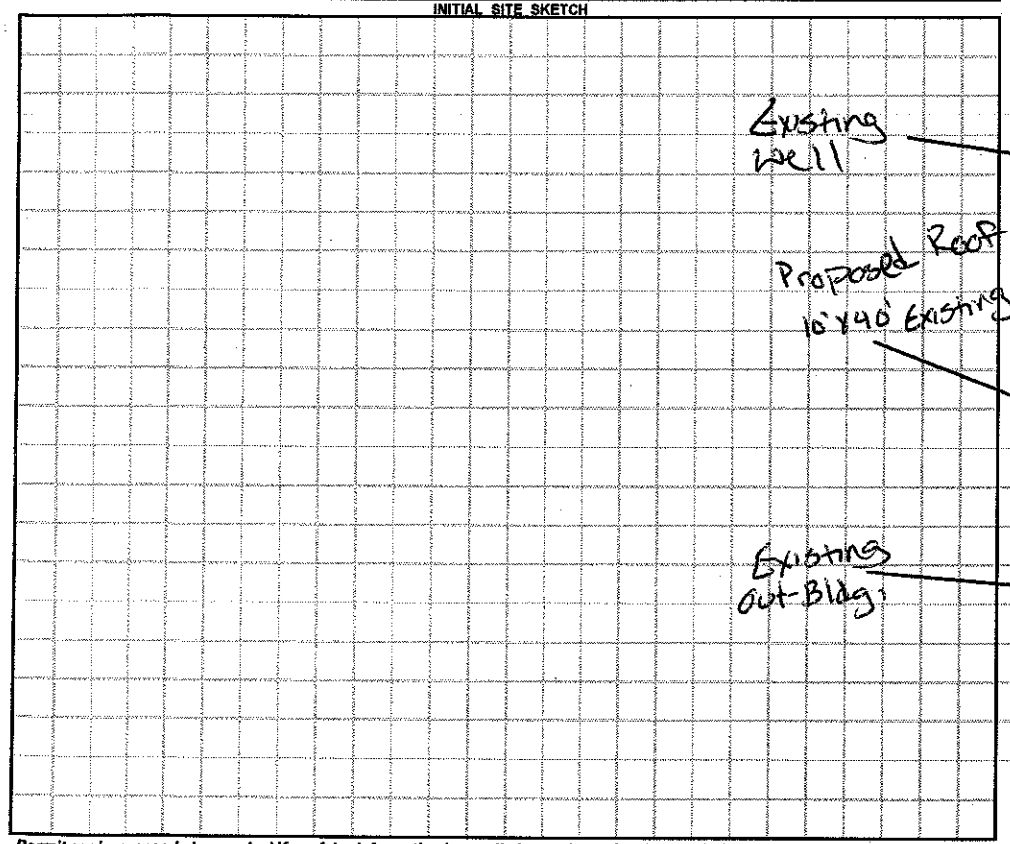

AS BUILT SKETCH

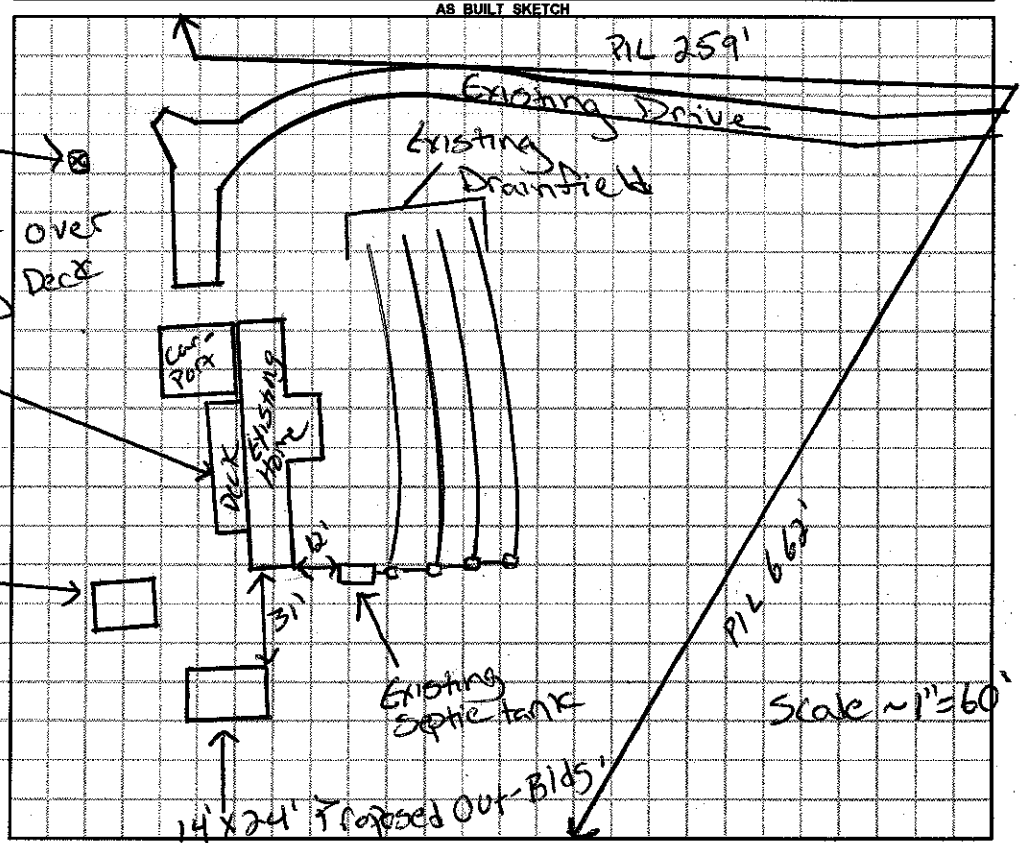

Permit can be suspended or revoked if any false information is supplied toward securing the permit / any unauthorized changes are made to the site / any unauthorized changes are made in the installation of the system. **CONTACT A LOCATOR SERVICE PRIOR TO ANY EXCAVATION**

☐ **IMPROVEMENT PERMIT** *with plat valid without expiration.* ☐ **IMPROVEMENT PERMIT** *with site plan valid for 60 mos.* ☐ **AUTHORIZATION TO CONSTRUCT** *valid for period equal to IMPROVEMENT PERMIT--not to exceed 60 mo.*

Owner / Applicant Signature: Dale N Gish Date: 4/20/15 Installed by:

IMPROVEMENT PERMIT by: Date: OPERATION PERMIT by: Date:

AUTHORIZATION TO CONSTRUCT by: Date: Existing System Inspected by: Date:

Health Dept. Copy - WHITE Applicant (Final Approval) - YELLOW Applicant (Conditional Approval) - PINK