# IREDELL COUNTY HEALTH DEPARTMENT

STATESVILLE 704-878-5305 MOORESVILLE 704-664-5281

## IMPROVEMENT PERMIT / AUTHORIZATION TO CONSTRUCT / OPERATION PERMIT / EXISTING SYSTEM INSPECTION

PERMIT# 80908 PIN# 4778635993 DATE 5-6-99

OWNER OR CONTRACTOR Paul J. Maness PHONE: Business 872-1163 Home

ADDRESS 1981 Old Mocksville Rd Statesville

LOCATION 645 To Old Mocksville Rd at River on left

SUBDIVISION Maness Dairy BLOCK / SECTION LOT LOT AREA 88 acres SITE CLASS PS DESIGN FLOW 100 L.T.A.R. .23

Septic Tank: 1000 Gallons; STB 1012 Date 4-22-99
Pump Tank: Gallons; PT Date
Pump Make: Model Serial No.
Nitrification Field: No Fields 1 Square Feet 600 Linear Feet 200
No Lines 3 Trench Width 36" Max Trench Bottom Depth 36" Gravel Depth 12"

☑ New System ☐ Repair System Type: ☐ I ☐ II ☐ III ☐ IV ☐ V ☐ VI
System Description: Conv. Gravity
Repair System Description: " "
Maintenance Agreement Required: ☐ Yes ☑ No

☐ House/Mod. Home ☐ Mobile Home ☐ Business ☐ Other Milk Barn
No. Bedrooms
No. Bathrooms
No. Employees 4


☐ Slab ☐ Crawl Space ☐ Basement w/plumbing ☐ Basement wo/plumbing

Water Supply: ☑ Individual ☐ Public ☐ Community

Comments/Conditions:


Old Mocksville Rd

INITIAL SITE SKETCH

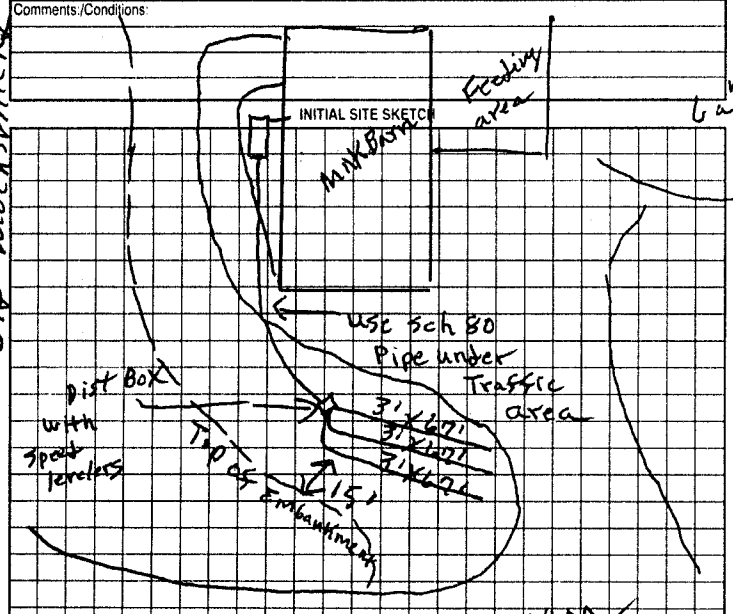


Comments/Conditions

AS BUILT SKETCH

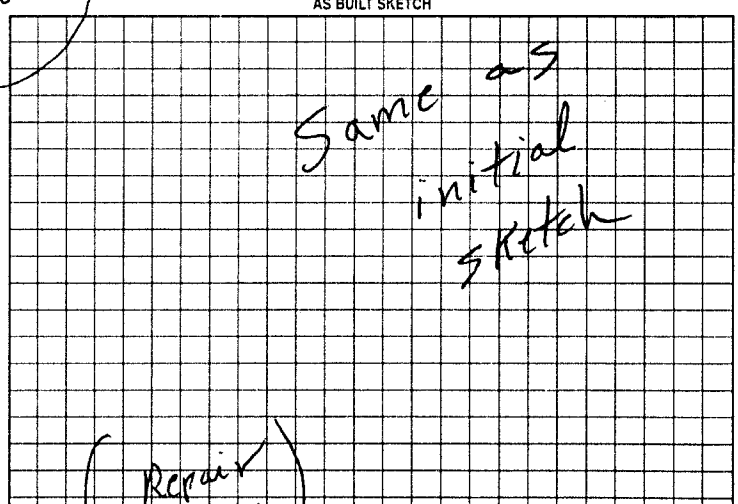


Permit can be suspended or revoked if any false information is supplied toward securing the permit/any unauthorized changes are made to the site/any unauthorized changes are made in the installation of the system. Improvement Permit with plat valid without expiration. Improvement Permit with site plan valid for sixty months. Authorization to Construct is valid for a period equal to that of Improvement Permit – not to exceed sixty months.

Signed: J. M. Maness date Installed by: Craig Thompson

Improvement Permit by: f. c. moore date 5-6-99 Operation Permit by: f. c. moore date 5-9-99

Authorization to Construct by: f. c. moore date 5-6-99 Existing System Inspection by: date

HEALTH DEPT COPY WHITE OWNER COPY (FINAL) YELLOW OWNER COPY (INITIAL) PINK