IREDELL COUNTY HEALTH DEPARTMENT

STATESVILLE 704-878-5305 (C1) MOORESVILLE 704-664-5281

IMPROVEMENT PERMIT / AUTHORIZATION TO CONSTRUCT / OPERATION PERMIT / EXISTING SYSTEM INSPECTION

PERMIT# 108855 PIN# 4778-68-6877 DATE 10-4-02

OWNER OR CONTRACTOR BOB HADEN PHONE Business Home 704-872-0227

ADDRESS P.O. BOX 1651 STATESVILLE NC 28687

LOCATION US 21 N, TR BETHEL RD, TR FOUR ACRES, TL JO CREEK, TL ANDERSON ACRES, END ON (L)

SUBDIVISION ROCK GATE EST. BLOCK / SECTION LOT 21 LOT AREA 0.736 ACRE SITE CLASS PS DESIGN FLOW 360 L.T.A.R. 0.30 GPD/FT²

Septic Tank: 1000 Gallons: STB 1012 Date 7-12-02
Pump Tank: 1000 Gallons: PT 17 Date 8-4-02
Pump Make: MYERS Model MW50-1LP Serial No 26038A901
Nitrification Field: No Fields 1 Square Feet 80 TO 1200 Linear Feet 300
No Lines FIVE Trench Width 36" Max Trench Bottom Depth 36" Gravel Depth N/A

~~New System~~ Repair System Type: I II (III) IV V VI
System Description: 25% REDUCTION, Pump
Repair System Description: 50% REDUCTION, Pump
Maintenance Agreement Required: Yes ~~No~~
~~Slab~~ ~~Crawl Space~~ Basement w/plumbing Basement wo/plumbing


~~House/Mod Home~~ ~~Mobile Home~~ Business Other
No Bedrooms 3
No Bathrooms 2
No Employees

Water Supply: ☐ Individual ☒ Public ☐ Community

Comments/Conditions: (1) SEE ATTACHED SHEETS FOR PUMP & PRESSURE MANIFOLD REQUIREMENTS (2) INSTALL 25% REDUCTION SYSTEM ON CONTUR AS FLAGGED

Comments/Conditions: TANKS & LINES INSPECTED 10-22-02, RSH
INSTALLED DURING PERIOD OF INVT SOIL CONDITIONS
SEPTIC TANK W/ MARKER INSTALLED USING "THETITE" FILTER
PRESSURE CHECKED 11-5-02, RSH

SCALE: 1" = 50' INITIAL SITE SKETCH

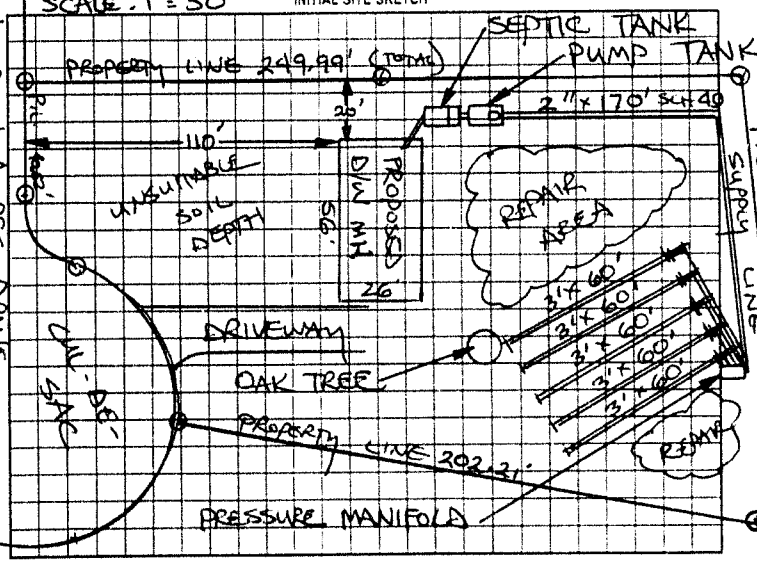

AS BUILT SKETCH

SYSTEM INSTALLED ACCORDING TO INITIAL SITE SKETCH

Permit can be suspended or revoked if any false information is supplied toward securing the permit any unauthorized changes are made to the site any unauthorized changes are made in the installation of the system. Improvement Permit with plat valid without expiration. Improvement Permit with site plan valid for sixty months. Authorization to Construct is valid for a period equal to that of Improvement Permit – not to exceed sixty months

Signed: Bob Haden date 10/4/02 Installed by CRAIG THOMPSON

Improvement Permit by: STEVE HEDRICK date 10-4-02 Operation Permit by STEVE HEDRICK date 11-25-02

Authorization to Construct by: STEVE HEDRICK date 10-4-02 Existing System Inspection by date

HEALTH DEPT COPY WHITE OWNER COPY (FINAL) YELLOW OWNER COPY (INITIAL) PINK