IREDELL COUNTY HEALTH DEPARTMENT

Statesville Office (704) 878-5305 Mooresville Office (704) 660-3625 PERMIT # 176624

IMPROVEMENT PERMIT / AUTHORIZATION TO CONSTRUCT / OPERATION PERMIT / EXISTING SYSTEM

PIN # 4778-71-0344

APPLICANT: LARRY GRYDER APPLICANT ADDRESS: 317 DUNLAP GATE RD, STATESVILLE 28625

SITE ADDRESS: 1912 OLD MOCKSVILLE ROAD, STATESVILLE 28625 PHONE: 704-873-4880 ALT. PHONE: 704-902-6358

SITE DIRECTIONS: OLD MOCKSVILLE ROAD, 3RD DRIVE ON RIGHT PAST NEW HOPE CHURCH AT #1912

SUBDIVISION: N/A SECTION: N/A LOT # N/A LOT AREA: 0.76 AC DESIGN FLOW: 360 L.T.A.R.: EX

Septic Tank EX 1000 GAL (gal) STB Date

Pump Tank (gal) PT Date

Pump Make Model Serial #

Nitrification Fields 1 # Lines 2 Linear Ft: EX

Trench Width EX Max. Trench Bottom Depth EX Gravel Depth EX

☐ New System ☐ Repair ☐ Expansion System Type: I (II) III IV V VI

System Description: CONVENTIONAL GRAVITY

Repair System Description:

Maintenance Agreement Required: ☐ YES ☒ NO

☑ GRAVITY ☐ PRESSURE

☐ Residence No. Bedrooms 2

☐ Business No. Persons

☐ Other No. Employees

☑ Slab ☐ Crawl Space

☐ Basement w/plumbing ☐ Basement w/o plumbing


Water Supply: ☑ Private WELL ☐ Public ☐ Community

Comments / Conditions:

SYSTEM UNDERSIZED ACCORDING TO TODAY'S STANDARDS

INITIAL SITE SKETCH

AS BUILT SKETCH

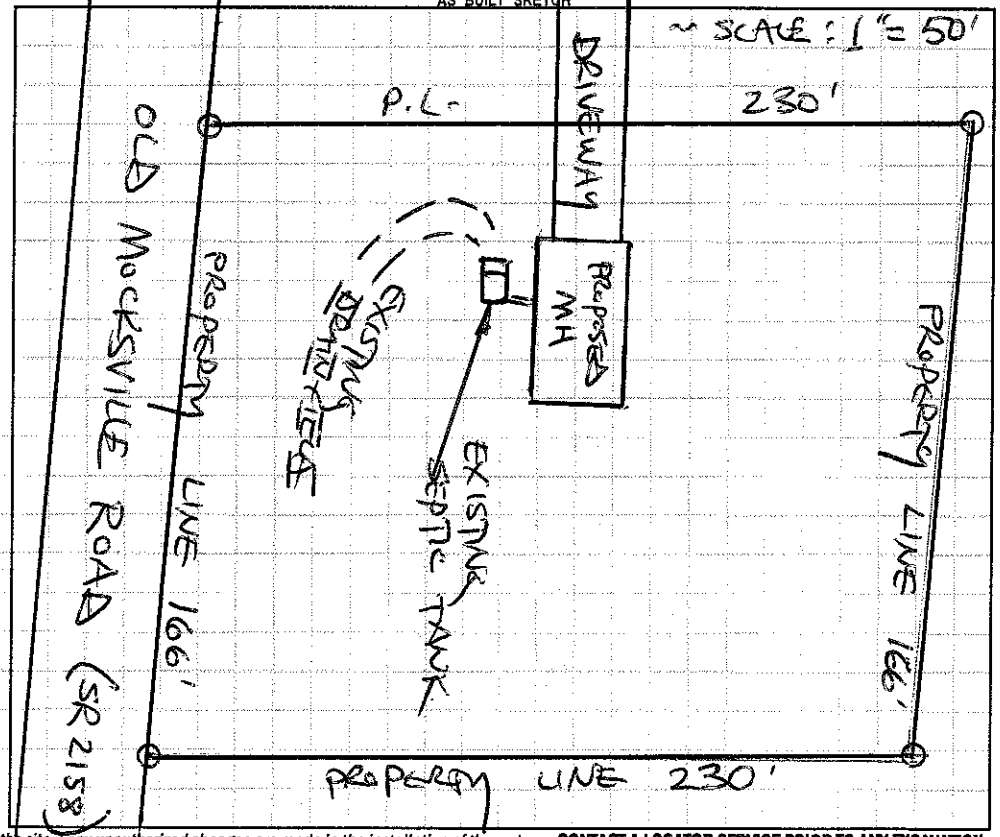

Permit can be suspended or revoked if any false information is supplied toward securing the permit / any unauthorized changes are made to the site / any unauthorized changes are made in the installation of the system. **CONTACT A LOCATOR SERVICE PRIOR TO ANY EXCAVATION**

☐ **IMPROVEMENT PERMIT *with plat*** *valid without expiration.* ☐ **IMPROVEMENT PERMIT *with site plan*** *valid for 60 mos.* ☐ **AUTHORIZATION TO CONSTRUCT** *valid for period equal to IMPROVEMENT PERMIT--not to exceed 60 mo.*

Owner / Applicant Signature: Date: Installed by:

IMPROVEMENT PERMIT by: Date: OPERATION PERMIT by: Date:

AUTHORIZATION TO CONSTRUCT by: Date: Existing System Inspected by: R. STEVE HENDRICK Date: 1-14-13

Health Dept. Copy - WHITE Applicant (Final Approval) - YELLOW Applicant (Conditional Approval) - PINK