IREDELL COUNTY HEALTH DEPARTMENT

STATESVILLE 704-878-5305 MOORESVILLE 704-664-5281

IMPROVEMENT PERMIT / AUTHORIZATION TO CONSTRUCT / OPERATION PERMIT / EXISTING SYSTEM INSPECTION

DATE

PERMIT# PIN#

OWNER OR CONTRACTOR JOSEPH M. PARLATO PHONE: Business Home

ADDRESS 703 MT. BETHEL RD., NAGMONY, NC 28634

LOCATION HWY 21 N (R) MT. BETHEL RD., APPROX. 2m: ON (R)

SUBDIVISION BLOCK / SECTION LOT LOT AREA 18 Ac. SITE CLASS PS DESIGN FLOW 100 GPD L.T.A.R. .3

Septic Tank: 1000 Gallons: STB 1100 Date 2-11-01

Pump Tank: Gallons: PT Date

Pump Make: Model Serial No.

Nitrification Field: No Fields 1 Square Feet 330' Linear Feet 110'

No Lines 1 Trench Width 3' Max Trench Bottom Depth 30" Gravel Depth 12"

(X) New System ( ) Repair System Type: I. (X) II. IV. V. VI

System Description: CONVENTIONAL

Repair System Description:

Maintenance Agreement Required: ( ) Yes (X) No

( ) House/Mod. Home No. Bedrooms

( ) Mobile Home No. Bathrooms 1

( ) Business No. Employees

(X) Other BARN


(X) Slab ( ) Crawl Space ( ) Basement w/plumbing ( ) Basement wo/plumbing

Water Supply: (X) Individual ( ) Public ( ) Community

Comments/Conditions: (1) NO CUTTING OR FILLING OVER DRAINFIELD/REPAIR AREAS (2) KEEP ALL DRAINS AWAY FROM DRAINFIELD/REPAIR AREAS (3) INSTALL DRAINLINE UNIFORM AND ON CONTOUR

Comments/Conditions: SEPTIC TANK WITH MARKER INSTALLED USING "ZABEL" FILTER

INITIAL SITE SKETCH

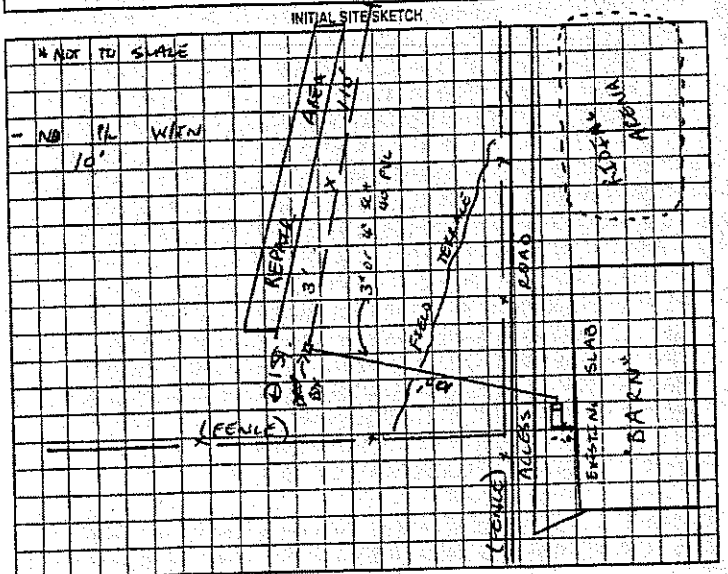

AS BUILT SKETCH

SYSTEM INSTALLED ACCORDING TO INITIAL SITE SKETCH

Permit can be suspended or revoked if any false information is supplied toward securing the permit/any unauthorized changes are made to the site/any unauthorized changes are made in the installation of the system. Improvement Permit with plat valid without expiration/ Improvement Permit with site plan valid for sixty months. Authorization to Construct is valid for a period equal to that of Improvement Permit – not to exceed sixty months.

Signed: date

Improvement Permit by: Susan Shinn date 2/5/01

Authorization to Construct by: Susan Shinn date 2/5/01

Installed by: DAVID UMBARGER

Operation Permit by: STEVE HEDRICK date 4-23-01

Existing System Inspection by: date

HEALTH DEPT COPY WHITE OWNER COPY (FINAL) YELLOW OWNER COPY (INITIAL) PINK