IREDELL COUNTY HEALTH DEPARTMENT

Statesville Office (704) 878-5305 Mooresville Office (704) 660-3625 PERMIT # 209241

IMPROVEMENT PERMIT / AUTHORIZATION TO CONSTRUCT / OPERATION PERMIT / EXISTING SYSTEM

PIN # 4778776958

APPLICANT: Timothy Stoltzfus APPLICANT ADDRESS: 708 Mt Bethel Rd Harmony NC 28634

SITE ADDRESS: 708 Mt Bethel Rd Harmony NC 28634 PHONE: 731-610-7650 ALT. PHONE: N/A

SITE DIRECTIONS: 21N T/L Mt Bethel Rd Property on right


SUBDIVISION: N/A SECTION: N/A LOT # N/A LOT AREA: 17.410 DESIGN FLOW: 100 L.T.A.R.: Ex

Septic Tank	Ex (gal)	STB	Ex	Date	Ex	☐ New System	☐ Repair	☐ Expansion	System Type: I II III IV V VI	☐ Residence	No. Bedrooms-Bathroom 1
Pump Tank	(gal)	PT		Date		System Description:	Existing			☐ Business	No. Persons
Pump Make		Model		Serial #		Repair System Description:				☒ Other	No. Employees
# Nitrification Fields	Ex	# Lines	Ex	Linear Ft:	Ex	Maintenance Agreement Required:	☐ YES	☒ NO		☒ Slab	☐ Crawl Space
Trench Width	Ex	Max. Trench Bottom Depth	Ex	Gravel Depth	Ex		☒ GRAVITY	☐ PRESSURE		☐ Basement w/plumbing	☐ Basement w/o plumbing


Water Supply: ☒ Private ☐ Public ☐ Community

Comments / Conditions: All building foundations must be 35' from any part of STS.

SKETCH

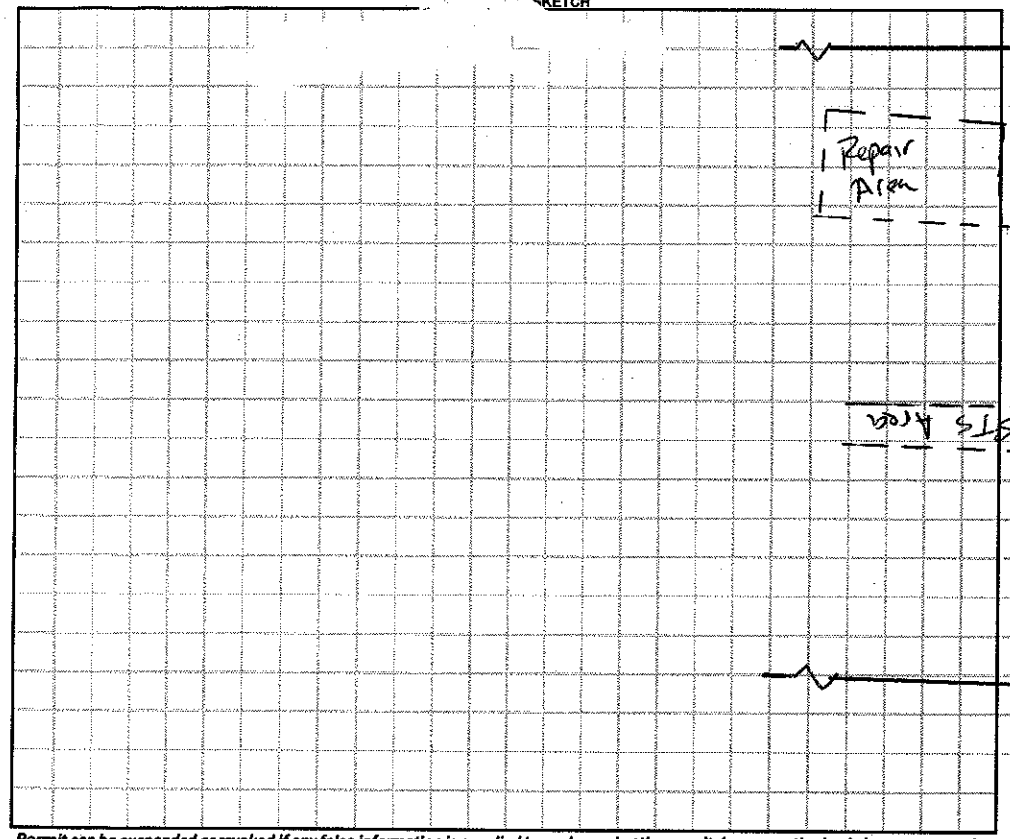

AS BUILT SKETCH

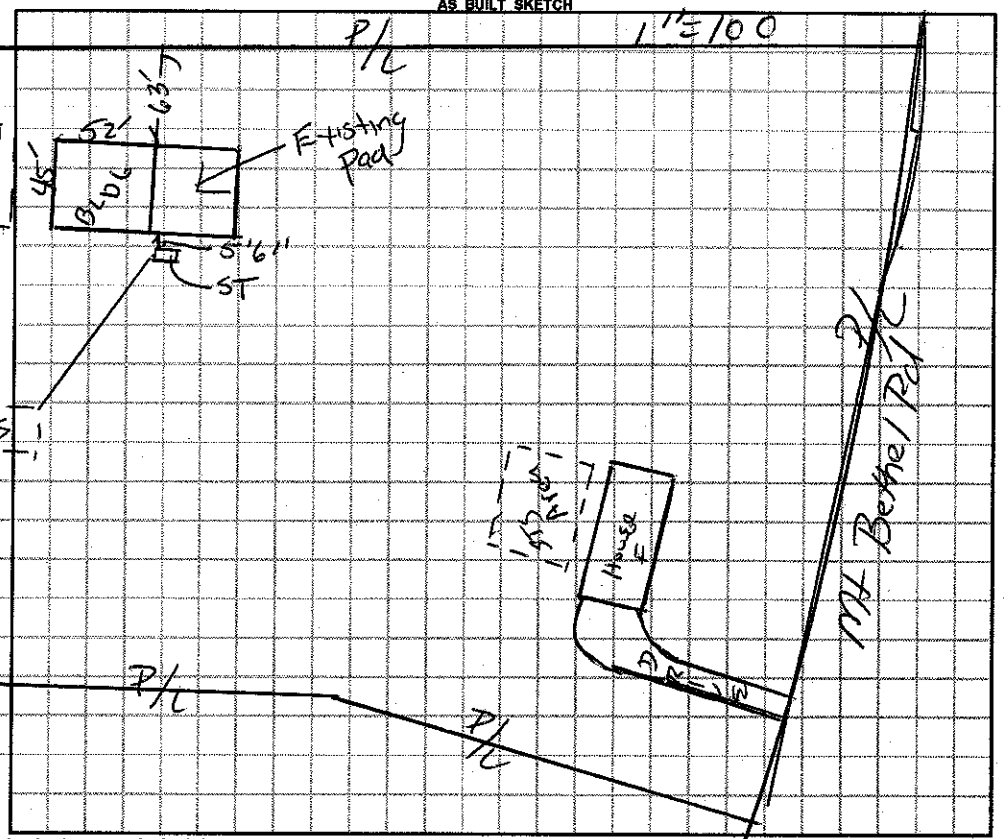

Permit can be suspended or revoked if any false information is supplied toward securing the permit / any unauthorized changes are made to the site / any unauthorized changes are made in the installation of the system. **CONTACT A LOCATOR SERVICE PRIOR TO ANY EXCAVATION**

☐ **IMPROVEMENT PERMIT** *with plat valid without expiration.* ☐ **IMPROVEMENT PERMIT** *with site plan valid for 60 mos.* ☐ **AUTHORIZATION TO CONSTRUCT** *valid for period equal to IMPROVEMENT PERMIT--not to exceed 60 mo.*

Owner / Applicant Signature: [signature] Date: 4-20-15 Installed by:

IMPROVEMENT PERMIT by: Date: OPERATION PERMIT by: Date:

AUTHORIZATION TO CONSTRUCT by: Date: Existing System Inspected by: [signature] Date: 04/08/15

Health Dept. Copy - WHITE Applicant (Final Approval) - YELLOW Applicant (Conditional Approval) - PINK