IREDELL COUNTY HEALTH DEPARTMENT

STATESVILLE 704-878-5305 MOORESVILLE 704-664-5281

IMPROVEMENT PERMIT / AUTHORIZATION TO CONSTRUCT / OPERATION PERMIT / EXISTING SYSTEM INSPECTION

PERMIT# 092839 PIN# 4778 77 9843 DATE 11-30-00

OWNER OR CONTRACTOR KENNETH SOODSON PHONE: Business _____ Home 546-7988

ADDRESS 106 THOMAS ROCK ROAD HARMONY NC 28634

LOCATION US 21 NORTH, TR BETHEL ROAD, 2ND LOT ON LEFT PAST THOMAS ROCK ROAD

SUBDIVISION BETHEL PARK BLOCK / SECTION _____ LOT 2 LOT AREA 0.96 ACRE SITE CLASS PS DESIGN FLOW 360 L.T.A.R. 0.40 GPD/FT²

Septic Tank: 1000 Gallons: STB 319 Date 4-11-00
Pump Tank: _____ Gallons: PT _____ Date _____
Pump Make: _____ Model _____ Serial No. _____
Nitrification Field: No Fields 1 Square Feet 900 Linear Feet 300
No Lines FOUR Trench Width 36" Max Trench Bottom Depth 36" Gravel Depth 12"

☒ New System ☐ Repair System Type: I II III IV V VI
System Description: CONVENTIONAL GRAVITY
Repair System Description: CONV. GRAVITY
Maintenance Agreement Required: ☐ Yes ☒ No


☐ House/Mod. Home No. Bedrooms 3
☒ Mobile Home No. Bathrooms 2
☐ Business No. Employees _____
☐ Other _____
☐ Slab ☐ Crawl Space ☐ Basement w/plumbing ☐ Basement wo/plumbing

Water Supply: ☒ Individual ☐ Public ☐ Community WELL NEXT DOOR


Comments/Conditions:

Comments/Conditions: ① SYSTEM ALTERED AS SHOWN BELOW WITH PRIOR HEALTH DEPT. APPROVAL DUE TO NEIGHBORING SYSTEM ② SEPTIC TANK WITH MARKER INSTALLED USING "TUFTITE" FILLER

INITIAL SITE SKETCH

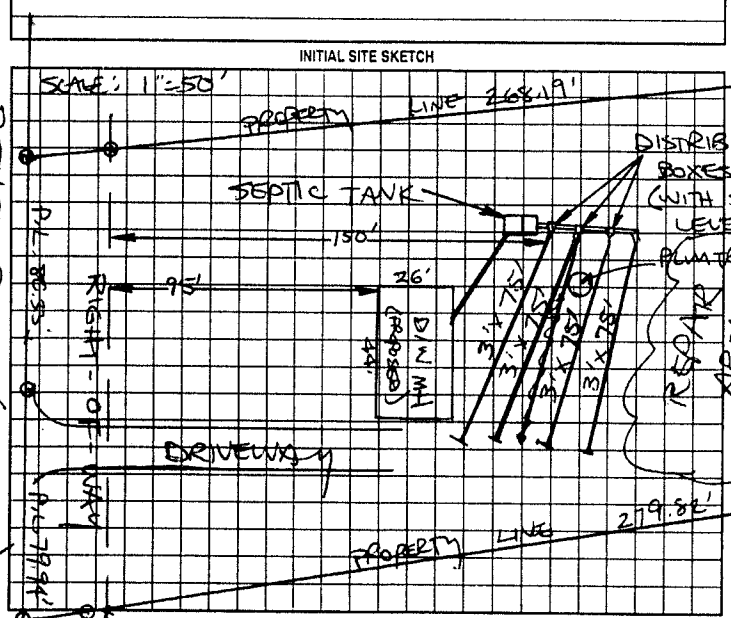

AS BUILT SKETCH

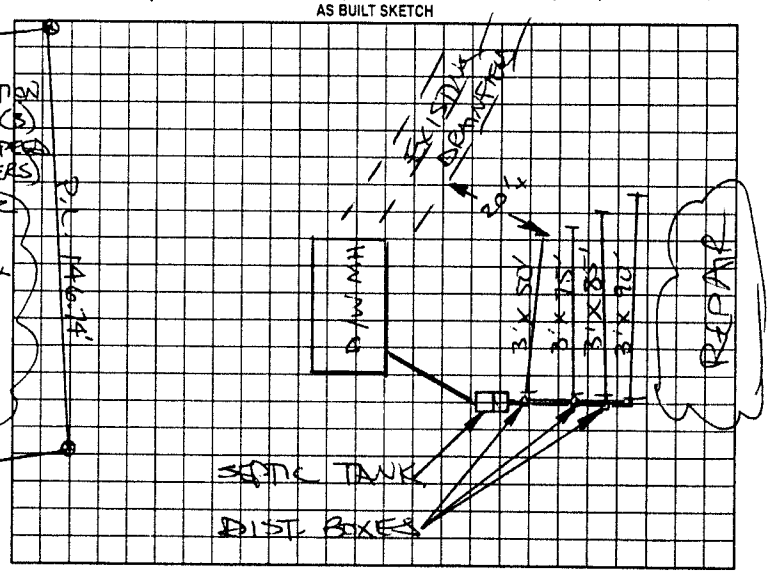

BETHEL ROAD (SR 2136)

Permit can be suspended or revoked if any false information is supplied toward securing the permit/any unauthorized changes are made to the site/any unauthorized changes are made in the installation of the system. Improvement Permit with plat valid without expiration. Improvement Permit with site plan valid for sixty months. Authorization to Construct is valid for a period equal to that of Improvement Permit – not to exceed sixty months.

Signed: Kenneth C. Soodz date 12-1-00 Installed by: DAVID UMBARGER

Improvement Permit by: STEVE HEDRICK date 11-30-00 Operation Permit by: STEVE HEDRICK date 1-08-01

Authorization to Construct by: STEVE HEDRICK date 11-30-00 Existing System Inspection by: _____ date _____

HEALTH DEPT. COPY: WHITE OWNER COPY (FINAL): YELLOW OWNER COPY (INITIAL): PINK