IREDELL COUNTY HEALTH DEPARTMENT

STATESVILLE 704-878-5305 MOORESVILLE 704-664-5281

IMPROVEMENT PERMIT / AUTHORIZATION TO CONSTRUCT / OPERATION PERMIT / EXISTING SYSTEM INSPECTION

PERMIT# 086374 PIN# 4778 79 4377 (PT) DATE 11-29-99

OWNER OR CONTRACTOR STEPHEN UDZINSKI PHONE: Business Home 546-3066

ADDRESS 140 NETTLEBROOK LANE, HARMONY, NC 28634

LOCATION US 21 N TR MT. BETHEL, TR FOUR J ANDREWS, TL HANNA SUE, 2ND LOT ON RIGHT

SUBDIVISION ROCK GATE EST BLOCK / SECTION LOT 6 LOT AREA LIMITED SITE CLASS PS DESIGN FLOW 360 L.T.A.R. 0.30 GPD/FT

Septic Tank: 1000 Gallons; STB 1012 Date 10-20-99
Pump Tank: Gallons; PT Date
Pump Make: Model Serial No.
Nitrification Field: No Fields 1 Square Feet 60 TO 120 Linear Feet 300'+
No Lines FIVE Trench Width 36" Max Trench Bottom Depth 30" Gravel Depth SAND 6"

☒ New System ☐ Repair System Type: I, II, III, IV, V, VI
System Description: 25% REDUCTION SYSTEM
Repair System Description: 25% REDUCTION PUMP
Maintenance Agreement Required: ☐ Yes ☒ No
☐ Slab ☒ Crawl Space ☐ Basement w/plumbing ☐ Basement wo/plumbing


☐ House/Mod. Home No. Bedrooms 3
☐ Mobile Home No. Bathrooms 2
☐ Business No. Employees
☐ Other

Water Supply: ☐ Individual ☒ Public ☐ Community


Comments:/Conditions: INSTALL 25% REDUCTION SYSTEM USING FIFTY (50) CHAMBERS OR THIRTY (30) HDS SECTIONS

Comments:/Conditions: SEPTIC TANK WITH RISERS INSTALLED USING "POLYLOK" TEE

INITIAL SITE SKETCH

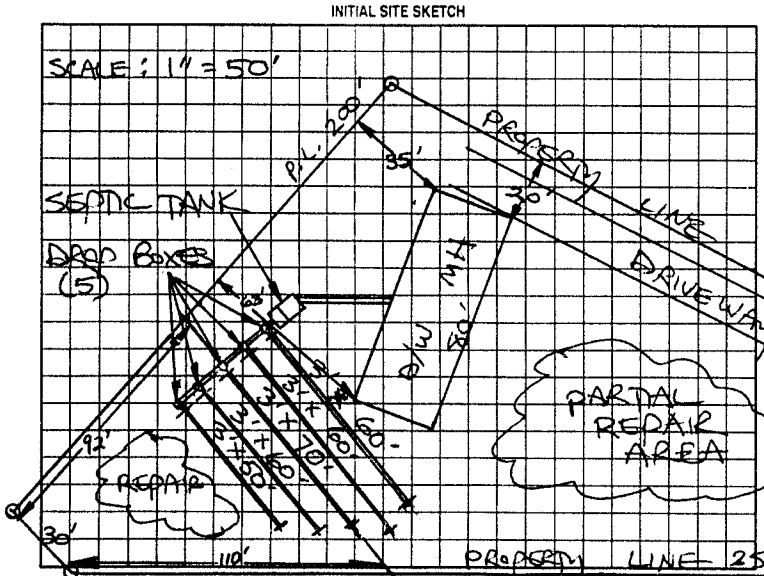

AS BUILT SKETCH

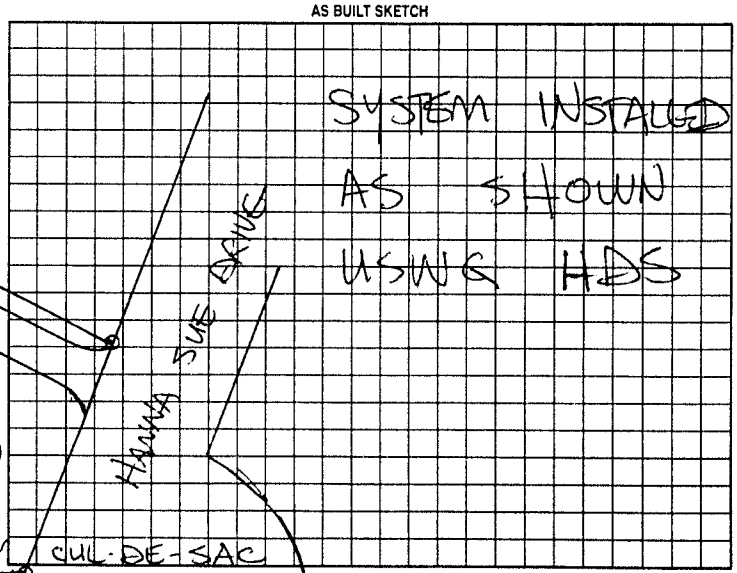

Permit can be suspended or revoked if any false information is supplied toward securing the permit/any unauthorized changes are made to the site/any unauthorized changes are made in the installation of the system. Improvement Permit with plat valid without expiration. Improvement Permit with site plan valid for sixty months. Authorization to Construct is valid for a period equal to that of Improvement Permit – not to exceed sixty months.

Signed: Stephen J. Udzinski date 11-29-99 Installed by: A-1 BACKHOE

Improvement Permit by: STEVE HEDRICK date 11-29-99 Operation Permit by: STEVE HEDRICK date 11-30-99

Authorization to Construct by: STEVE HEDRICK date 11-29-99 Existing System Inspection by: date

HEALTH DEPT. COPY: WHITE OWNER COPY (FINAL): YELLOW OWNER COPY (INITIAL): PINK