FAST TRACK PERMIT

IREDELL COUNTY HEALTH DEPARTMENT

STATESVILLE 704-878-5305 (C) MOORESVILLE 704-664-5281

IMPROVEMENT PERMIT / AUTHORIZATION TO CONSTRUCT / OPERATION PERMIT / EXISTING SYSTEM INSPECTION

PERMIT# 127806 PIN# 4778-79-4762 DATE 4-22-05

OWNER OR CONTRACTOR FLEETWOOD HOMES of STATESVILLE PHONE: Business 704-872-0179 Home

ADDRESS 1270 NORTH SIDE DRIVE, STATESVILLE NC 28677

LOCATION US 21 NORTH, TR BETHEL RD, TR FOUR ANDREWS DR, TR SUE ANDY COURT, LOT ON RIGHT

SUBDIVISION ROCK GATE EST. BLOCK / SECTION I LOT 58 LOT AREA 0.579 ACRE SITE CLASS. PS DESIGN FLOW 360 L.T.A.R. 0.30 GPD/FT

Septic Tank: 1000 Gallons; STB 760 Date 11-30-04

Pump Tank: _____ Gallons; PT _____ Date _____

Pump Make: _____ Model _____ Serial No. _____

Nitrification Field: No Fields 1 Square Feet EQ. TO 1200 Linear Feet 300

No Lines FOUR Trench Width 36" Max Trench Bottom Depth 36" Gravel Depth N/A

☑ New System ☐ Repair System Type: I, II, (III), IV, V, VI

System Description: 25% REDUCTION, GRAVITY

Repair System Description: 25% REDUCTION, PUMP

Maintenance Agreement Required: ☐ Yes ☑ No

☐ House/Mod. Home ☑ Mobile Home ☐ Business ☐ Other

No. Bedrooms 3 No. Bathrooms ____ No. Employees ____

☐ Slab ☑ Crawl Space ☐ Basement w/plumbing ☐ Basement wo/plumbing

Water Supply: ☐ Individual ☑ Public ☐ Community

Comments:/Conditions:

Comments:/Conditions: SEPTIC TANK WITH MARKER INSTALLED "SURE RED "POLYLOK" FILTER

INITIAL SITE SKETCH

SEE ATTACHED FAST TRACK SITE PLAN AND SPECIFICATION SHEET BY WENDELL OVERBY PROJECT NUMBER 5-1543s2

AS BUILT SKETCH

SYSTEM INSTALLED ACCORDING TO INITAL SITE SKETCH


Permit can be suspended or revoked if any false information is supplied toward securing the permit/any unauthorized changes are made to the site/any unauthorized changes are made in the installation of the system. Improvement Permit with plat valid without expiration. Improvement Permit with site plan valid for sixty months. Authorization to Construct is valid for a period equal to that of Improvement Permit – not to exceed sixty months.

Signed: _____ date 4/22/05 Installed by: POOR BOY LANDSCAPING & SEPTIC

Improvement Permit by: STEVE HEDRICK date 4-22-05 Operation Permit by: STEVE HEDRICK date 4-26-05

Authorization to Construct by: STEVE HEDRICK date 4-22-05 Existing System Inspection by: _____ date _____

HEALTH DEPT. COPY: WHITE OWNER COPY (FINAL): YELLOW OWNER COPY (INITIAL): PINK

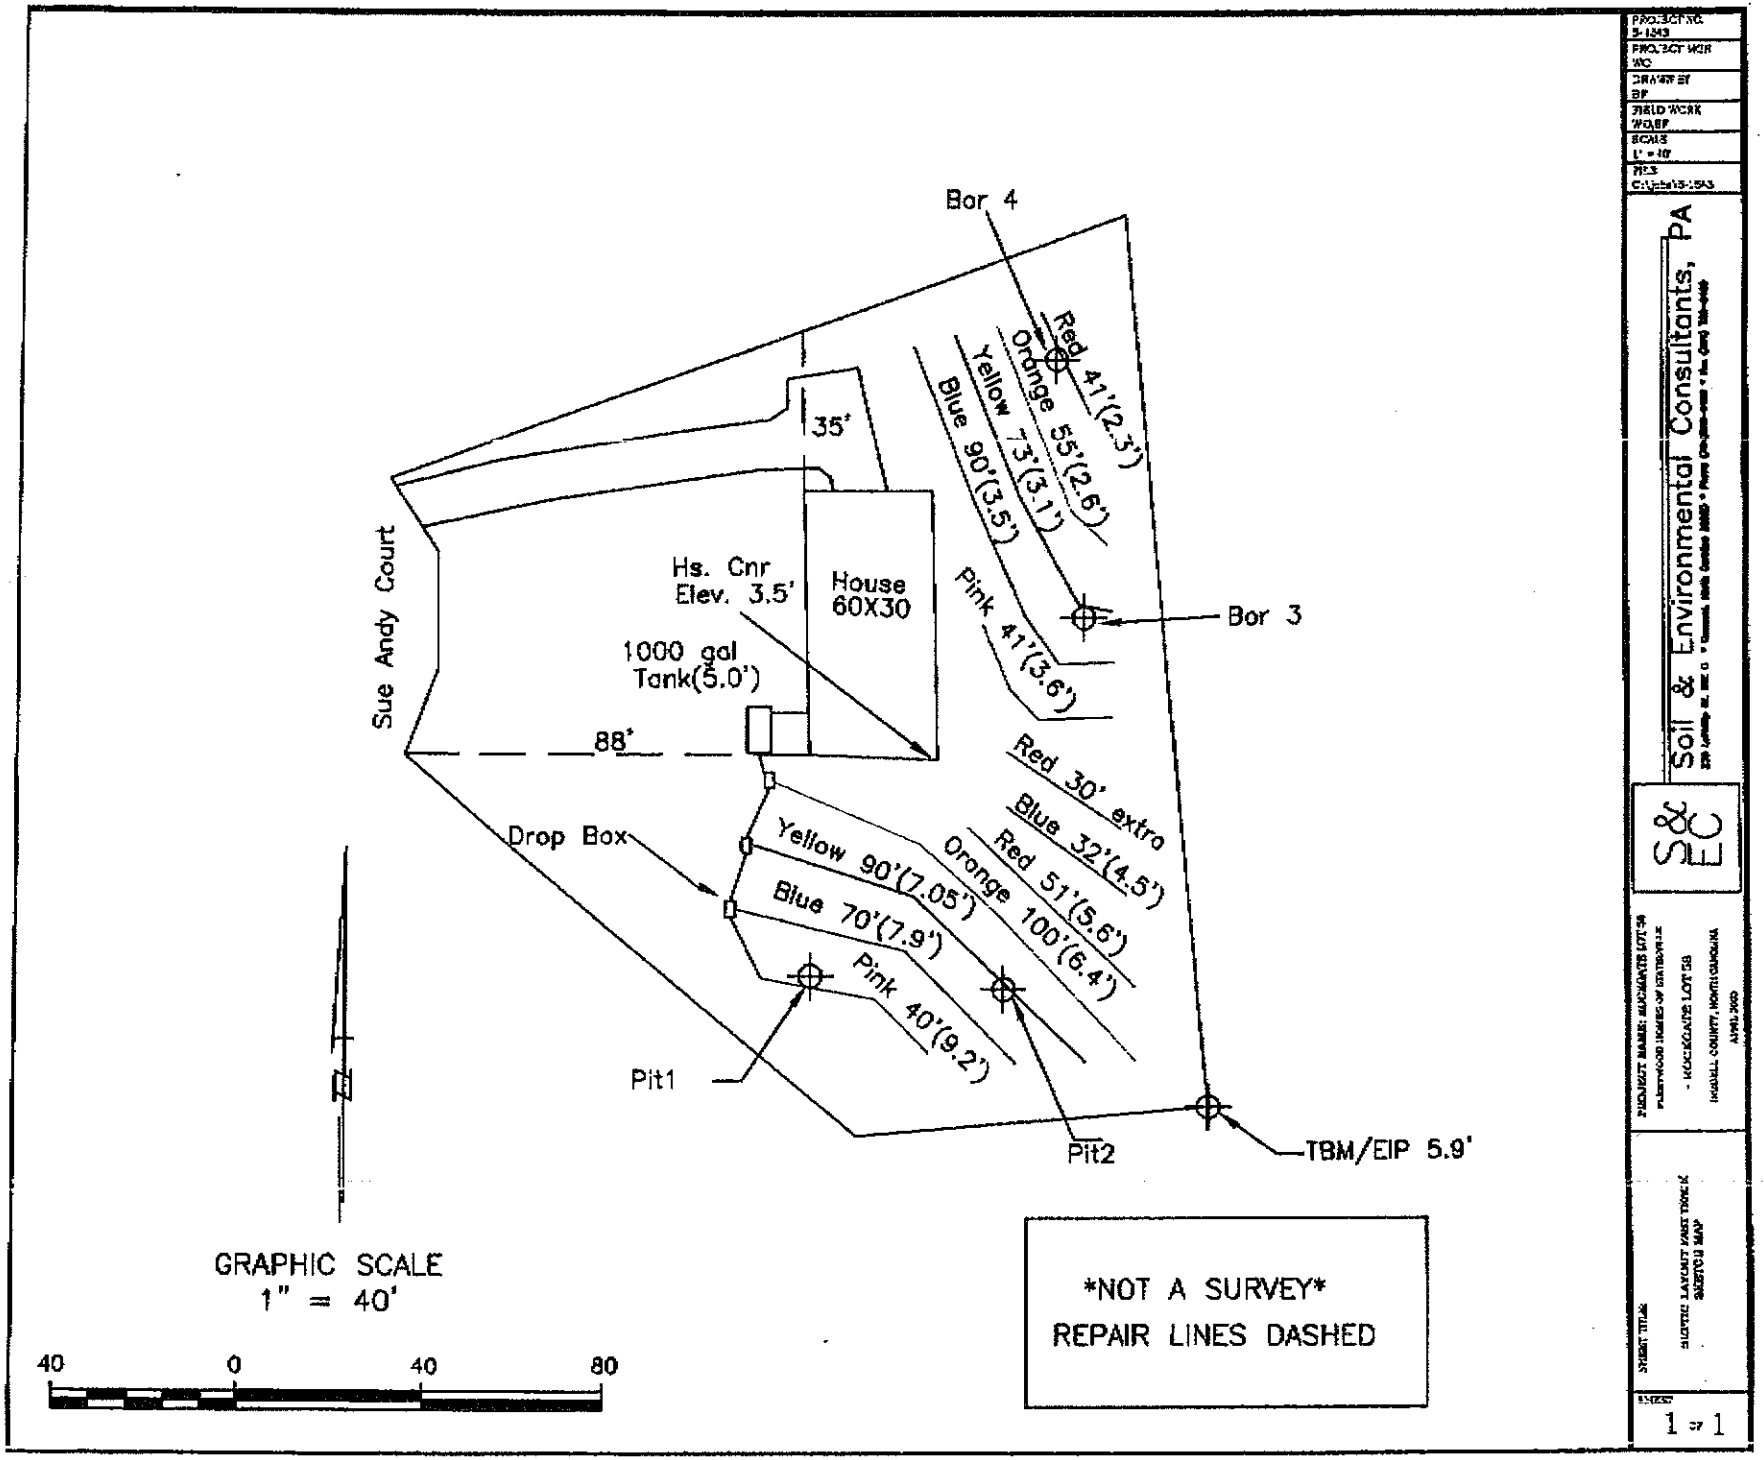

04/21/2005 12:18 7047209406 S AND EC PAGE 03

ROCKGATE LOT 58

Project No. 5-1543s2

Layout for 3 Bedroom Home

LINE #	FLAG COLOR	BS	HI	FS	ELEVATION	FLAGGED LINE LENGTH
TBM		5.9			100.0	
INSTR. 1			105.9			
			SYSTEM			
1	Blue			4.50	101.4	32
2	Red			5.60	100.3	51
3	Orange			6.40	99.5	95
4	Yellow			7.05	98.9	90
5	Blue			7.90	98.0	76
6	Pink			9.20	96.7	50
					Total	**394**
			Repair			
1	Red			2.30	104.5	41
2	Orange			2.60	104.3	55
3	Yellow			3.10	102.2	73
4	Blue			3.50	102.0	90
5	Pink			3.60	101.3	41
6	Red			4.20	100.1	30
					Total	**330**

* System	LINE LENGTH	LTAR GPD/FT^2	SYSTEM TYPE	TRENCH BOTTOM	INNOVATIVE TYPE	DISTRIBUTN
	394	0.30	III	36"	EZFLO	Drop Box
Repair	300	0.3	III	36"	EZFLO	P. Manifold

Notes:

** TBM of system located at back lot stake

**TBM is assumed to be 100'

**All measures in feet

**Nitrification lines are demonstrated on contour via colored pin flags

**BS and FS indicate rod readings