BRIAN LANTZ

IREDELL COUNTY HEALTH DEPARTMENT

STATESVILLE 704-878-5305 MOORESVILLE 704-664-5281

IMPROVEMENT PERMIT / AUTHORIZATION TO CONSTRUCT / OPERATION PERMIT / EXISTING SYSTEM INSPECTION

PERMIT# 102672 PIN# 4778-79-4848 DATE 10-23-01

OWNER OR CONTRACTOR ANDREW BROWN III PHONE: Business (704) 902-4636 Home

ADDRESS 85 MOUNTAIN VIEW RD, STATESVILLE NC 28677

LOCATION US 21 N TR MT. BETHEL RD, TR FOUR ANDREWS DR, TR SHE ANAY COURT, LOT ON CUL-DE-SAC

SUBDIVISION ROCK GATE' BLOCK / SECTION LOT 57 LOT AREA 0.87 ACRE SITE CLASS P3 DESIGN FLOW 360 L.T.A.R. 0.25 GPD/FT²

Septic Tank: 1000 Gallons: STB 760 Date 8-26-01
Pump Tank: Gallons: PT Date
Pump Make: Model Serial No
Nitrification Field: No Fields 1 Square Feet 1440 Linear Feet 480
No Lines TEN Trench Width 36" Max Trench Bottom Depth 36" Gravel Depth 12"

☑ New System ☐ Repair System Type: I II III IV V VI
System Description: CONVENTIONAL, GRAVITY
Repair System Description: CONV., PUMP-FED
Maintenance Agreement Required: ☐ Yes ☑ No

☐ House/Mod. Home ☑ Mobile Home ☐ Business ☐ Other
No. Bedrooms 3 No. Bathrooms 2 No. Employees


☐ Slab ☑ Crawl Space ☐ Basement w/plumbing ☐ Basement wo/plumbing

Water Supply: ☐ Individual ☑ Public ☐ Community

Comments/Conditions: USE ONE FLOW DIVIDER TEE TO SPLIT EFFLUENT INTO TWO SETS OF LINES 240' EACH, ONE SET OF FOUR 60' WITH 3 DROP BOXES & ONE SET OF SIX 40' WITH 1 FLOW DIVIDER & 4 DROP BOXES

Comments/Conditions: SEPTIC TANK WITH MARKER INSTALLED USING "ZABEL" FILTER

INITIAL SITE SKETCH

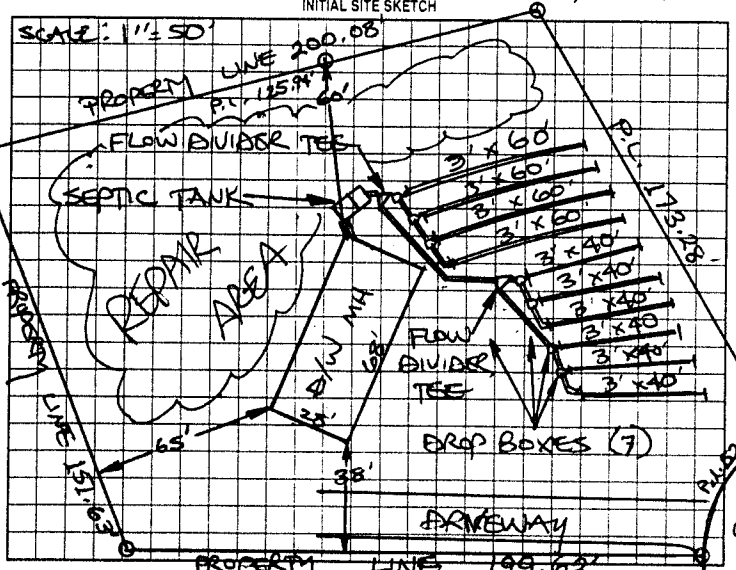

AS BUILT SKETCH

SYSTEM INSTALLED ACCORDING TO INITAL SITE SKETCH

Permit can be suspended or revoked if any false information is supplied toward securing the permit; any unauthorized changes are made to the site; any unauthorized changes are made in the installation of the system. Improvement Permit with plat valid without expiration. Improvement Permit with site plan valid for sixty months. Authorization to Construct is valid for a period equal to that of Improvement Permit – not to exceed sixty months.

Signed: _____ date 10-23-01 Installed by: BRENT GALLIHER

Improvement Permit by: STEVE HEDRICK date 10-23-01 Operation Permit by: STEVE HEDRICK date 11-15-01

Authorization to Construct by: STEVE HEDRICK date 10-23-01 Existing System Inspection by: _____ date _____

HEALTH DEPT. COPY WHITE OWNER COPY (FINAL) YELLOW OWNER COPY (INITIAL) PINK