IREDELL COUNTY HEALTH DEPARTMENT

STATESVILLE 704-878-5305 (I) MOORESVILLE 704-664-5281

IMPROVEMENT PERMIT / AUTHORIZATION TO CONSTRUCT / OPERATION PERMIT / EXISTING SYSTEM INSPECTION

(L)

PERMIT# 108773 PIN# 4778-79-6235 DATE 10-2-02

OWNER OR CONTRACTOR BOB HADEN PHONE: Business Home 704-872-0227

ADDRESS P.O. Box 1651 STATESVILLE NC 28687

LOCATION US 21 N, TR MT. BETHEL RD, TR FOUR ANDREWS, TL HANNAH SUE CT, 1ST ON LEFT

SUBDIVISION ROCKGATE BLOCK / SECTION 1 LOT 2 LOT AREA 0.602 AC SITE CLASS PS DESIGN FLOW 360 L.T.A.R. 0.30 GPD/FT²

Septic Tank: 1000 Gallons; STB 1012 Date 9-16-02

Pump Tank: Gallons; PT Date

Pump Make: Model Serial No.

Nitrification Field: No Fields 1 Square Feet 1200 Linear Feet 400

No Lines THREE Trench Width 36" Max Trench Bottom Depth 36" Gravel Depth 12"

☑ New System ☐ Repair System Type: I (II) III, IV, V, VI

System Description: CONVENTIONAL GRAVITY

Repair System Description: 25% REDUCTION, GRAVITY

Maintenance Agreement Required: ☐ Yes ☑ No

☐ House/Mod. Home ☑ Mobile Home ☐ Business ☐ Other

No. Bedrooms 3 No. Bathrooms 2 No. Employees


☐ Slab ☑ Crawl Space ☐ Basement w/plumbing ☐ Basement wo/plumbing

Water Supply: ☑ Individual ☑ Public ☐ Community


Comments:/Conditions:

Comments:/Conditions: TUFTITE FILTER + MARKER INSTALLED AS DRAWN, END OF TWO ARE 15' OFF EMBANKMENT CUT. DO NOT GRADE ANYMORE OR SEPTIC WILL NOT BE MAINTAINED. SYSTEM INSTALLED AS DRAWN

INITIAL SITE SKETCH SCALE: 1" = 40'

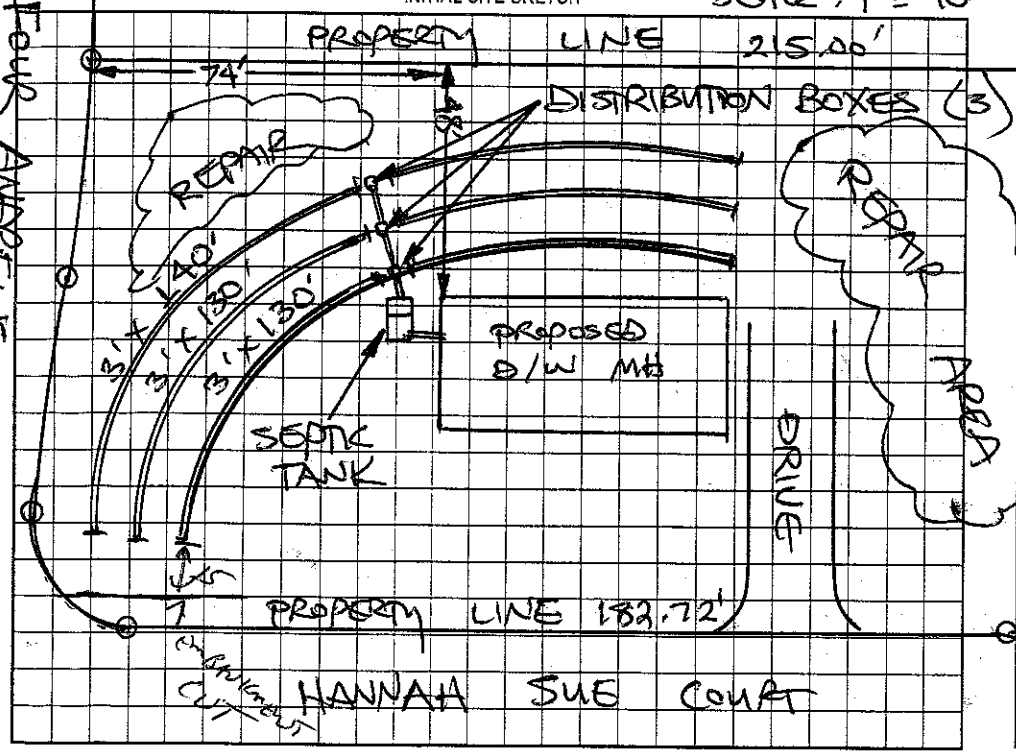

AS BUILT SKETCH PLUGGED, HOUSE NOT PERMANTLY SETUP AT TIME OF CHECK, USED DIST. BOXES AS DRAWN WITH SPEED LEVELERS

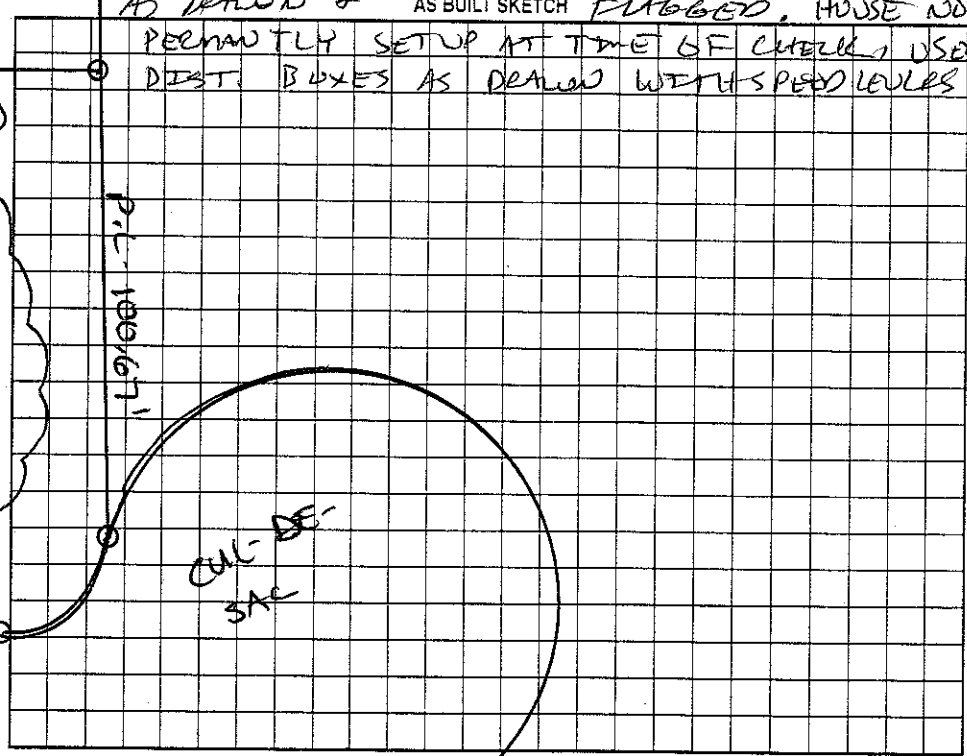

Permit can be suspended or revoked if any false information is supplied toward securing the permit/any unauthorized changes are made to the site/any unauthorized changes are made in the installation of the system. Improvement Permit with plat valid without expiration. Improvement Permit with site plan valid for sixty months. Authorization to Construct is valid for a period equal to that of Improvement Permit – not to exceed sixty months.

Signed: [signature] date 10-2-02 Installed by: CRAIG THOMPSON

Improvement Permit by: STEVE HEDRICK date 10.2.02 Operation Permit by: [signature] date 10-29-03

Authorization to Construct by: STEVE HEDRICK date 10.2.02 Existing System Inspection by: date

HEALTH DEPT. COPY: WHITE OWNER COPY (FINAL): YELLOW OWNER COPY (INITIAL): PINK