300 - 330

IREDELL COUNTY HEALTH DEPARTMENT

STATESVILLE 704-878-5305 MOORESVILLE 704-664-5281

IMPROVEMENT PERMIT / AUTHORIZATION TO CONSTRUCT / OPERATION PERMIT / EXISTING SYSTEM INSPECTION

PERMIT# 82230 PIN# 4778794377 DATE 7-8-99

OWNER OR CONTRACTOR Andy Brown PHONE: Business 8720227 Home

ADDRESS PO Box 1651 Statesville N.C.

LOCATION Old Mocksville Turn Mt Bethel 1/2 mi left

SUBDIVISION Rock Gate BLOCK / SECTION LOT 64 LOT AREA .6 acres SITE CLASS PS DESIGN FLOW 360 L.T.A.R. .3

Septic Tank: 1000 Gallons; STB 1012 Date 7/7/00
Pump Tank: Gallons; PT Date
Pump Make: Model Serial No.
Nitrification Field: No Fields 1 Square Feet 1200 Linear Feet 400
No Lines 4 Trench Width 36" Max Trench Bottom Depth 36" Gravel Depth 12"

☑ New System ☐ Repair System Type: I ☑ II. IV. V. VI
System Description: Conv. Gravity
Repair System Description:
Maintenance Agreement Required: ☐ Yes ☑ No


☐ House/Mod. Home No. Bedrooms 3
☒ Mobile Home No. Bathrooms 2
☐ Business No. Employees
☐ Other
☐ Slab ☑ Crawl Space ☐ Basement w/plumbing ☐ Basement wo/plumbing

Water Supply: ☐ Individual ☒ Public ☐ Community

Comments/Conditions: CHANGED TO SC 50' w/ DISTRIB. BOX.

Comments/Conditions: PUMP NOT INSTALLED 11-28-00
1ST LEVEL CHECKED ONLY - 11/22/00 CBC
Checked rest of system 11-28-00

INITIAL SITE SKETCH

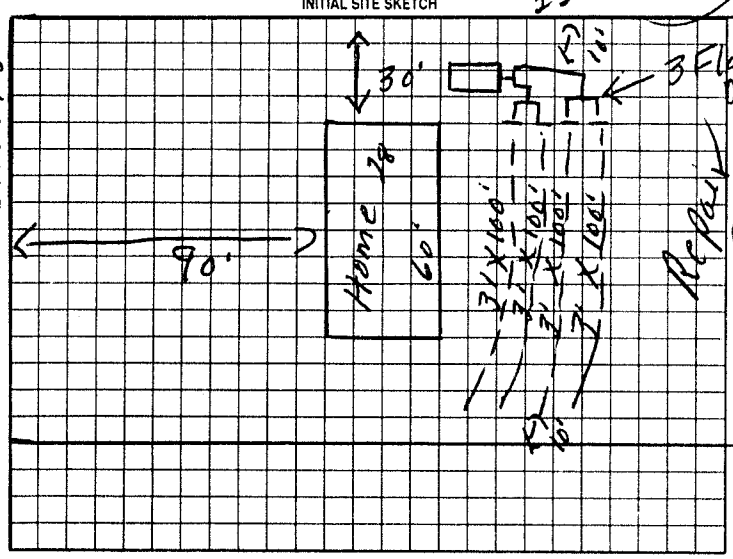

AS BUILT SKETCH

Permit can be suspended or revoked if any false information is supplied toward securing the permit/any unauthorized changes are made to the site/any unauthorized changes are made in the installation of the system. Improvement Permit with plat valid without expiration. Improvement Permit with site plan valid for sixty months. Authorization to Construct is valid for a period equal to that of Improvement Permit – not to exceed sixty months.

Signed: Jack Clanton date 7/14/9 Installed by: Thompson

Improvement Permit by: P.C. Moore date 7-8-99 Operation Permit by: [illegible] date 11-28-00

Authorization to Construct by: P.C. Moore date 7-8-99 Existing System Inspection by: date

HEALTH DEPT COPY: WHITE OWNER COPY (FINAL): YELLOW OWNER COPY (INITIAL): PINK