IREDELL COUNTY HEALTH DEPARTMENT

STATESVILLE 704-878-5305 MOORESVILLE 704-664-5281

IMPROVEMENT PERMIT / AUTHORIZATION TO CONSTRUCT / OPERATION PERMIT / EXISTING SYSTEM INSPECTION

PERMIT# 125906 PIN# 4778-79-6936 DATE 1-24-05

OWNER OR CONTRACTOR FLEETWOOD HOMES PHONE: Business (704) 872-0179 Home

ADDRESS 1270 NORTHSIDE DRIVE STATESVILLE NC 28625

LOCATION US 21N TR MT. BETHEL RD. GO ~2 MILES LOT #66 ON RIGHT

SUBDIVISION ROCKGATE ESTS. BLOCK / SECTION I LOT 66 LOT AREA 0.697 SITE CLASS. P5 DESIGN FLOW 360 L.T.A.R. 0.30 gpd/ft²

Septic Tank: 1000 Gallons; STB 760 Date 10-30-04
Pump Tank: Gallons; PT Date
Pump Make: Model Serial No.
Nitrification Field: No Fields 1 Square Feet 1200 Linear Feet 400
No Lines 4 Trench Width 36" Max Trench Bottom Depth 24" Gravel Depth 12"

☑ New System ☐ Repair System Type: I, (II), III, IV, V, VI
System Description: CONVENTIONAL GRAVITY
Repair System Description: PUMP CONVENTIONAL
Maintenance Agreement Required: ☐ Yes ☐ No

☑ House/Mod. Home No. Bedrooms 3
☐ Mobile Home No. Bathrooms
☐ Business No. Employees
☐ Other


☐ Slab ☑ Crawl Space ☐ Basement w/plumbing ☐ Basement wo/plumbing

Water Supply: ☐ Individual ☑ Public ☐ Community

Comments:/Conditions ① INSTALL LINES 24" ON CONTOUR ② ROUTE PUBLIC WATER LINE TO A SEPARATION OF AT LEAST 10' FROM SYSTEM ③ MAINTAIN ALL OTHER SETBACKS ④ HOME MUST BE IN PLACE BEFORE

Comments:/Conditions ⑤ RED "POLYLOK" FILTER USED IN TANK ⑥ NO RISER – TANK <6" COVER ⑦ #5 STONE SYSTEM INSTALLED OR PERMIT WILL BE VOID

INITIAL SITE SKETCH

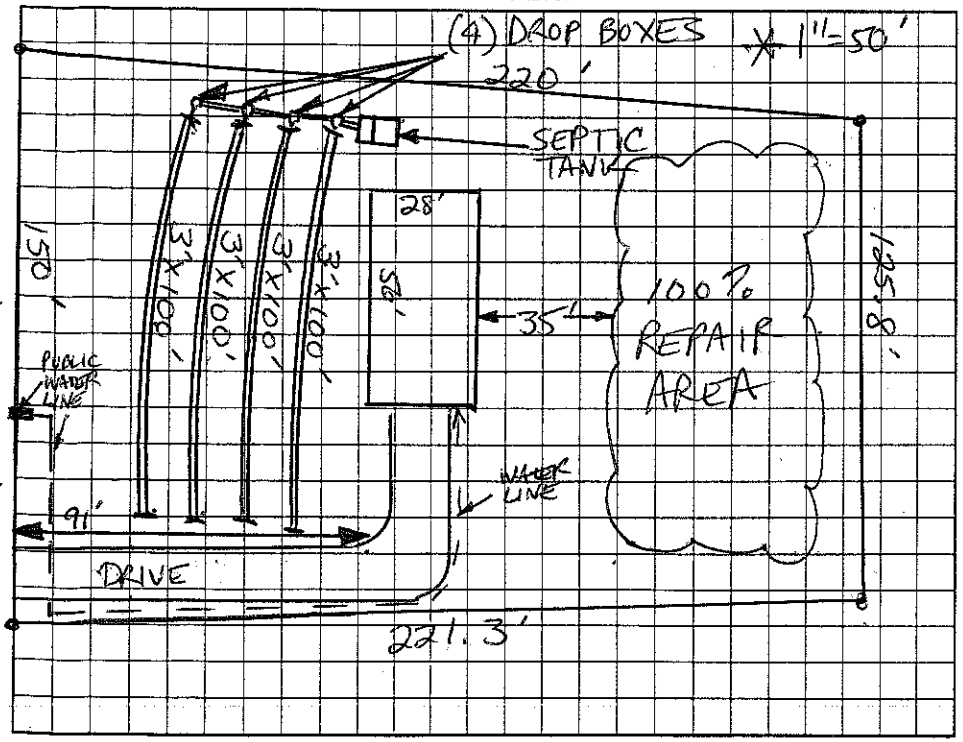

AS BUILT SKETCH

* SYSTEM INSTALLED ACCORDING TO SKETCH

Permit can be suspended or revoked if any false information is supplied toward securing the permit/any unauthorized changes are made to the site/any unauthorized changes are made in the installation of the system. Improvement Permit with plat valid without expiration. Improvement Permit with site plan valid for sixty months. Authorization to Construct is valid for a period equal to that of Improvement Permit – not to exceed sixty months.

Signed: date 1-25-05 Installed by: ABEE'S GRADING

Improvement Permit by: LSS date 1-24-05 Operation Permit by: LSS date 1-26-05

Authorization to Construct by: LSS date 1-24-05 Existing System Inspection by: date

HEALTH DEPT. COPY: WHITE OWNER COPY (FINAL): YELLOW OWNER COPY (INITIAL): PINK