IREDELL COUNTY HEALTH DEPARTMENT

STATESVILLE 704-878-5305 MOORESVILLE 704-664-5281

IMPROVEMENT PERMIT / AUTHORIZATION TO CONSTRUCT / OPERATION PERMIT / EXISTING SYSTEM INSPECTION

PERMIT# 82226 PIN# 4778794377 DATE 7-9-99

OWNER OR CONTRACTOR Andy Brown PHONE: Business 872 0227 Home

ADDRESS PO Box 1651 Statesville

LOCATION Old Mocksville Rd Turn mt Bethel Rd 1/2 mi left

SUBDIVISION Rock Gate BLOCK / SECTION LOT 1 LOT AREA 1.6 acres SITE CLASS PS DESIGN FLOW 360 L.T.A.R. .3

Septic Tank: 1000 Gallons; STB 794 Date 9-27-00
Pump Tank: Gallons; PT Date
Pump Make: Model Serial No.
Nitrification Field: No Fields 1 Square Feet 1200 Linear Feet 400
No Lines 4 Trench Width 36" Max Trench Bottom Depth 36" Gravel Depth 12"

New System Repair System Type: I II III IV V VI
System Description: Conv. Gravity
Repair System Description: Pump To
Maintenance Agreement Required: Yes No 257 Rock
Slab Crawl Space Basement w/plumbing Basement wo/plumbing


House/Mod Home No. Bedrooms 3
Mobile Home No. Bathrooms 2
Business No. Employees
Other

Water Supply: Individual Public Community


Comments/Conditions:

Comments/Conditions: ① SEPTIC TANK WITH MARKER INSTALLED USING "ZABEL" FILTER
② SYSTEM ALTERED AS SHOWN BELOW WITH PRIOR HEALTH DEPT. APPROVAL.

INITIAL SITE SKETCH

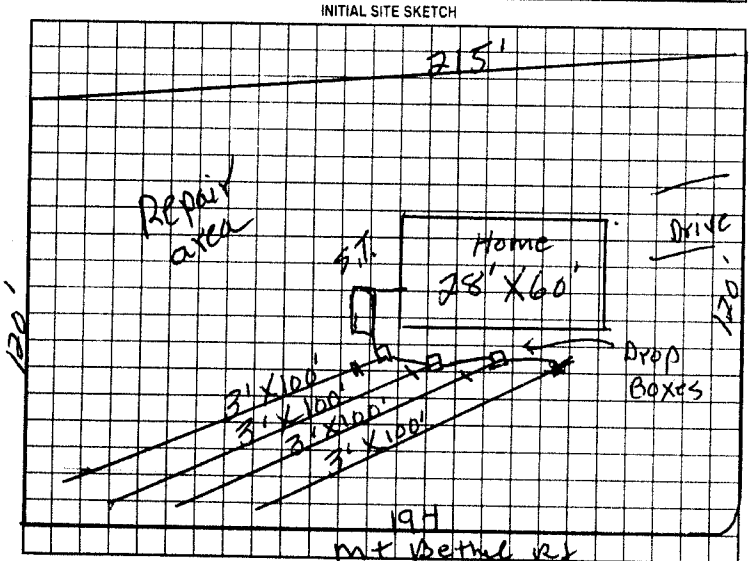

AS BUILT SKETCH

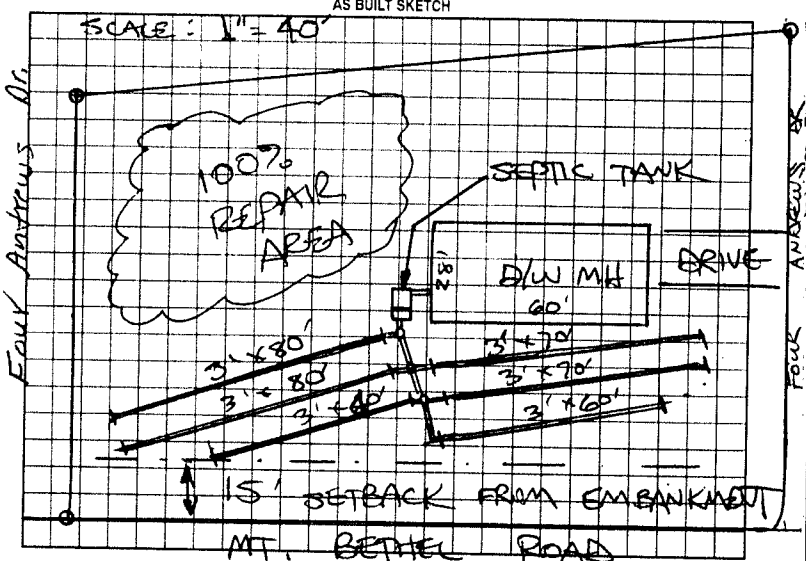

Permit can be suspended or revoked if any false information is supplied toward securing the permit/any unauthorized changes are made to the site/any unauthorized changes are made in the installation of the system. Improvement Permit with plat valid without expiration. Improvement Permit with site plan valid for sixty months. Authorization to Construct is valid for a period equal to that of Improvement Permit – not to exceed sixty months.

Signed: Jack Clanton date 7/14/9

Improvement Permit by: P. C. Moore date 7-9-99

Authorization to Construct by: P. C. Moore date 7-9-99

Installed by: ANDY DANIELS

Operation Permit by: STEVE HEDRICK date 11-3-00

Existing System Inspection by: date

HEALTH DEPT COPY: WHITE OWNER COPY (FINAL) YELLOW OWNER COPY (INITIAL) PINK