IREDELL COUNTY HEALTH DEPARTMENT

STATESVILLE 704-878-5305 (c1) MOORESVILLE 704-664-5281

IMPROVEMENT PERMIT / AUTHORIZATION TO CONSTRUCT / OPERATION PERMIT / EXISTING SYSTEM INSPECTION

(a)

PERMIT# 108296 PIN# 4778-87-2807 DATE 9-3-2002

OWNER OR CONTRACTOR FLEETWOOD HOMES of STATESVILLE PHONE: Business 704-872-0179 Home 704-546-5597

ADDRESS 1270 NORTHSIDE DRIVE, STATESVILLE, NC 28677

LOCATION US 21 N, TR BETHEL ROAD, TL THOMAS ROCK DR, TR GARRETT LANE, 1ST MH ON RIGHT

SUBDIVISION BETHEL PARK BLOCK / SECTION ____ LOT 3 LOT AREA 0.720 ACRE SITE CLASS PS DESIGN FLOW 360 L.T.A.R. EXISTING 0.35 GPD/FT²

Septic Tank: 1000 Gallons: STB 1007 Date 9-2-02
Pump Tank: ____ Gallons: PT ____ Date ____
Pump Make: ____ Model ____ Serial No ____
Nitrification Field: No Fields 1 Square Feet 345 Linear Feet 115
No Lines TWO Trench Width 36" Max Trench Bottom Depth 36" Gravel Depth 12"

☑ New System ☐ Repair System Type: I II III IV V VI
System Description: CONVENTIONAL, GRAVITY
Repair System Description: CONVENTIONAL, PUMP
Maintenance Agreement Required: ☐ Yes ☑ No
☐ Slab ☑ Crawl Space ☐ Basement w/plumbing ☐ Basement wo/plumbing


☐ House/Mod Home No. Bedrooms 3
☑ Mobile Home No. Bathrooms 2
☐ Business No. Employees ____
☐ Other ____

Water Supply:
☑ Individual
☐ Public
☐ Community
WELL


Comments/Conditions: INSTALL NEW SEPTIC TANK AND LINES AT LOCATION SHOWN

Comments/Conditions: SEPTIC TANK WITH MARKER INSTALLED USING "POLYLOK" FILTER SYSTEM TIES INTO EXISTING SYSTEM THROUGH EXISTING SEPTIC TANK AS SHOWN

INITIAL SITE SKETCH

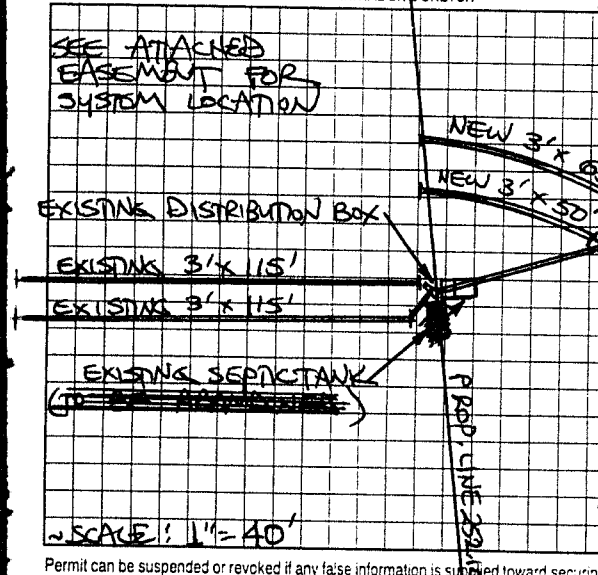

AS BUILT SKETCH

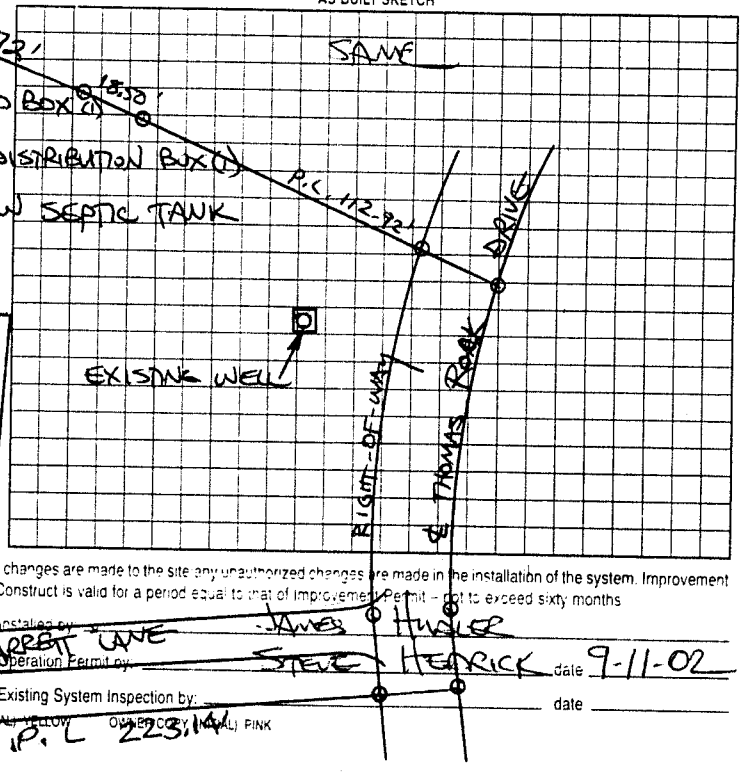

Permit can be suspended or revoked if any false information is supplied toward securing the permit any unauthorized changes are made to the site any unauthorized changes are made in the installation of the system. Improvement Permit with plat valid without expiration. Improvement Permit with site plan valid for sixty months. Authorization to Construct is valid for a period equal to that of Improvement Permit – not to exceed sixty months

Signed: Renee M. Pond

Improvement Permit by: STEVE HENDRICK date 9-3-02

Authorization to Construct by: STEVE HENDRICK date 9-3-02

Installed by: JAMES HUNTER

Operation Permit by: STEVE HENDRICK date 9-11-02

Existing System Inspection by: ____ date ____

HEALTH DEPT COPY WHITE OWNER COPY (FINAL) YELLOW OWNER COPY (INITIAL) PINK