IREDELL COUNTY HEALTH DEPARTMENT

STATESVILLE 704-878-5305 MOORESVILLE 704-664-5281

IMPROVEMENT PERMIT / CERTIFICATE OF COMPLETION / OPERATION PERMIT / EXISTING SYSTEM INSPECTION

PROPERTY DESCRIPTION NO. 21813 DATE 8-10-95 TAX MAP NO. 12E-1-A-3 Watershed: ☐ Yes ☒ No

OWNER OR CONTRACTOR GEORGE KISER PHONE: Business Home 546-5734

ADDRESS P.O. BOX 63, HARMONY NC 28634

LOCATION US 21 N TR BETHEL, TL THOMAS ROCK, 2ND MH ON RIGHT

SUBDIVISION BETHEL PARK BLOCK / SECTION LOT 3 LOT AREA 8 ACRES SITE CLASS PS DESIGN FLOW 240 L.T.A.R. 0.33

Septic Tank: 1000 Gallons; STB Date

Pump Tank: Gallons; PT Date

Pump Make: Model Serial No.

Nitrification Field: No Fields 1 Square Feet Linear Feet EXISTING

No Lines 2 Trench Width Max Trench Bottom Depth Gravel Depth 12"

☐ New System ☐ Repair System Type: I II III IV V VI

System Description: CONV. GRAVITY

Repair System Description: CONV. GRAVITY

Maintenance Agreement Required: ☐ Yes ☒ No

☐ Slab ☐ Crawl Space ☐ Basement w/plumbing ☐ Basement wo/plumbing

☐ House/Mod. Home No. Bedrooms 2

☒ Mobile Home No. Bathrooms 2

☐ Business No. Employees


☐ Other

Water Supply: ☒ Individual ☐ Community ☐ Public WELL


Comments:

Comments: ① KEEP MH MINIMUM 5' FROM SYSTEM.
② EXISTING MH TO BE REMOVED UPON OCCUPANCY ON PROPOSED MH

INITIAL SITE SKETCH

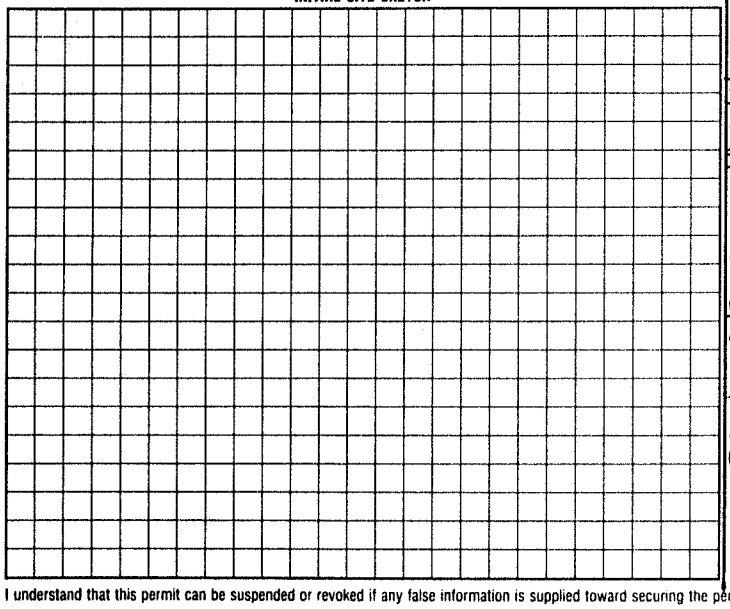

AS BUILT SKETCH

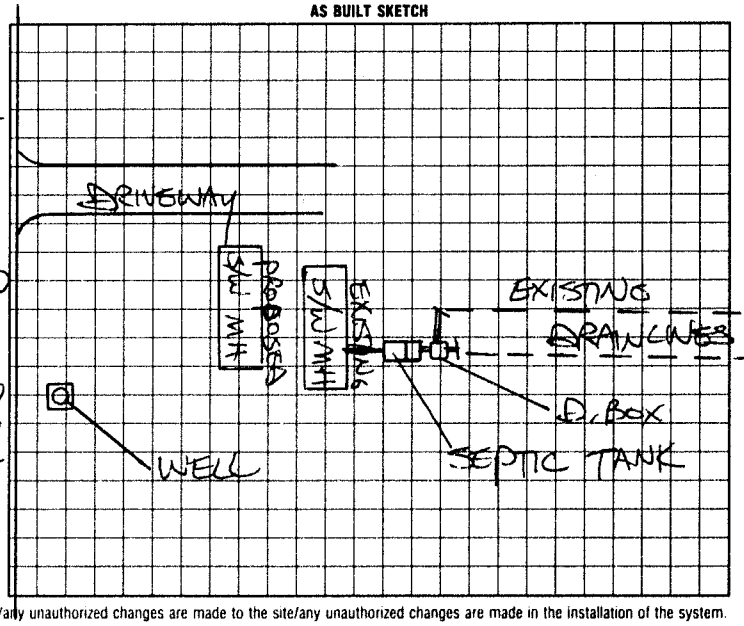

I understand that this permit can be suspended or revoked if any false information is supplied toward securing the permit/any unauthorized changes are made to the site/any unauthorized changes are made in the installation of the system.

Signed: Installed by:

Improvement Permit by: date Certificate of Completion by: date

Existing System Inspection by: STEVE HEDRICK date 8-10-95 Operation Permit by: date

HEALTH DEPT. COPY: WHITE INSPECTION COPY (FINAL): GREEN OWNER COPY (FINAL): YELLOW INSPECTION COPY (INITIAL): PINK OWNER COPY (INITIAL): GOLD