IREDELL COUNTY HEALTH DEPARTMENT

STATESVILLE 704-878-5305 MOORESVILLE 704-664-5281

IMPROVEMENT PERMIT / CERTIFICATE OF COMPLETION / OPERATION PERMIT / EXISTING SYSTEM INSPECTION

PROPERTY DESCRIPTION NO. 16529 DATE 6/21/93 TAX MAP NO. 12E-1-A-45

OWNER OR CONTRACTOR RANSOM GILLESPIE PHONE: Business _____ Home 539-4124

ADDRESS Rt. 1, UNION GROVE NC 28689

LOCATION US 21 N, TR BETHEL ROAD, ON (L) AT BETHEL PARK ENTRANCE

SUBDIVISION BETHEL PARK BLOCK / SECTION _____ LOT 45 LOT AREA 0.7 AC SITE CLASS. 05 L.T.A.R. 0.35 GPD/FT²

Water Supply: ☑ Individual ☐ Community ☐ Public WELL

Septic Tank: 1000 Gallons; STB 782 Date 3/17/93

Pump Tank: _____ Gallons; PT _____ Date _____

Nitrification Field: No Fields 1 Square Feet 1035 Linear Feet 345

No Lines 3 Trench Width 36" Trench Depth ≤ 36" Gravel Depth 12"

☑ New System ☐ Repair System Type: I, II, III, IV, V, VI

System Description: CONV, GRAVITY

Repair System Description: CONV, GRAVITY

Maintenance Agreement Required: ☐ Yes ☑ No

☐ House/Mod. Home ☑ Mobile Home D/W ☐ Business ☐ Other _____

No. Bedrooms 3 No. Bathrooms 2 No. Employees _____

Garbage Disposal: ☐ Yes ☑ No

Auto. Dishwasher: ☐ Yes ☐ No


Auto. Washing Machine: ☑ Yes ☐ No

Other _____


☐ Slab ☑ Crawl Space ☐ Basement w/plumbing ☐ Basement wo/plumbing

Comments ① KEEP SYSTEM MINIMUM 10' FROM PROPERTY LINE, 5' FROM MH, 50' FROM WELL ② INSTALL LINES ON CONTOUR, NO DEEPER THAN 36", 9' ON CENTER.

INITIAL SITE SKETCH

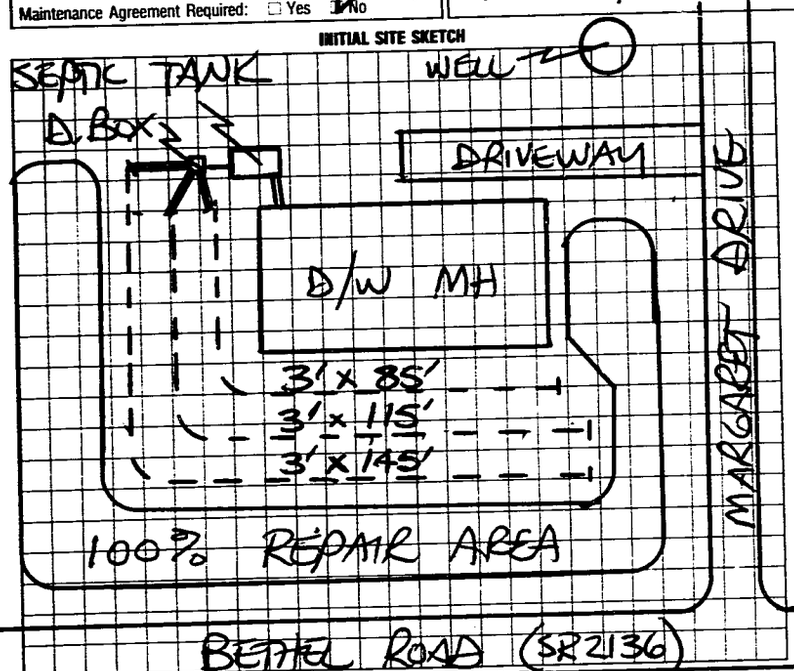

AS BUILT SKETCH

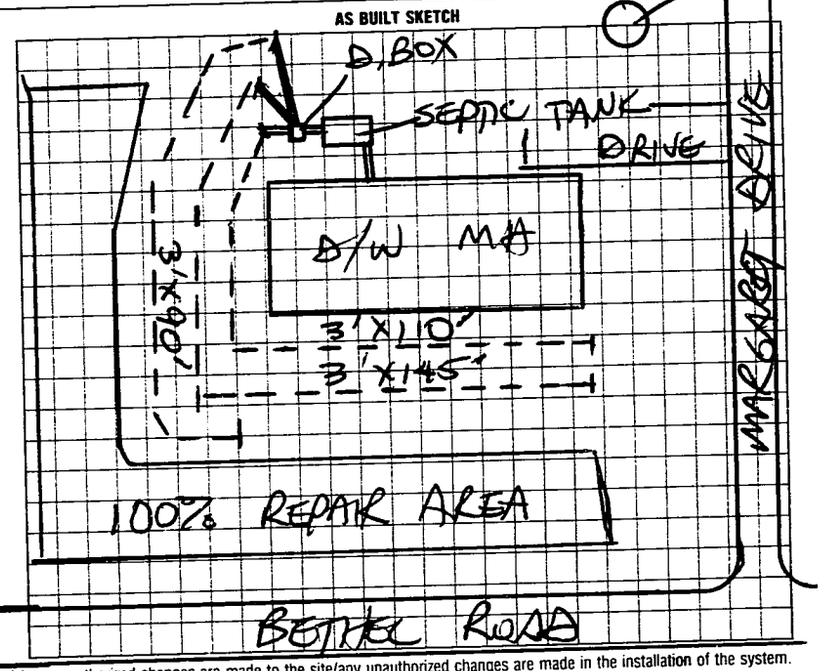

I understand that this permit can be suspended or revoked if any false information is supplied toward securing the permit/any unauthorized changes are made to the site/any unauthorized changes are made in the installation of the system. Improvement Permit is valid for 60 months from date of issuance.

Signed: X [signature] Improvement Permit by: STEVE HEDRICK date 6/21/93

Existing System Inspection by: _____ date _____

Installed by: A-1 BACKHOE Certificate of Completion by: STEVE HEDRICK date 7/14/93

Operation Permit by: _____ date _____

HEALTH DEPT. COPY: WHITE INSPECTION COPY (FINAL) GREEN OWNER COPY (FINAL): YELLOW INSPECTION COPY (INITIAL): PINK OWNER COPY (INITIAL): GOLD