IREDELL COUNTY HEALTH DEPARTMENT

STATESVILLE 704-878-5305 MOORESVILLE 704-664-5281

IMPROVEMENT PERMIT / AUTHORIZATION TO CONSTRUCT / OPERATION PERMIT / EXISTING SYSTEM INSPECTION

PERMIT# 100221 PIN# 4778 89 2757 DATE 5-22-01

OWNER OR CONTRACTOR KATHY BROWN PHONE: Business Home

ADDRESS 6580 ADAM RIGHT CR, CATAWBA, NC 28609

LOCATION US 21 NORTH, TR MT. BETHEL RD, LOT ON LEFT JUST PAST FOUR ANDREWS DRIVE

SUBDIVISION BLOCK / SECTION LOT LOT AREA 4.8 ACRES SITE CLASS PS DESIGN FLOW 360 L.T.A.R. 0.30 GPA/FT²

Septic Tank: 1000 Gallons; STB 821 Date 10-17-01
Pump Tank: Gallons; PT Date
Pump Make: Model Serial No
Nitrification Field: No Fields 1 Square Feet 1200 Linear Feet 400
No Lines FOUR Trench Width 36" Max Trench Bottom Depth 36" Gravel Depth 12"

☑ New System ☐ Repair System Type: I (II) III IV V VI
System Description: CONVENTIONAL GRAVITY
Repair System Description: CONV. GRAVITY
Maintenance Agreement Required: ☐ Yes ☑ No
☐ Slab ☐ Crawl Space ☐ Basement w/plumbing ☐ Basement wo/plumbing


☐ House/Mod. Home No. Bedrooms 3
☑ Mobile Home No. Bathrooms 2
☐ Business No. Employees
☐ Other

Water Supply: ☐ Individual ☑ Public ☐ Community


Comments/Conditions: CONSTRUCT SUBSURFACE INTERCEPT DRAINAGE DITCH AT LOCATION SHOWN BEGINNING 48 INCHES DEEP OUT TO DAYLIGHT

Comments/Conditions: ① SEPTIC TANK WITH MARKER INSTALLED USING "ZOELLER" FILTER ② LINE #3 INSTALLED SLIGHTLY OUT OF CONTOUR

INITIAL SITE SKETCH

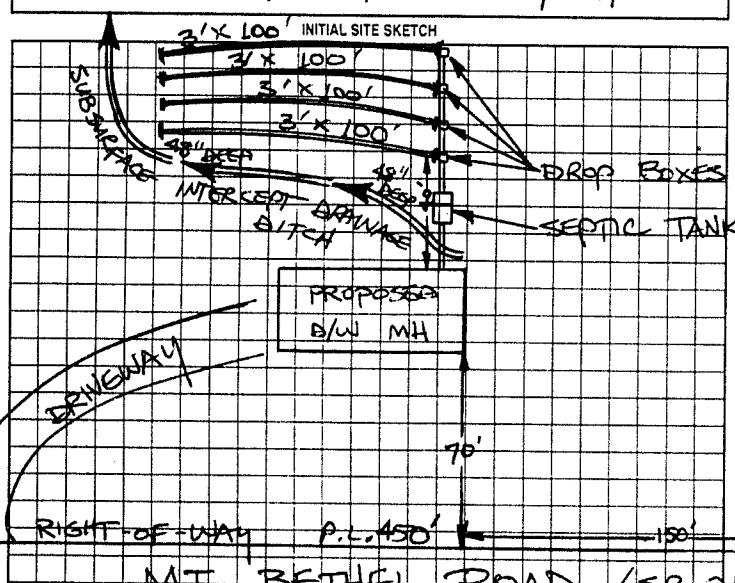

AS BUILT SKETCH

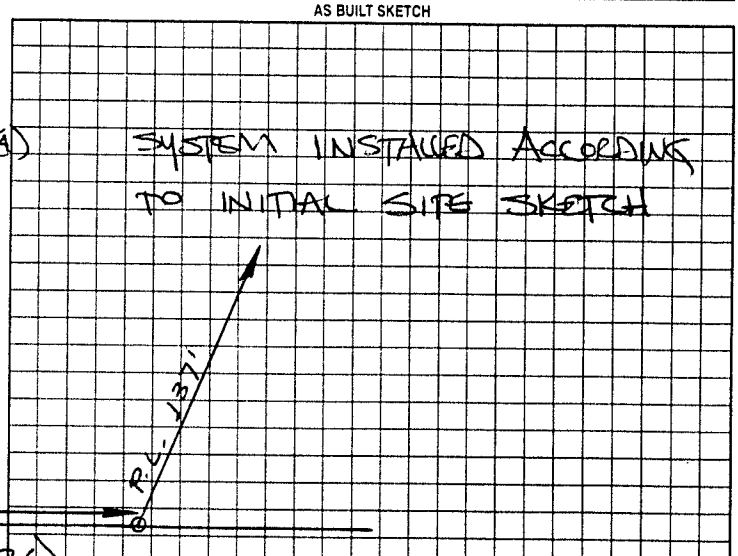

Permit can be suspended or revoked if any false information is supplied toward securing the permit/any unauthorized changes are made to the site/any unauthorized changes are made in the installation of the system. Improvement Permit with plat valid without expiration. Improvement Permit with site plan valid for sixty months. Authorization to Construct is valid for a period equal to that of Improvement Permit – not to exceed sixty months.

Signed: Neal Clark date 5-22-01 Installed by: CHERRYVILLE GRADING

Improvement Permit by: STEVE HEDRICK date 5-22-01 Operation Permit by: STEVE HEDRICK date 12-10-01

Authorization to Construct by: STEVE HEDRICK date 5-22-01 Existing System Inspection by: date

HEALTH DEPT COPY: WHITE OWNER COPY (FINAL): YELLOW OWNER COPY (INITIAL): PINK