IREDELL COUNTY HEALTH DEPARTMENT

THIS PERMIT VOIDS PREVIOUS ISSUED 2-25-98

STATESVILLE 704-878-5305 MOORESVILLE 704-664-5281

IMPROVEMENT PERMIT / AUTHORIZATION TO CONSTRUCT / OPERATION PERMIT / EXISTING SYSTEM INSPECTION

PERMIT# 071890 PIN# 4778 88 2258 DATE 5-18-99

OWNER OR CONTRACTOR OLDE TOWNE MH INC PHONE: Business 873-1481 Home

ADDRESS 2016 NORTHSIDE DRIVE, STATESVILLE, NC 28625

LOCATION US 21 N, TR BETHEL ROAD, TL THOMAS ROCK, TL WELLS LN, 2ND LOT ON LEFT

SUBDIVISION BETHEL PARK BLOCK / SECTION LOT 41 LOT AREA SITE CLASS. PS DESIGN FLOW 360 L.T.A.R. 0.30 GPD/FT²

Septic Tank: 1000 Gallons; STB 1012 Date 3-26-99
Pump Tank: Gallons; PT Date
Pump Make: Model Serial No.
Nitrification Field: No Fields 1 Square Feet 1200 Linear Feet
No Lines FIVE Trench Width 36" Max Trench Bottom Depth 36" Gravel Depth 12"

☑ New System ☐ Repair System Type: I (II) III IV V VI
System Description: CONVENTIONAL GRAVITY
Repair System Description: CONV. GRAVITY
Maintenance Agreement Required: ☐ Yes ☑ No


☐ House/Mod. Home ☑ Mobile Home ☐ Business ☐ Other
No. Bedrooms 3 No. Bathrooms 2 No. Employees
☐ Slab ☑ Crawl Space ☐ Basement w/plumbing ☐ Basement wo/plumbing

Water Supply: ☑ Individual ☐ Public ☐ Community
WELL


Comments/Conditions: KEEP SYSTEM MAXIMUM FEASIBLE DISTANCE (50') FROM WELLS

Comments/Conditions:

INITIAL SITE SKETCH

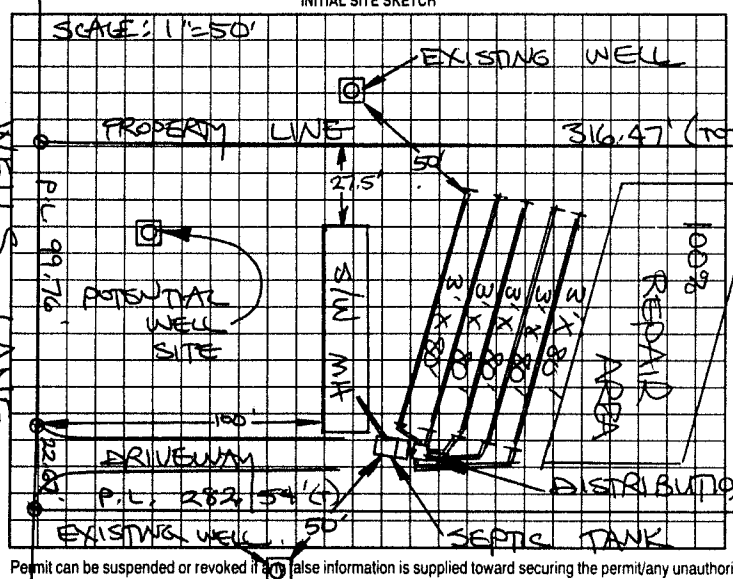

AS BUILT SKETCH

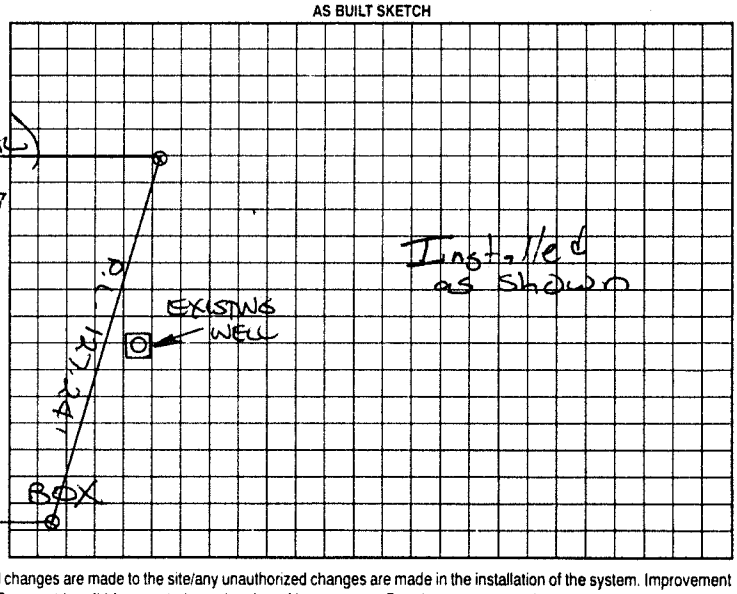

Permit can be suspended or revoked if any false information is supplied toward securing the permit/any unauthorized changes are made to the site/any unauthorized changes are made in the installation of the system. Improvement Permit with plat valid without expiration. Improvement Permit with site plan valid for sixty months. Authorization to Construct is valid for a period equal to that of Improvement Permit – not to exceed sixty months.

Signed: Caroline Bowers date 5-18-99 Installed by: A-1 Backhoe

Improvement Permit by: STEVE HEDRICK date 5-18-99 Operation Permit by: Mel Coty RS date 5-19-99

Authorization to Construct by: STEVE HEDRICK date 5-18-99 Existing System Inspection by: date

HEALTH DEPT COPY: WHITE OWNER COPY (FINAL): YELLOW OWNER COPY (INITIAL): PINK