58807

IREDELL COUNTY HEALTH DEPARTMENT

STATESVILLE 704-878-5305 MOORESVILLE 704-664-5281

IMPROVEMENT PERMIT / CERTIFICATE OF COMPLETION / OPERATION PERMIT / EXISTING SYSTEM INSPECTION

PROPERTY DESCRIPTION NO. 22867 DATE 12-22-95 TAX MAP NO 12E-1-A-42 (PART OF) Watershed: ☐ Yes ☑ No

OWNER OR CONTRACTOR JOHNNY P. BENGE PHONE: Business Home 876-4771

ADDRESS 3100 WILKESBORO HWY STATESVILLE NC 28677

LOCATION US 21 N TO BETHEL ROAD, TL THOMAS ROCK ROAD, LOT ON LEFT AT WELLS LANE EXISTING

SUBDIVISION BETHEL PARK BLOCK / SECTION LOT 42 LOT AREA 0.70AC SITE CLASS PS DESIGN FLOW 240 L.T.A.R. EXISTING

Septic Tank: 1000 Gallons; STB Date

Pump Tank: Gallons; PT Date

Pump Make: Model Serial No.

Nitrification Field: No Fields Square Feet Linear Feet EXISTING

No Lines EXISTING Trench Width Max Trench Bottom Depth Gravel Depth 12"

☐ New System ☐ Repair System Type: ☐ I ☐ II ☐ III ☐ IV ☐ V ☐ VI

System Description: CONVENTIONAL GRAVITY

Repair System Description: C

Maintenance Agreement Required: ☐ Yes ☑ No

☑ House/Mod. Home ☐ Mobile Home ☐ Business ☐ Other

No. Bedrooms 2 No. Bathrooms 1½ No. Employees


☐ Slab ☑ Crawl Space ☐ Basement w/plumbing ☐ Basement wo/plumbing

Water Supply: ☑ Individual ☐ Community ☐ Public WELL


Comments:

Comments: ① KEEP MH MINIMUM 5' FROM SYSTEM ② KEEP WELL MINIMUM 100' FROM SYSTEM

INITIAL SITE SKETCH

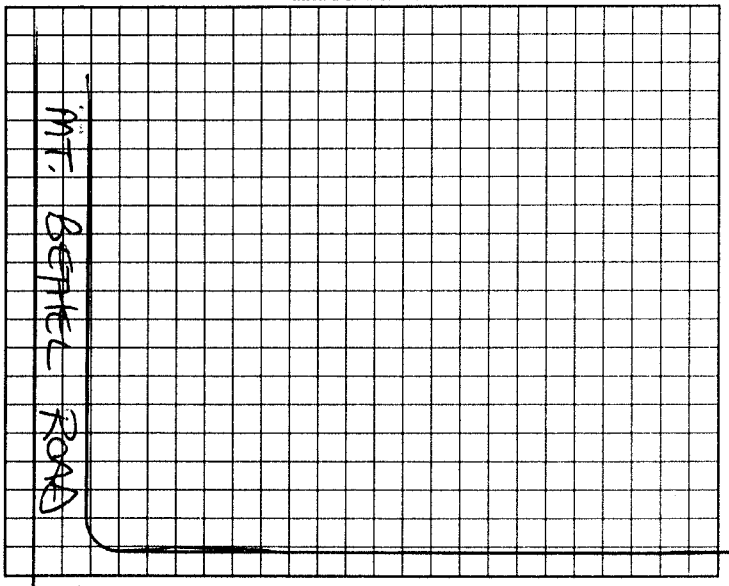

AS BUILT SKETCH

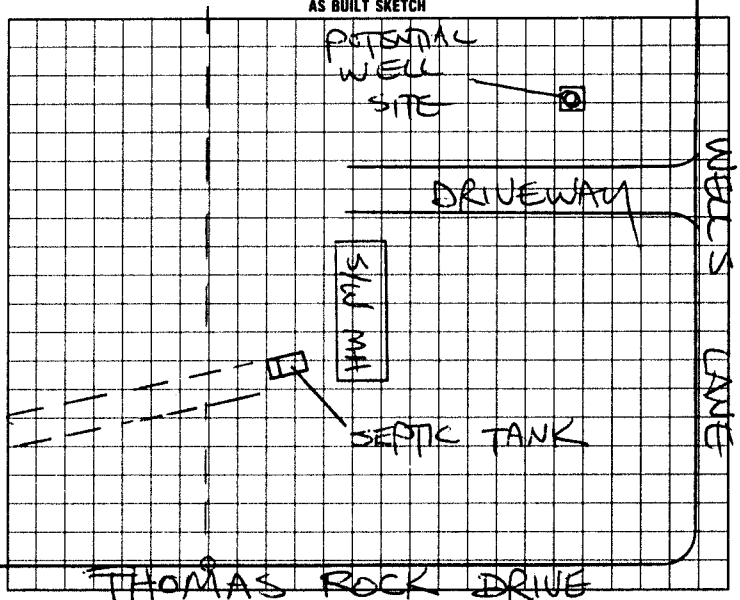

I understand that this permit can be suspended or revoked if any false information is supplied toward securing the permit/any unauthorized changes are made to the site/any unauthorized changes are made in the installation of the system.

Signed: Installed by:

Improvement Permit by: date Certificate of Completion by: date

Existing System Inspection by: STEVE HEDRICK date 12/22/95 Operation Permit by: date

HEALTH DEPT. COPY: WHITE INSPECTION COPY (FINAL) GREEN OWNER COPY (FINAL) YELLOW INSPECTION COPY (INITIAL) PINK OWNER COPY (INITIAL) GOLD