IREDELL COUNTY HEALTH DEPARTMENT

STATESVILLE 704-878-5305 MOORESVILLE 704-664-5281

IMPROVEMENT PERMIT / CERTIFICATE OF COMPLETION / OPERATION PERMIT / EXISTING SYSTEM INSPECTION

PROPERTY DESCRIPTION NO. 21613 DATE 7-18-95 TAX MAP NO. 12E-1-A-28 Watershed: ☐ Yes ☒ No

OWNER OR CONTRACTOR ROGER WAYNE HILL PHONE: Business Home 546-7968

ADDRESS 116 TABOR INN LANE, OLIN, NC 28660

LOCATION US 21 N, TR BETHEL RD, TL THOMAS ROCK, TL FLAKE, AT END ON LEFT

SUBDIVISION BETHEL PARK BLOCK / SECTION LOT 28 LOT AREA 2.20 ACRES SITE CLASS. PS DESIGN FLOW 360 L.T.A.R. 0.3 GPD/FT²

Septic Tank: 1000 Gallons; STB 1012 Date 3-27-95

Pump Tank: Gallons; PT Date

Pump Make: Model Serial No.

Nitrification Field: No Fields 1 Square Feet 1200 Linear Feet 400

No Lines 3 Trench Width 36" Max Trench Bottom Depth 18-36" Gravel Depth 12"

☒ New System ☐ Repair System Type: I II III IV V VI

System Description: CONVENTIONAL GRAVITY

Repair System Description: CONV. GRAVITY

Maintenance Agreement Required: ☐ Yes ☒ No

☐ House/Mod. Home ☒ Mobile Home ☐ Business ☐ Other

No. Bedrooms 3 No. Bathrooms 2 No. Employees


☐ Slab ☒ Crawl Space ☐ Basement w/plumbing ☐ Basement wo/plumbing

Water Supply: ☒ Individual ☐ Community ☐ Public WELL

Comments: ① KEEP SYSTEM MINIMUM 5' FROM MH, 10' FROM PROPERTY LINE, 100' FROM WELL, ② INSTALL LINES AS SHOWN & ON CONTOUR NO DEEPER THAN 36" 9' MINIMUM APART ON CENTER

Comments:

INITIAL SITE SKETCH

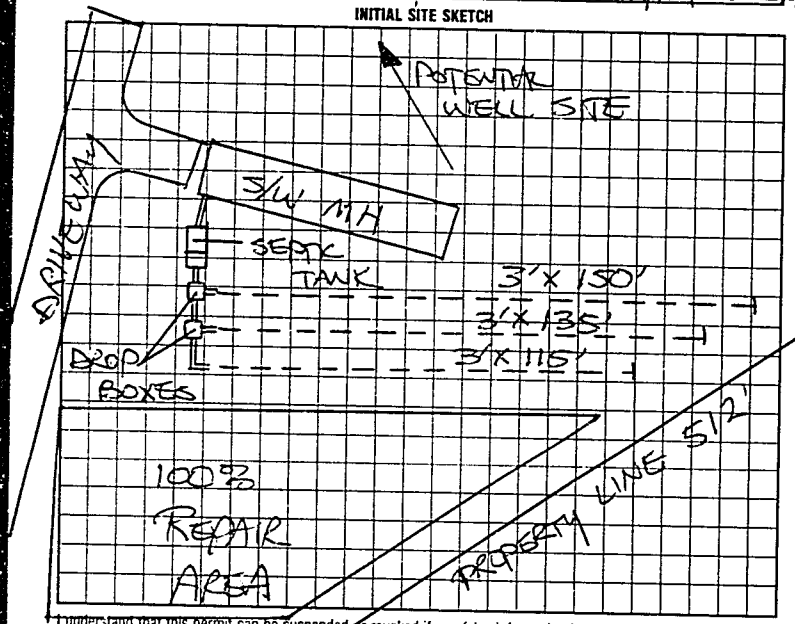

AS BUILT SKETCH

SYSTEM INSTALLED ACCORDING TO INITIAL SITE SKETCH

I understand that this permit can be suspended or revoked if any false information is supplied toward securing the permit/any unauthorized changes are made to the site/any unauthorized changes are made in the installation of the system. Improvement Permit is valid for 60 months from date of issuance.

Signed: X Roger W. Hill

Improvement Permit by: STEVE HENRICK date 7-18-95

Existing System Inspection by: date

Installed by: TOMMY FRYE

Certificate of Completion by: STEVE HENRICK date 7-28-95

Operation Permit by date

HEALTH DEPT COPY: WHITE INSPECTION COPY (FINAL): GREEN OWNER COPY (FINAL): YELLOW INSPECTION COPY (INITIAL): PINK OWNER COPY (INITIAL): GOLD

199000