IREDELL COUNTY HEALTH DEPARTMENT

STATESVILLE 704-878-5305 MOORESVILLE 704-664-5281

IMPROVEMENT PERMIT / AUTHORIZATION TO CONSTRUCT / OPERATION PERMIT / EXISTING SYSTEM INSPECTION

PERMIT# 149411 PIN# 4778-89-3948 DATE 17 Apr. 08

OWNER OR APPLICANT Robert W. Davis PHONE: Business 704-929-0164 Home

ADDRESS 613 Mt. Bethel Rd. Harmony NC

LOCATION Hwy 21N TR Mt. Bethel Rd. 2 mi. RS on left

SUBDIVISION BLOCK / SECTION LOT LOT AREA 3 Ac. SITE CLASS. PS DESIGN FLOW 240 gpd L.T.A.R. 0.3 gpd/sf

Septic Tank: 1000 Gallons: STB 760 Date 2-27-08

Pump Tank: Gallons: PT Date

Pump Make: Model Serial No.

Nitrification Field: No Fields 1 Square Feet = 800 Linear Feet 200

No Lines 3 Trench Width 36" Max Trench Bottom Depth 36" Gravel Depth

☑ New System ☐ Repair ☐ Expansion System Type: I II III IV V VI

System Description: 25% Reduction

Repair System Description: 25% Reduction

Maintenance Agreement Required: ☐ Yes ☑ No

☐ Gravity ☐ Pressure

☐ House/Mod. Home ☑ Mobile Home ☐ Business ☐ Other

No. Bedrooms 2 No. Persons No. Employees

Water Supply: ☐ Individual ☑ Public ☐ Community

☐ Slab ☑ Crawl Space ☐ Basement w/plumbing ☐ Basement wo/plumbing

Comments/Conditions:

2 BR mobile home

Home Setback requirements.

Comments/Conditions: Filter Tee installed

INITIAL SITE SKETCH

Please see Attached Init

AS BUILT SKETCH

Installed as Drawn on Site Plan

Permit can be suspended or revoked if any false information is supplied toward securing the permit/any unauthorized changes are made to the site/any unauthorized changes are made in the installation of the system. Improvement Permit with plat valid without expiration ☐ Improvement Permit with site plan valid for sixty months ☑ Authorization to Construct is valid for a period equal to that of Improvement Permit – not to exceed sixty months.

Signed: 4-17-08 date

Installed by: Randy Miller

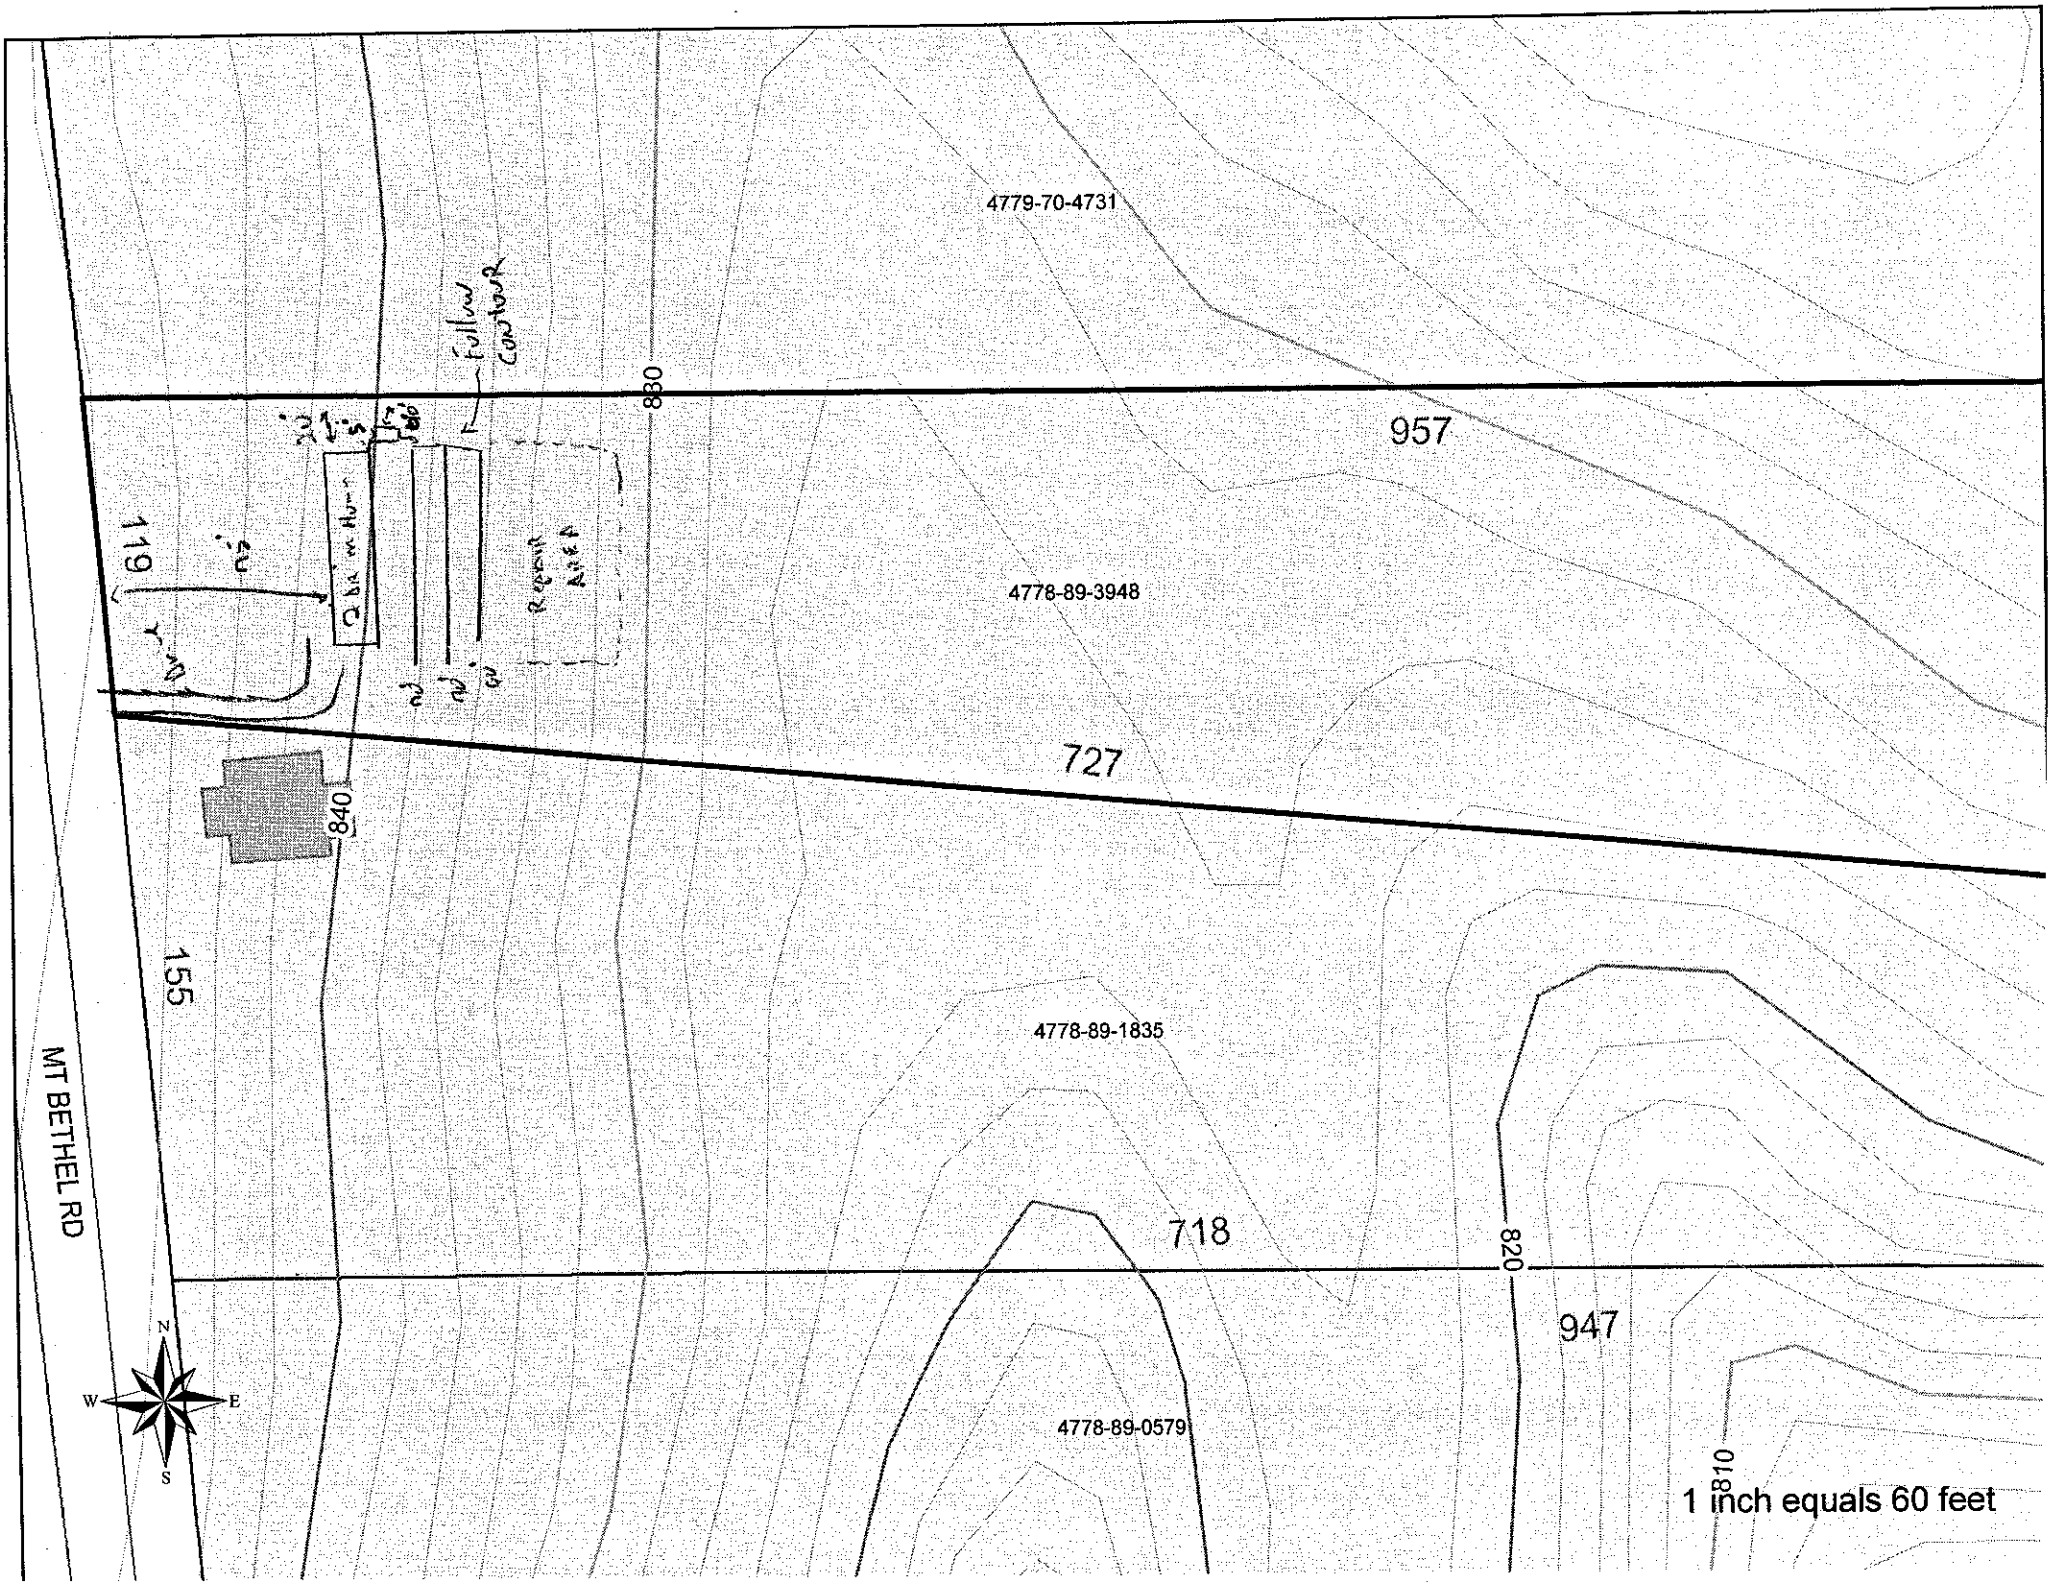
Improvement Permit by: R.S. date 17 Apr. 08

Operation Permit by: R.S. date 21 May 08

Authorization to Construct by: R.S. date 17 Apr. 08

Existing System Inspection by: date

HEALTH DEPT. COPY: WHITE OWNER COPY (FINAL): YELLOW OWNER COPY (INITIAL): PINK


4779-70-4731
880
957
4778-89-3948
727
840
155
MT BETHEL RD
4778-89-1835
718
820
947
4778-89-0579
810
N
W
E
S
1 inch equals 60 feet