IREDELL COUNTY HEALTH DEPARTMENT

STATESVILLE 704-878-5305 MOORESVILLE 704-664-5281

IMPROVEMENT PERMIT / AUTHORIZATION TO CONSTRUCT / OPERATION PERMIT / EXISTING SYSTEM INSPECTION

PERMIT# 087386 PIN# 4778 89 9104 DATE 2-2-00

OWNER OR CONTRACTOR ARNOLD CRAFT PHONE: Business 872-6565 Home 871-8921

ADDRESS 117 COWAN LANE STATESVILLE, NC 28625

LOCATION US 21 NORTH, TR MT. BETHEL RD, TL THOMAS ROCK, TL FLAKE, LOT AT END ON RIGHT

SUBDIVISION BETHEL PARK BLOCK / SECTION ____ LOT 26 LOT AREA 3.9975 ACRES SITE CLASS PS DESIGN FLOW 240 L.T.A.R. 0.30 GAD/FT²

Septic Tank: 1000 Gallons; STB 794 Date 1-5-01
Pump Tank: ____ Gallons; PT ____ Date ____
Pump Make: ____ Model ____ Serial No. ____
Nitrification Field: No Fields 1 Square Feet EQ. TO 810 Linear Feet 200+
No Lines FOUR Trench Width 36" Max Trench Bottom Depth 36"

☑ New System ☐ Repair System Type: I, II, III, IV, V, VI
System Description: 25% REDUCTION GRAVITY
Repair System Description: CONVENTIONAL PUMP
Maintenance Agreement Required: ☐ Yes ☑ No

☐ House/Mod. Home ☑ Mobile Home ☐ Business ☐ Other
No. Bedrooms 2 No. Bathrooms 2 No. Employees ____


Water Supply: ☑ Individual ☐ Public ☐ Community
WELL

Depth 6" SAND ☐ Slab ☑ Crawl Space ☐ Basement w/plumbing ☐ Basement wo/plumbing

Comments/Conditions: INSTALL 25% REDUCTION SYSTEM USING 34 CHAMBERS OR 20 HDS SECTIONS ON CONTOUR AS FLAGGED
PROPERTY LINE 570'

Comments/Conditions: SEPTIC TANK WITH MARKER INSTALLED USING "POLYLOK" FILTER

INITIAL SITE SKETCH

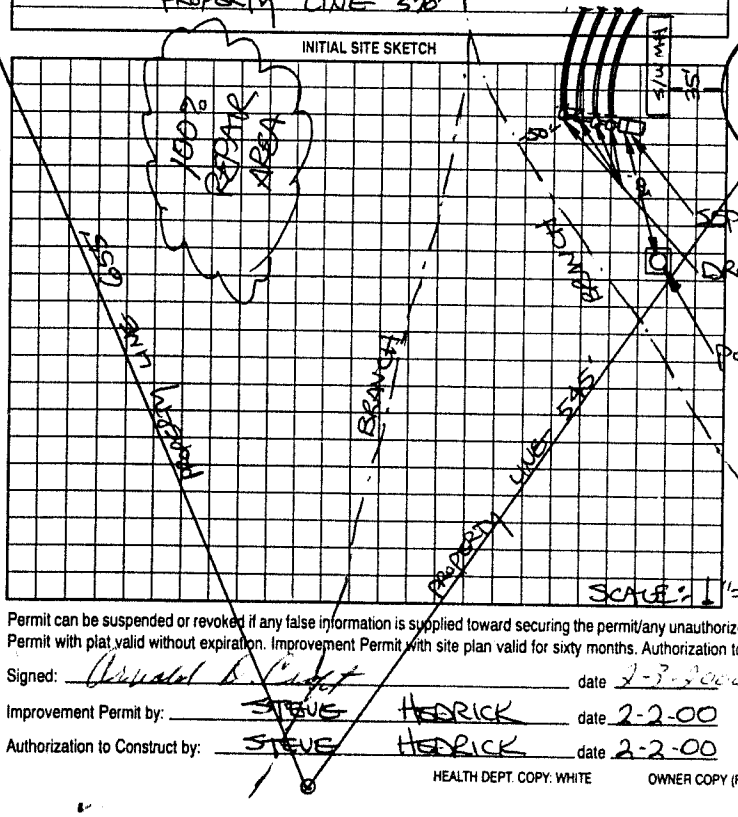

AS BUILT SKETCH

SYSTEM INSTALLED ACCORDING TO INITIAL SITE SKETCH

Permit can be suspended or revoked if any false information is supplied toward securing the permit/any unauthorized changes are made to the site/any unauthorized changes are made in the installation of the system. Improvement Permit with plat valid without expiration. Improvement Permit with site plan valid for sixty months. Authorization to Construct is valid for a period equal to that of Improvement Permit – not to exceed sixty months.

Signed: Arnold Craft date 2-3-2000 Installed by: TUCKERS HAULING & GRADING

Improvement Permit by: STEVE HEDRICK date 2-2-00 Operation Permit by: STEVE HEDRICK date 3-26-01

Authorization to Construct by: STEVE HEDRICK date 2-2-00 Existing System Inspection by: ____ date ____

HEALTH DEPT. COPY: WHITE OWNER COPY (FINAL): YELLOW OWNER COPY (INITIAL): PINK