IREDELL COUNTY HEALTH DEPARTMENT

STATESVILLE 704-878-5305 MOORESVILLE 704-664-5281

IMPROVEMENT PERMIT / AUTHORIZATION TO CONSTRUCT / OPERATION PERMIT / EXISTING SYSTEM INSPECTION

PERMIT# 119826 PIN# 4778-98-1087 DATE 4-30-04

OWNER OR CONTRACTOR GEORGE MYSZAK PHONE: Business 704-880-1995 Home 704-872-6934

ADDRESS 842 BELL FARM RD STATESVILLE NC 28625

LOCATION OLD MOCKSVILLE (L) MT. BETHEL (R) THOMAS ROCK (R) FLAKE 1ST S/W MH ON (L)

SUBDIVISION BETHEL PARK BLOCK / SECTION ____ LOT 14 LOT AREA 0.9 SITE CLASS PS DESIGN FLOW 360 L.T.A.R. .25 GPD/FT

Septic Tank: 1000 Gallons; STB 786 Date 2-26-04
Pump Tank: ____ Gallons; PT ____ Date ____
Pump Make: ____ Model ____ Serial No. ____
Nitrification Field: No Fields 1 Square Feet 1440 Linear Feet 360
No Lines 4 Trench Width 36" Max Trench Bottom Depth 24" Gravel Depth N/A

☑ New System ☐ Repair System Type: I, II, (III), IV, V, VI
System Description: GRAVITY 25% REDUCTION
Repair System Description: SAME
Maintenance Agreement Required: ☐ Yes ☑ No


☐ House/Mod. Home No. Bedrooms 3
☑ Mobile Home No. Bathrooms 2
☐ Business No. Employees ____
☐ Other ____
☐ Slab ☑ Crawl Space ☐ Basement w/plumbing ☐ Basement wo/plumbing

Water Supply: ☑ Individual ☐ Public ☐ Community

Comments:/Conditions: (1) MAINTAIN SETBACKS (2) INSTALL LINES 24" ON CONTOUR

Comments:/Conditions: SEPTIC TANK WITH MARKER INSTALLED USING "ZABEL" FILTER

INITIAL SITE SKETCH

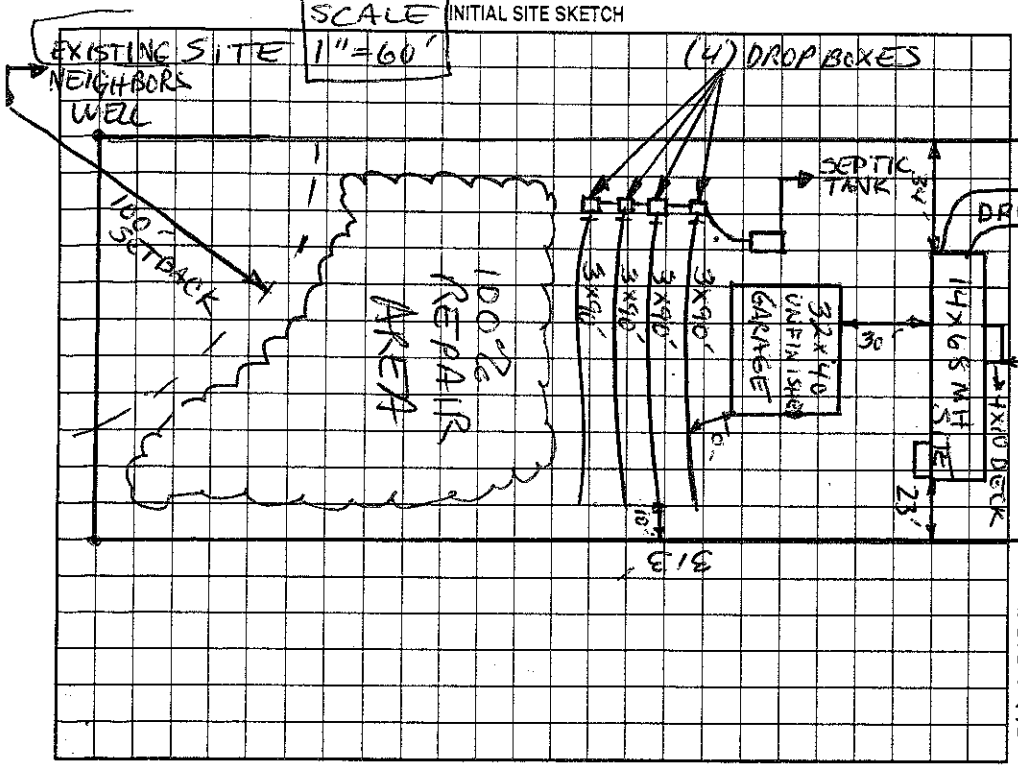

AS BUILT SKETCH

SYSTEM INSTALLED ACCORDING TO INITAL SITE SKETCH USING 58 "INFILTRATOR" CHAMBERS (STANDARD)

Permit can be suspended or revoked if any false information is supplied toward securing the permit/any unauthorized changes are made to the site/any unauthorized changes are made in the installation of the system. Improvement Permit with plat valid without expiration. Improvement Permit with site plan valid for sixty months. Authorization to Construct is valid for a period equal to that of Improvement Permit – not to exceed sixty months.

Signed: [signature] date 4-30-04 Installed by: BUCK'S GRADING

Improvement Permit by: Christopher M. Shell, RS date 4-30-04 Operation Permit by: Christopher M. Shell, RS date 9-27-04

Authorization to Construct by: Christopher M. Shell, RS date 4-30-04 Existing System Inspection by: ____ date ____

HEALTH DEPT. COPY: WHITE OWNER COPY (FINAL): YELLOW OWNER COPY (INITIAL): PINK