IREDELL COUNTY HEALTH DEPARTMENT

STATESVILLE 704-878-5305 MOORESVILLE 704-664-5281

IMPROVEMENT PERMIT / CERTIFICATE OF COMPLETION / OPERATION PERMIT / EXISTING SYSTEM INSPECTION

PROPERTY DESCRIPTION NO. 070829 DATE 12-12-97 TAX MAP NO. 4779 04 2053

OWNER OR CONTRACTOR FRED W. BORCHERT III PHONE: Business Home 872-0923 Watershed: ☐ Yes ☑ No (HUNTER RUN)

ADDRESS 3529 DAVIES COURT VIRGINIA BEACH VA 23462

LOCATION US 21 N, TR CHIEF THOMAS, ~0.25 MILE ON LEFT, BACK OFF ROAD 1200'

SUBDIVISION BLOCK / SECTION LOT LOT AREA 15.57 ACRES SITE CLASS. PSI DESIGN FLOW 480 L.T.A.R. 0.35 GPD/FT²

Septic Tank: 1000 Gallons; STB 794 Date 4-8-98

Pump Tank: Gallons; PT Date

Pump Make: Model Serial No.

Nitrification Field: No Fields 1 Square Feet 180 Linear Feet 460

No Lines FOUR Trench Width 36" Max Trench Bottom Depth 36 Gravel Depth 12"

☑ New System ☐ Repair System Type: I, II, III, IV, V, VI

System Description: CONVENTIONAL GRAVITY

Repair System Description: CONV. GRAVITY

Maintenance Agreement Required: ☐ Yes ☑ No

☑ House/Mod. Home ☐ Mobile Home ☐ Business ☐ Other

No. Bedrooms 4 No. Bathrooms 2½ No. Employees

☐ Slab ☑ Crawl Space ☐ Basement w/plumbing ☐ Basement wo/plumbing

Water Supply: ☐ Individual ☐ Community ☑ Public


Comments:

Comments:


* Note House Turned W - Tank at end of house

House masonry 2 Bd System sized for 4 Bd

INITIAL SITE SKETCH

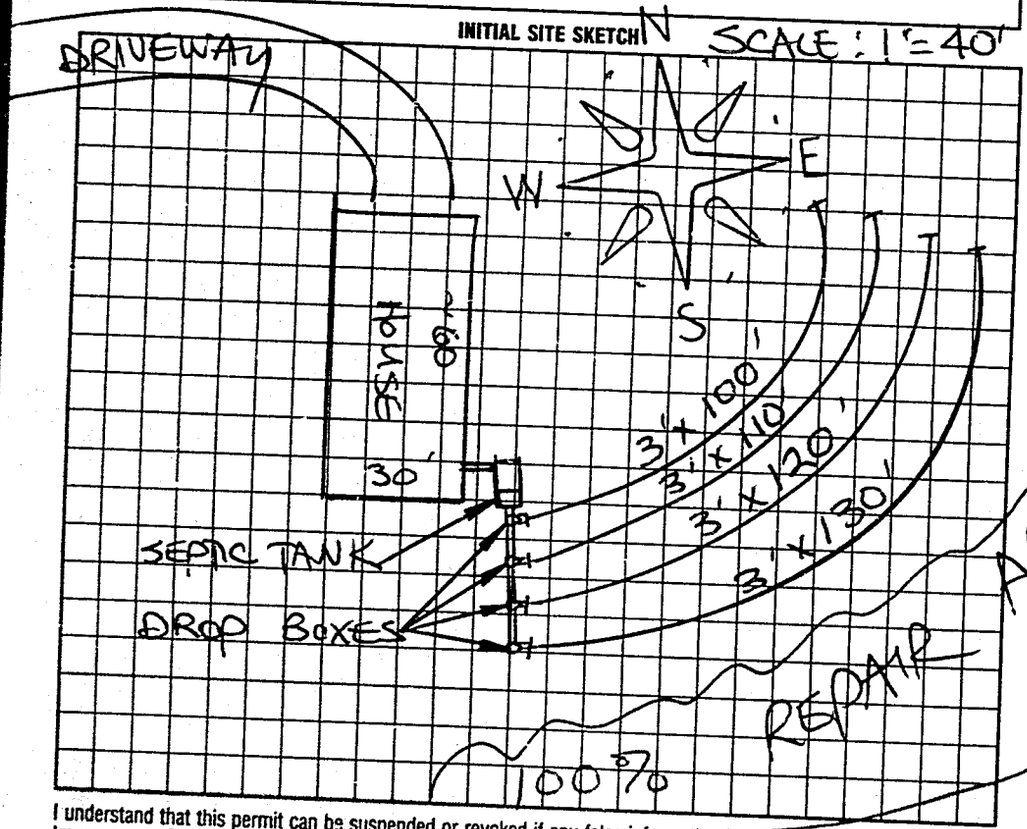

AS BUILT SKETCH

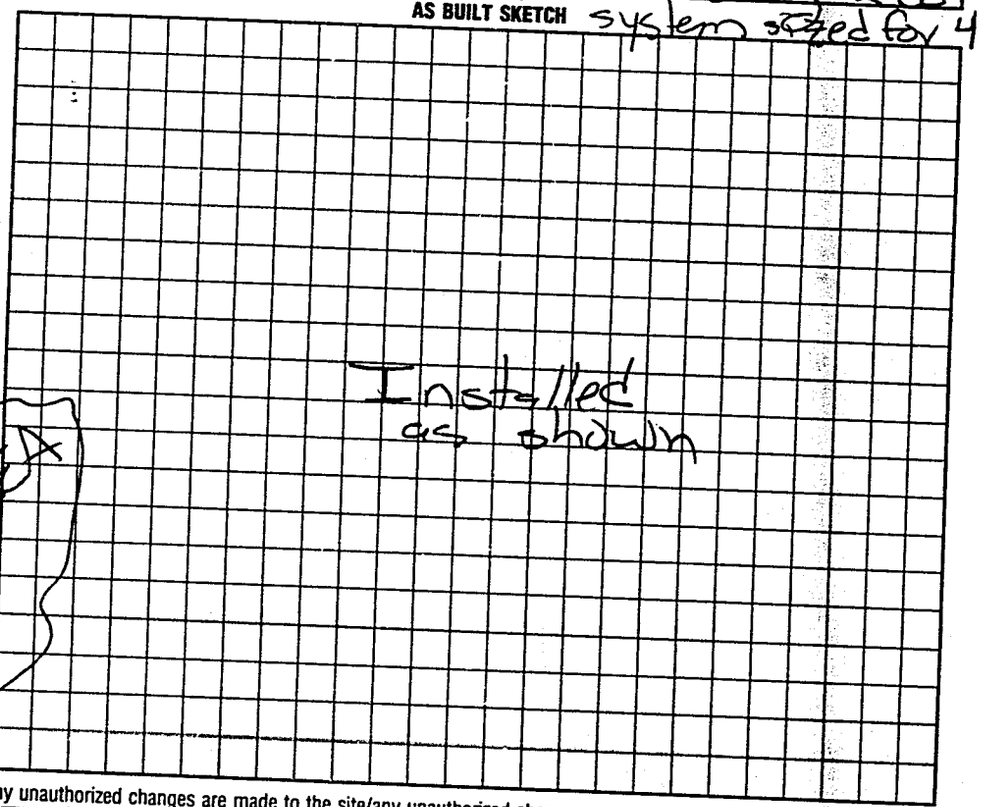

I understand that this permit can be suspended or revoked if any false information is supplied toward securing the permit/any unauthorized changes are made to the site/any unauthorized changes are made in the installation of the system. Improvement Permit is valid for 60 months from date of issuance. AUTHORIZATION TO CONSTRUCT IS VALID FOR 60 MONTHS FROM DATE OF ISSUANCE.

Signed: X Mike Barth

Improvement Permit by: STEVE HEDRICK date 12-12-97

~~Existing System Inspection~~ AUTH. TO CONST. by: STEVE HEDRICK date 12-12-97

Installed by: James Hudler

~~Certificate of Completion by:~~ date

Operation Permit by: Matt C Atkins date 7-8-98

HEALTH DEPT. COPY: WHITE INSPECTION COPY (FINAL): GREEN OWNER COPY (FINAL): YELLOW INSPECTION COPY (INITIAL): PINK OWNER COPY (INITIAL): GOLD