IREDELL COUNTY HEALTH DEPARTMENT

STATESVILLE 704-878-5305 MOORESVILLE 704-664-5281

IMPROVEMENT PERMIT / AUTHORIZATION TO CONSTRUCT / OPERATION PERMIT / EXISTING SYSTEM INSPECTION

PERMIT# 087647 PIN# 4779 01 2053 DATE 4-27-2000

OWNER OR CONTRACTOR FRED W. BORCHERT III PHONE: Business _____ Home 546-5269

ADDRESS 157 CHIEF THOMAS ROAD, HARMONY, NC 28634

LOCATION US 21 N, TR CHIEF THOMAS RD, ON LEFT AT BOX # 157, BACK OFF ROAD 1200'

SUBDIVISION _____ BLOCK / SECTION _____ LOT _____ LOT AREA 15.57 AC SITE CLASS PS DESIGN FLOW 480 L.T.A.R. 0.35 GPD/FT²

Septic Tank: 1000 Gallons; STB _____ Date _____

Pump Tank: _____ Gallons; PT _____ Date _____

Pump Make: _____ Model _____ Serial No. _____

Nitrification Field: No. Fields 1 Square Feet 1380 Linear Feet 460

No Lines FOUR Trench Width 36" Max Trench Bottom Depth 36" Gravel Depth 12"

☐ New System ☐ Repair System Type: I II III IV V VI

System Description: CONV. GRAVITY

Repair System Description: CONV. GRAVITY

Maintenance Agreement Required: ☐ Yes ☒ No

☒ House/Mod. Home No. Bedrooms 3

☐ Mobile Home No. Bathrooms 3

☐ Business No. Employees _____

☐ Other _____


☐ Slab ☒ Crawl Space ☐ Basement w/plumbing ☐ Basement wo/plumbing

Water Supply: ☑ Individual ☐ Public ☐ Community WELL


Comments:/Conditions:

Comments:/Conditions:

INITIAL SITE SKETCH

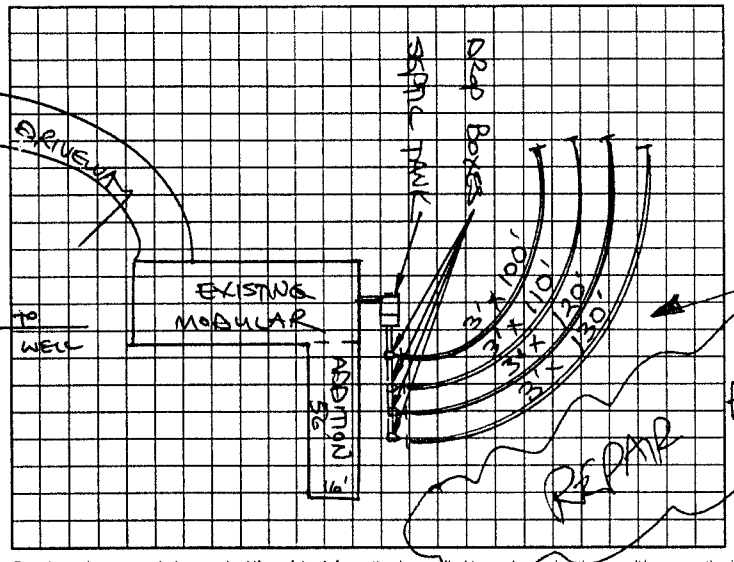

AS BUILT SKETCH

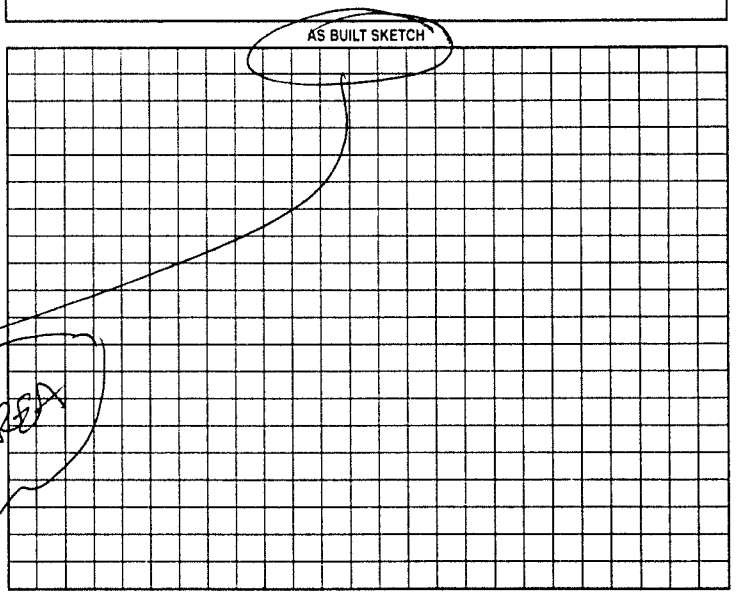

Permit can be suspended or revoked if any false information is supplied toward securing the permit/any unauthorized changes are made to the site/any unauthorized changes are made in the installation of the system. Improvement Permit with plat valid without expiration. Improvement Permit with site plan valid for sixty months. Authorization to Construct is valid for a period equal to that of Improvement Permit – not to exceed sixty months.

Signed: _____ date _____

Improvement Permit by: [redacted] date _____

Authorization to Construct by: [redacted] date _____

Installed by: _____

Operation Permit by: _____ date _____

Existing System Inspection by: STEVE HEDRICK date 6-27-2000

HEALTH DEPT. COPY: WHITE OWNER COPY (FINAL): YELLOW OWNER COPY (INITIAL): PINK