IREDELL COUNTY HEALTH DEPARTMENT

STATESVILLE 704-878-5305 (ET) MOORESVILLE 704-664-5281

IMPROVEMENT PERMIT / AUTHORIZATION TO CONSTRUCT / OPERATION PERMIT / EXISTING SYSTEM INSPECTION

PERMIT# 105184 PIN# 4779-07-9689 DATE 3-15-02

OWNER OR CONTRACTOR HARVEY WADDELL PHONE: Business Home (704) 880-2056

ADDRESS P.O. BOX 1575 STATESVILLE NC 28687

LOCATION HWY 21 NORTH 2ND DRIVE ON LEFT PAST FOREST OAK ROAD BACK OFF ROAD ~350'

SUBDIVISION BLOCK / SECTION LOT LOT AREA 1.157 ACRES SITE CLASS. PS DESIGN FLOW 360 L.T.A.R. 0.35 GAD/A

Septic Tank: 1000 Gallons: STB 1012 Date 10-6-01
Pump Tank: Gallons: PT Date
Pump Make: Model Serial No.
Nitrification Field: No Fields 1 Square Feet 1050 Linear Feet 350'
No Lines FIVE Trench Width 36" Max Trench Bottom Depth 36" Gravel Depth 12"

☐ New System ☐ Repair System Type: I II III IV V VI
System Description: CONVENTIONAL GRAVITY
Repair System Description: CONVENTIONAL GRAVITY
Maintenance Agreement Required: ☐ Yes ☐ No


☐ House/Mod. Home No. Bedrooms 3
☐ Mobile Home No. Bathrooms 2
☐ Business No. Employees
☐ Other
☐ Slab ☐ Crawl Space ☐ Basement w/plumbing ☐ Basement wo/plumbing

Water Supply: ☐ Individual ☐ Public ☐ Community

Comments/Conditions:

Comments/Conditions: SEPTIC TANK WITH MARKER INSTALLED USING "POLYLOK" FILTER

INITIAL SITE SKETCH

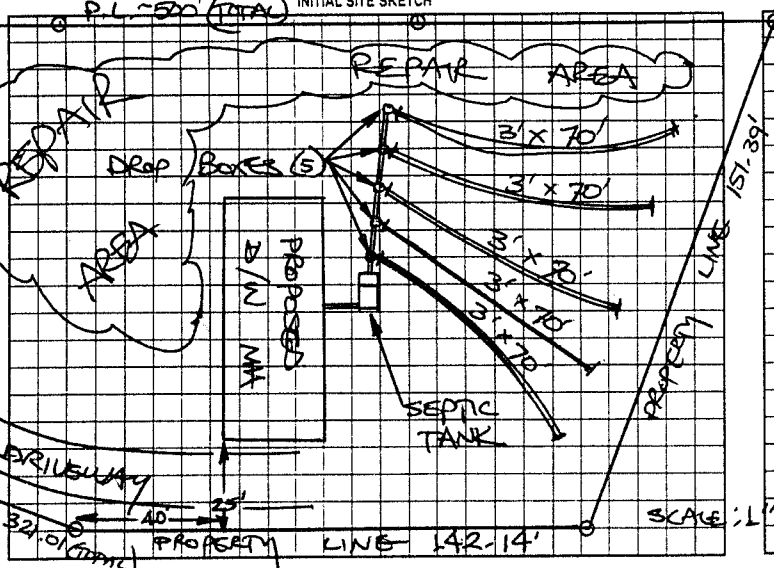

AS BUILT SKETCH

SYSTEM INSTALLED ACCORDING TO INITIAL SITE SKETCH

Permit can be suspended or revoked if any false information is supplied toward securing the permit/any unauthorized changes are made to the site/any unauthorized changes are made in the installation of the system. Improvement Permit with plat valid without expiration. Improvement Permit with site plan valid for sixty months. Authorization to Construct is valid for a period equal to that of Improvement Permit – not to exceed sixty months.

Signed: Heidi Cox date 3/15/02 Installed by: TOMMY FRYE

Improvement Permit by: STEVE HEDRICK date 3-15-02 Operation Permit by: STEVE HEDRICK date 3-28-02

Authorization to Construct by: STEVE HEDRICK date 3-15-02 Existing System Inspection by: date

HEALTH DEPT. COPY WHITE OWNER COPY (FINAL) YELLOW OWNER COPY (INITIAL) PINK