IREDELL COUNTY HEALTH DEPARTMENT - *ENVIRONMENTAL HEALTH* ☒ STATESVILLE OFFICE 704-878-5305 ☐ MOORESVILLE OFFICE 704-664-5281

IMPROVEMENT PERMIT / AUTHORIZATION TO CONSTRUCT (01) / OPERATION PERMIT (01) / EXISTING SYSTEM INSPECTION

PERMIT # 170359 PIN # 4779-08-6337 DATE 2-3-12

OWNER Harmony Meadows LLC APPLICANT: Leah Donaldson PHONE: Home/Cell # 704-792-7903 Business # 704-902-4015

SITE ADDRESS 153 Bel Aire Dr Harmony OWNER / APPLICANT ADDRESS

SITE DIRECTIONS 21N 7½ mi ± (L) Bel Aire Dr. Site at end of Bel-Aire

SUBDIVISION Harmony Meadows BLOCK / SECTION LOT # 16 LOT AREA .459 DESIGN FLOW 240 L.T.A.R. 3

Septic Tank 1000 Gallons: STB 760 Date 8-1-11

Pump Tank Gallons: P T Date

Pump Make Model Serial #

No. Nitrification Fields: 1 No. Lines 4 Linear Feet 200

Trench Width 36" Max. Trench Bottom Depth Gravel Depth

☒ New System ☐ Repair ☐ Expansion System Type I II (III) IV V VI

System Description: 25% Reduction Gravity

Repair System Description: 25% Reduction Gravity

Maintenance Agreement Required ☐ YES ☒ NO

☒ GRAVITY ☐ PRESSURE

☒ Residence No. Bedrooms 2

☐ Business No. Persons

☐ Other No. Employees


☐ Slab ☒ Crawl Space

☐ Basement w/plumbing ☐ Basement w/o plumbing

Water Supply: ☐ Private ☒ Public ☐ Community

Comments / Conditions

INITIAL SITE SKETCH

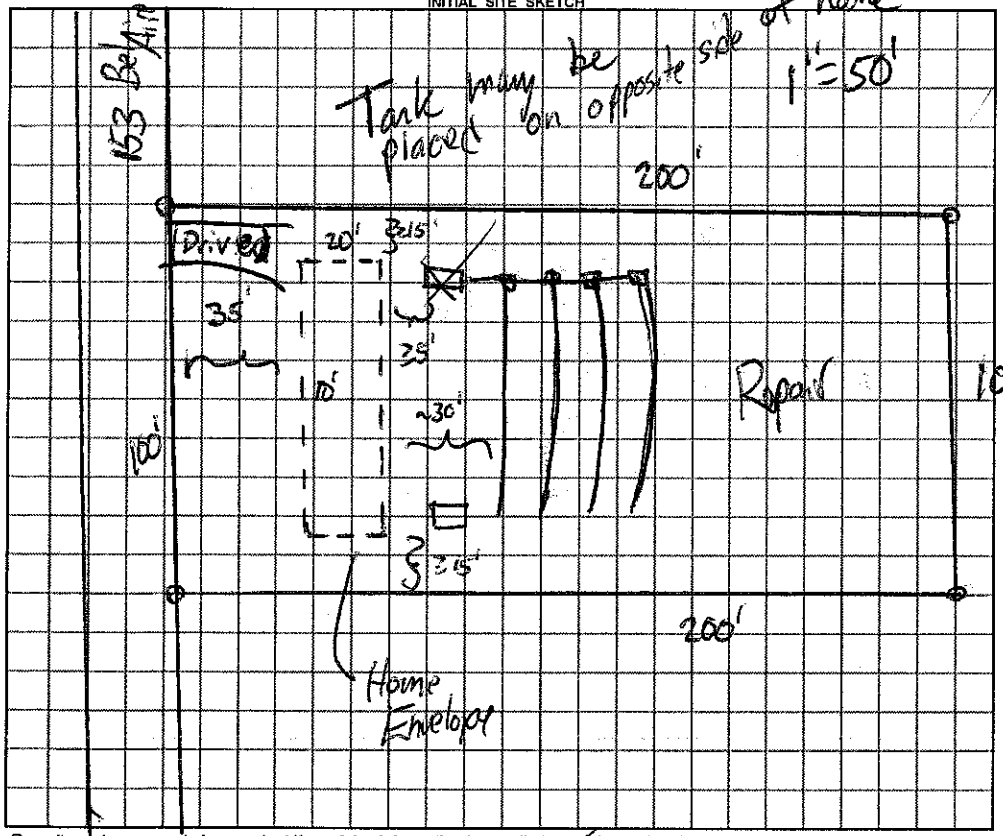

AS BUILT SKETCH

Permit can be suspended or revoked if any false information is supplied toward securing the permit / any unauthorized changes are made to the site / any unauthorized changes are made in the installation of the system.

☐ *IMPROVEMENT PERMIT* with plat valid without expiration. ☒ *IMPROVEMENT PERMIT* with plat valid without expiration. site plan valid 60 mo. ☐ *AUTHORIZATION TO CONSTRUCT* valid for period equal to IMPROVEMENT PERMIT--not to exceed 60 mo.

Owner / Applicant Signature: Dennis Gallilee Date 2-6-12 Installed by: A-1 Backhoe

IMPROVEMENT PERMIT by: REHS Date 2-3-12 OPERATION PERMIT by: REHS Date 2-7-12

AUTHORIZATION TO CONSTRUCT by: REHS Date 2-3-12 Existing System Inspected by: REHS Date

YOU SHOULD CONTACT A LOCATOR SERVICE PRIOR TO ANY EXCAVATION

White Copy – Environmental Health YELLOW COPY (Final) Owner / Applicant PINK COPY (Initial) Owner / Applicant