IREDELL COUNTY HEALTH DEPARTMENT - *ENVIRONMENTAL HEALTH* ☒ STATESVILLE OFFICE 704-878-5305 ☐ MOORESVILLE OFFICE 704-664-5281

IMPROVEMENT PERMIT / AUTHORIZATION TO CONSTRUCT / OPERATION PERMIT / EXISTING SYSTEM INSPECTION

PERMIT # 170362 PIN # 4779-08-6557 DATE 2-3-12

OWNER Harmony Meadows APPLICANT: Leah Donaldson PHONE: Home/Cell # 704 902 4015 Business #

SITE ADDRESS 161 Bel Air Dr. OWNER / APPLICANT ADDRESS 161 Bel Air Dr.

SITE DIRECTIONS 21N; 7½ mi +/- (L) Bel-Aire Dr., site at end of Bel-Air Dr.

SUBDIVISION Harmony Meadows BLOCK / SECTION LOT # 18 LOT AREA .46 DESIGN FLOW 240 L.T.A.R. .3

Septic Tank 1000 Gallons: STB 760 Date 8-12-11
Pump Tank Gallons: PT Date
Pump Make Model Serial #
No. Nitrification Fields: 1 No. Lines 3 Linear Feet 200
Trench Width 36" Max. Trench Bottom Depth 36" Gravel Depth n/a


☒ New System ☐ Repair ☐ Expansion System Type I II (III) IV V VI
System Description: 25% Reduction Gravity
Repair System Description: 25% Reduction Gravity
Maintenance Agreement Required ☐ YES ☒ NO
☒ GRAVITY ☐ PRESSURE

☒ Residence No. Bedrooms 2
☐ Business No. Persons
☐ Other No. Employees
☐ Slab ☒ Crawl Space
☐ Basement w/plumbing ☐ Basement w/o plumbing


Water Supply: ☐ Private ☒ Public ☐ Community

Comments / Conditions

INITIAL SITE SKETCH

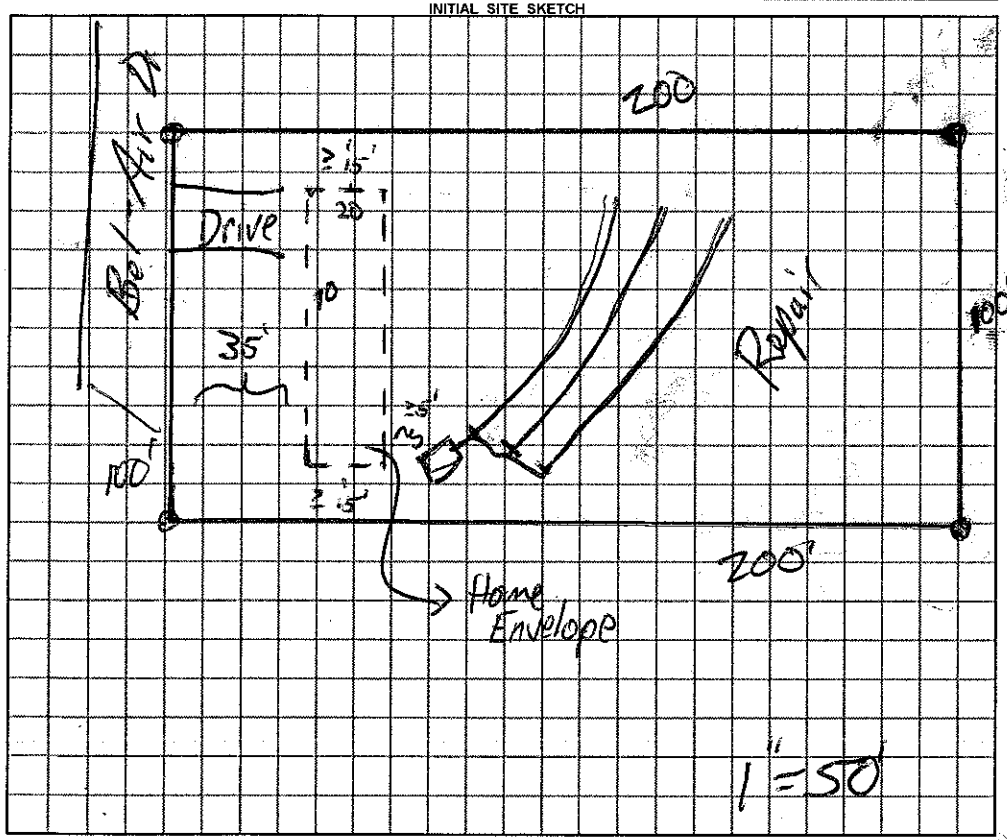

AS BUILT SKETCH

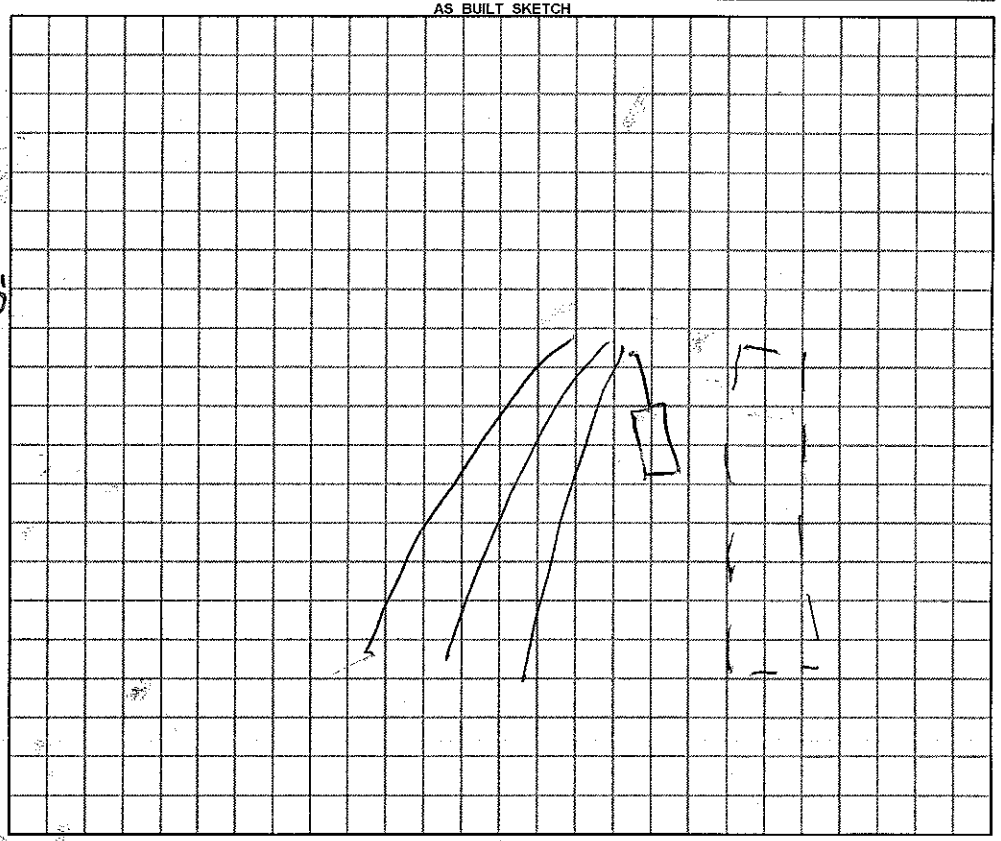

Permit can be suspended or revoked if any false information is supplied toward securing the permit / any unauthorized changes are made to the site / any unauthorized changes are made in the installation of the system.

☐ ***IMPROVEMENT PERMIT*** with plat valid without expiration. ☐ ***IMPROVEMENT PERMIT*** with plat valid without expiration. site plan valid 60 mo. ☐ ***AUTHORIZATION TO CONSTRUCT*** valid for period equal to IMPROVEMENT PERMIT--not to exceed 60 mo.

Owner / Applicant Signature: Dennis Gallikes Date 2-6-12 Installed by: A-1 Backhoe

IMPROVEMENT PERMIT by: REHS Date 2-3-12 OPERATION PERMIT by: REHS Date 2-7-12

AUTHORIZATION TO CONSTRUCT by: REHS Date 2-3-12 Existing System Inspected by: REHS Date

YOU SHOULD CONTACT A LOCATOR SERVICE PRIOR TO ANY EXCAVATION

White Copy – Environmental Health YELLOW COPY (Final) Owner / Applicant PINK COPY (Initial) Owner / Applicant