IREDELL COUNTY HEALTH DEPARTMENT - *ENVIRONMENTAL HEALTH* ☑ STATESVILLE OFFICE 704-878-5305 ☐ MOORESVILLE OFFICE 704-664-5281

IMPROVEMENT PERMIT / AUTHORIZATION TO CONSTRUCT(1) / OPERATION PERMIT(1) EXISTING SYSTEM INSPECTION

PERMIT # 165/80 PIN # 4779 08 9282 DATE March 1, 2011

OWNER Harmony Meadows LLC APPLICANT: PHONE: Home/Cell # 704 788 3990 Business # 704 792 7903

SITE ADDRESS 1341 Bel-Aire Dr. Harmony OWNER / APPLICANT ADDRESS

SITE DIRECTIONS I-S 21 N TL Bel-Aire Dr (before Harmony City Limits) on Right

SUBDIVISION Harmony Meadows BLOCK / SECTION LOT # 8 LOT AREA 1.882Ac DESIGN FLOW 360 gpd L.T.A.R. .25

Septic Tank EX 1000 Gallons: STB Date

Pump Tank Gallons: P T Date

Pump Make Model Serial #

No. Nitrification Fields: 1 No. Lines 1 Linear Feet 120 Addn.

Trench Width 36" Max. Trench Bottom Depth 36" Gravel Depth NA

☐ New System ☐ Repair ☑ Expansion System Type I II III IV V VI

System Description: Gravity 25% Reduction Accepted

Repair System Description: Gravity/pumped 25% Red!

Maintenance Agreement Required ☐ YES ☒ NO

☒ GRAVITY ☐ PRESSURE

☒ Residence No. Bedrooms 3

☐ Business No. Persons

☐ Other No. Employees


☐ Slab ☒ Crawl Space

☐ Basement w/plumbing ☐ Basement w/o plumbing


Water Supply: ☐ Private ☒ Public ☐ Community

Comments / Conditions: Upgrading 2 bedroom system to 3 bedroom capacity. Relocate proposed boundaries prior to installing additional drainfield lateral.

INITIAL SITE SKETCH

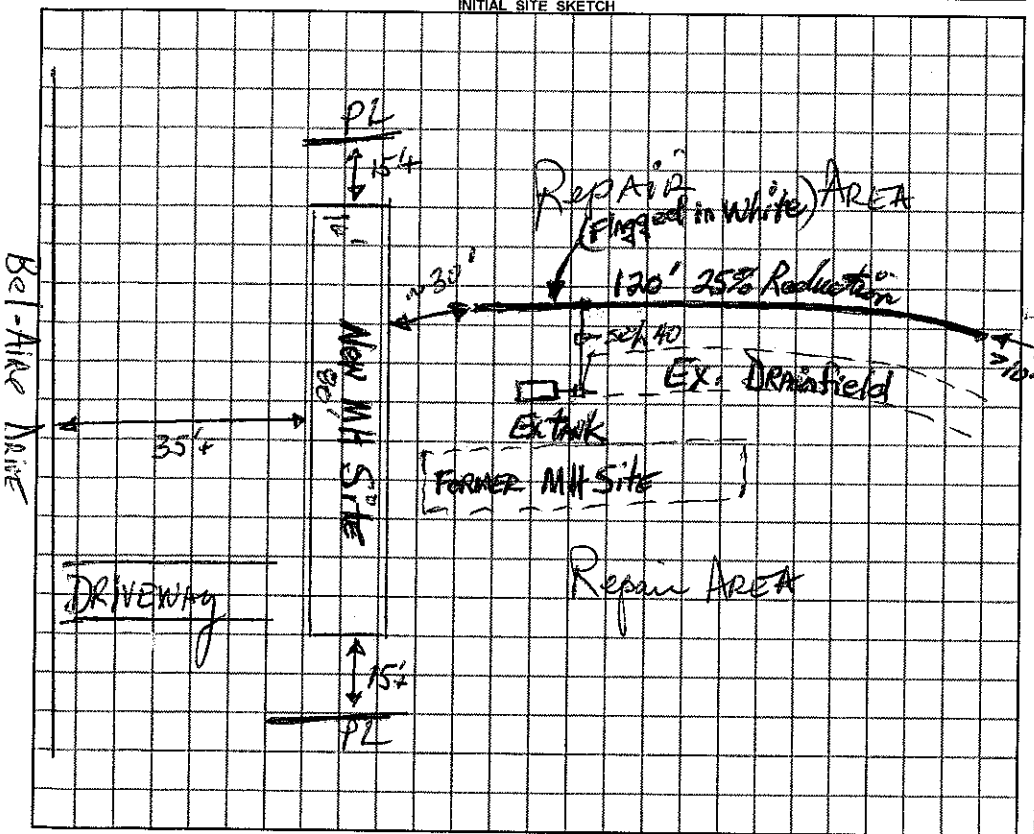

AS BUILT SKETCH

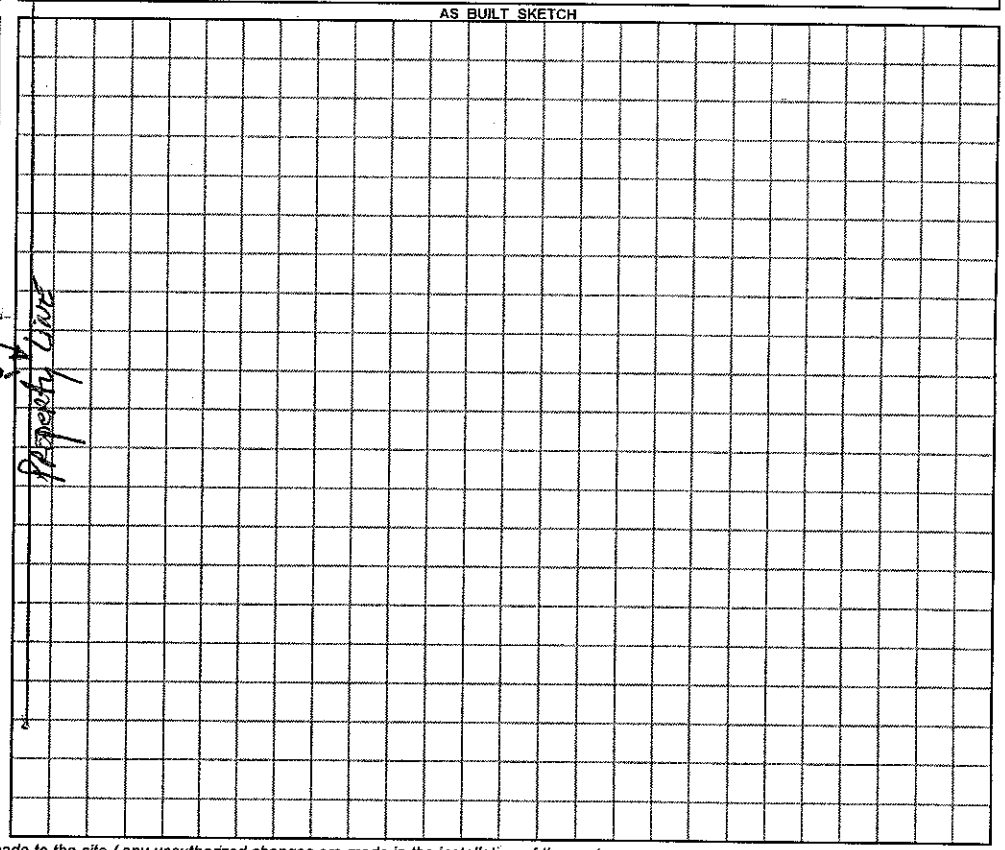

Permit can be suspended or revoked if any false information is supplied toward securing the permit / any unauthorized changes are made to the site / any unauthorized changes are made in the installation of the system.

☐ *IMPROVEMENT PERMIT* with plat valid without expiration. ☒ *IMPROVEMENT PERMIT* with plat valid ~~without expiration~~ Site plan 60 mos. ☒ *AUTHORIZATION TO CONSTRUCT* valid for period equal to IMPROVEMENT PERMIT--not to exceed 60 mo.

Owner / Applicant Signature: Richard Anderson Date 3-16-11 Installed by: A-1 Backhoe

IMPROVEMENT PERMIT by: REHS Date 3-1-11 OPERATION PERMIT by: REHS Date 3-18-11

AUTHORIZATION TO CONSTRUCT by: REHS Date 3-1-11 Existing System Inspected by: REHS Date

YOU SHOULD CONTACT A LOCATOR SERVICE PRIOR TO ANY EXCAVATION

White Copy – Environmental Health YELLOW COPY (Final) Owner / Applicant PINK COPY (Initial) Owner / Applicant