IREDELL COUNTY HEALTH DEPARTMENT

Statesville Office (704) 878-5305 Mooresville Office (704) 660-3625 PERMIT # 179023

IMPROVEMENT PERMIT / AUTHORIZATION TO CONSTRUCT / OPERATION PERMIT / EXISTING SYSTEM

PIN # 4779-08-9610

APPLICANT: Harmony Meadows, LLC APPLICANT ADDRESS: P.O. Box 308, Mt. Mourne, NC 28123

SITE ADDRESS: 1618 Bel Aire Dr. Harmony, NC 28634 PHONE: 704-792-7903 ALT. PHONE:

SITE DIRECTIONS: 77 N, 21 N exit, (R), go approximately 7.5 miles; (L) Bel-Aire Dr., Last lot on Right

SUBDIVISION: Harmony Meadows SECTION: LOT # 23 LOT AREA: .619 DESIGN FLOW: 360 L.T.A.R.: .3

Septic Tank 1000 (gal) STB 760 Date 2-12-13
Pump Tank (gal) PT Date
Pump Make Model Serial #
Nitrification Fields 1 # Lines 4 Linear Ft: 300
Trench Width 36" Max. Trench Bottom Depth 36" Gravel Depth n/a


☒ New System ☐ Repair ☐ Expansion System Type: I II (III) IV V VI
System Description: 25% Gravity Reduction Gravity
Repair System Description: 50% Reduction LP
Maintenance Agreement Required: ☐ YES ☒ NO
☒ GRAVITY ☐ PRESSURE

☒ Residence ☐ Business ☐ Other ☐ Slab ☐ Basement w/plumbing
No. Bedrooms 3 No. Persons No. Employees
☒ Crawl Space ☐ Basement w/o plumbing


Water Supply: ☐ Private ☒ Public ☐ Community

Comments / Conditions:

INITIAL SITE SKETCH

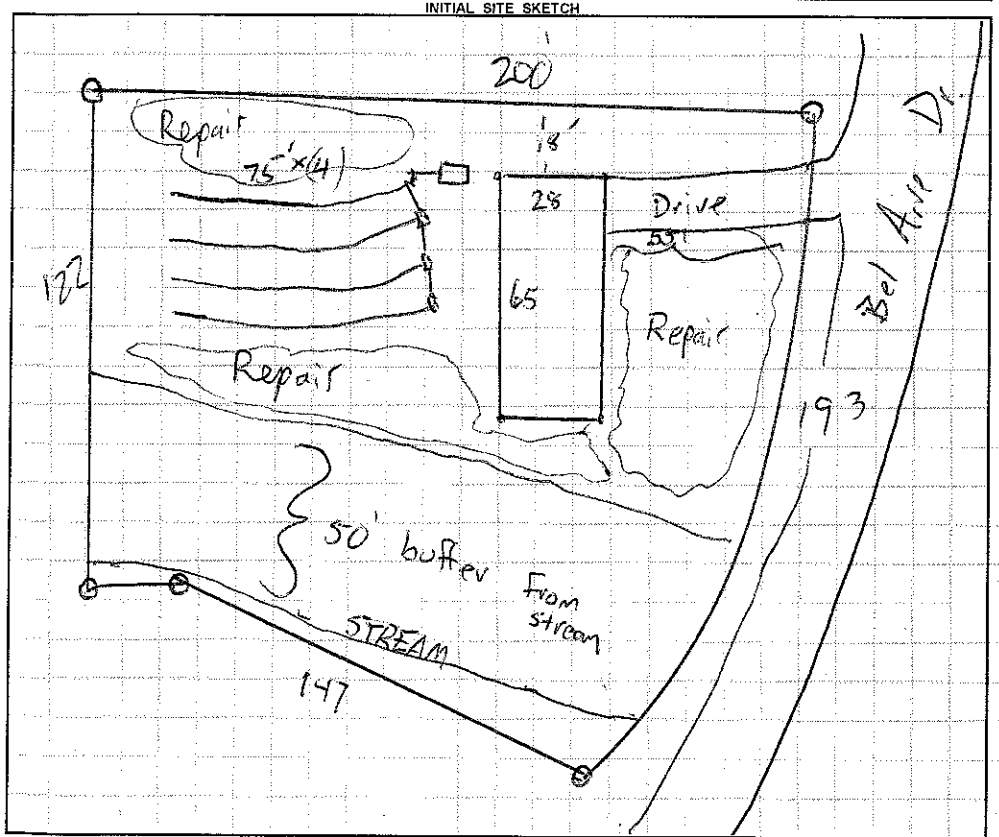

AS BUILT SKETCH

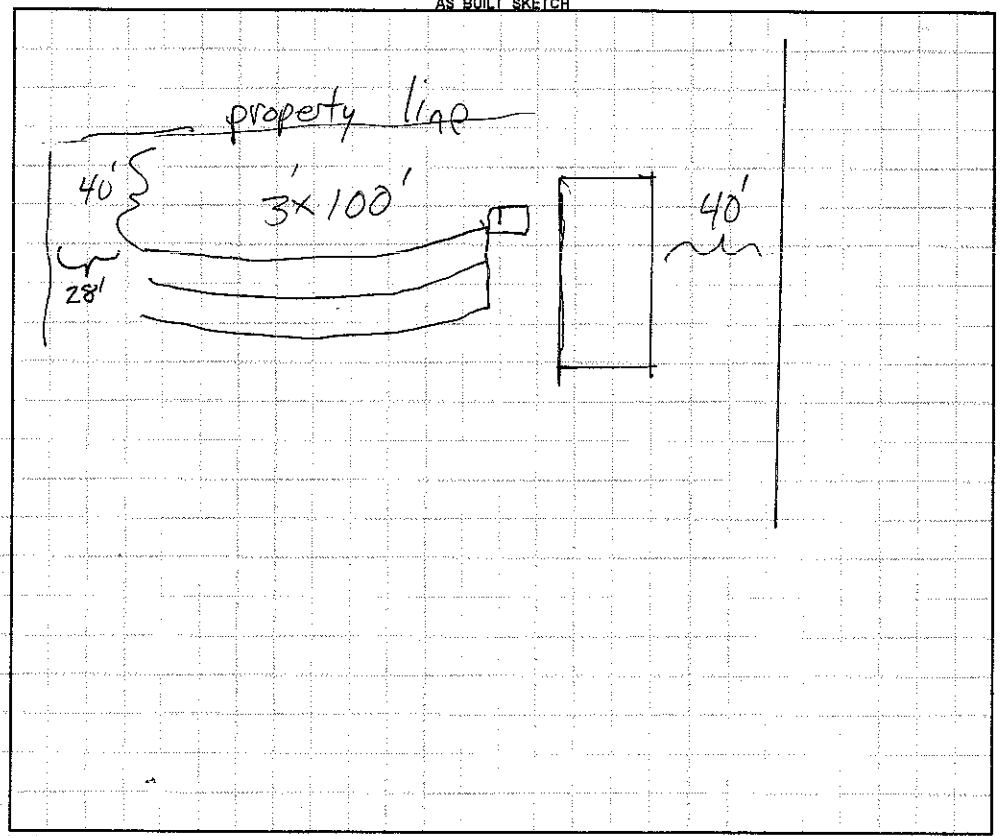

Permit can be suspended or revoked if any false information is supplied toward securing the permit / any unauthorized changes are made to the site / any unauthorized changes are made in the installation of the system. **CONTACT A LOCATOR SERVICE PRIOR TO ANY EXCAVATION**

☐ **IMPROVEMENT PERMIT** *with plat valid without expiration.* ☒ **IMPROVEMENT PERMIT** *with site plan valid for 60 mos.* ☒ **AUTHORIZATION TO CONSTRUCT** *valid for period equal to IMPROVEMENT PERMIT--not to exceed 60 mo.*

Owner / Applicant Signature: Dennis Ballew Date: 6-18-13 Installed by: A-1 Backhoe

IMPROVEMENT PERMIT by: James Date: 6-17-13 OPERATION PERMIT by: James Date: 6-19-13

AUTHORIZATION TO CONSTRUCT by: James Date: 6-17-13 Existing System Inspected by: Date:

Health Dept. Copy - WHITE Applicant (Final Approval) - YELLOW Applicant (Conditional Approval) - PINK