IREDELL COUNTY HEALTH DEPARTMENT

Statesville Office (704) 878-5305 Mooresville Office (704) 660-3625 PERMIT # 219733

IMPROVEMENT PERMIT / AUTHORIZATION TO CONSTRUCT / OPERATION PERMIT / EXISTING SYSTEM

PIN # 4779-08-9610.000

APPLICANT: Jay T Doris Hall APPLICANT ADDRESS: 133 Homestead Rd. Harmony NC

SITE ADDRESS: 166 Bee Hive Dr. Harmony NC PHONE: 704-539-4084 ALT. PHONE: 704-450-2329

SITE DIRECTIONS: Hwy 21 N, TL Bee Hive Dr, Site @ End on R

SUBDIVISION: Harmony Meadows SECTION: 2 LOT # 23 LOT AREA: .619 Acre DESIGN FLOW: Ex. 360GAL L.T.A.R.: Existing

Septic Tank Existing (gal) STB Date
Pump Tank (gal) PT Date
Pump Make Model Serial #
Nitrification Fields Ex. # Lines Ex. Linear Ft: Ex.
Trench Width Ex. Max. Trench Bottom Depth Ex. Gravel Depth Ex. (N/A)

☐ New System ☐ Repair ☐ Expansion System Type: I II (III) IV V VI
System Description: Existing 25% Reduction - Gravity
Repair System Description: LPP-PDRPS
Maintenance Agreement Required: ☐ YES ☒ NO
☒ GRAVITY ☐ PRESSURE


☒ Residence No. Bedrooms Ex. 3
☐ Business No. Persons Ex. 6
☐ Other No. Employees
☒ Slab ☐ Crawl Space
☐ Basement w/plumbing ☐ Basement w/o plumbing

Water Supply: ☐ Private ☒ Public ☐ Community

Comments / Conditions: Existing System Approved To Be Functioning @ Time of Inspection.

INITIAL SITE SKETCH

AS BUILT SKETCH

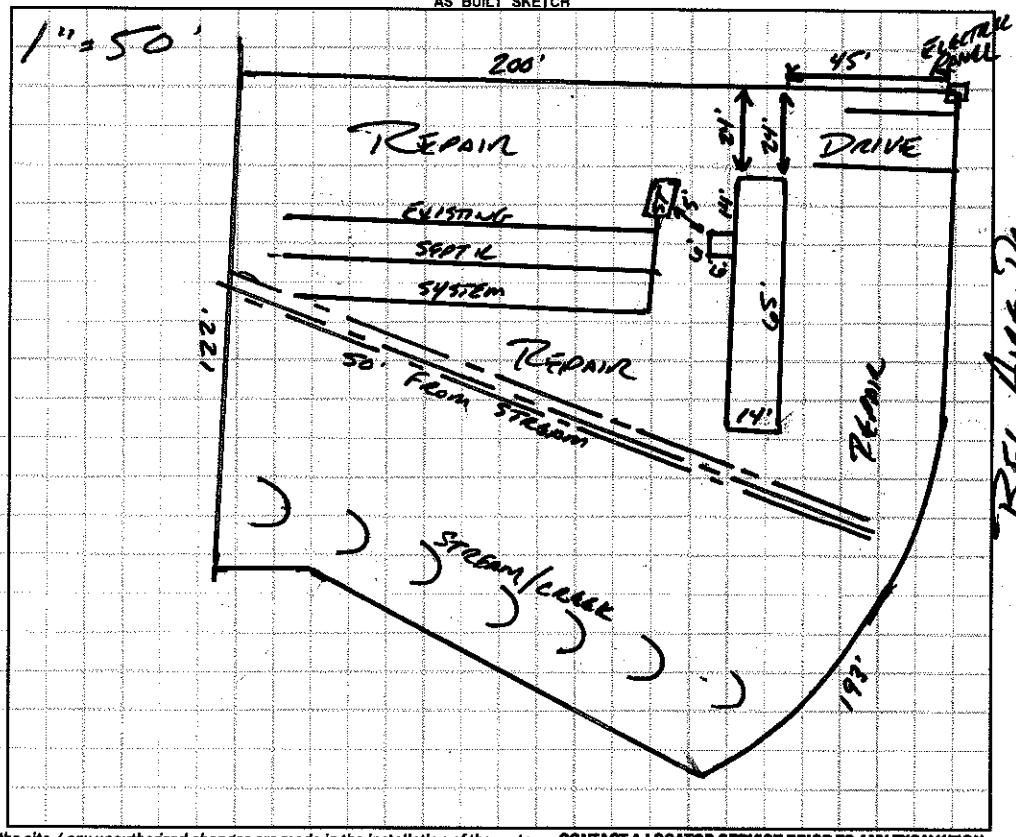

Permit can be suspended or revoked if any false information is supplied toward securing the permit / any unauthorized changes are made to the site / any unauthorized changes are made in the installation of the system. **CONTACT A LOCATOR SERVICE PRIOR TO ANY EXCAVATION**

☐ **IMPROVEMENT PERMIT *with plat*** *valid without expiration.* ☐ **IMPROVEMENT PERMIT *with site plan*** *valid for 60 mos.* ☐ **AUTHORIZATION TO CONSTRUCT** *valid for period equal to IMPROVEMENT PERMIT--not to exceed 60 mo.*

Owner / Applicant Signature: Jay H. Hall Date: 8-11-16 Installed by:

IMPROVEMENT PERMIT by: Date: OPERATION PERMIT by: Date:

AUTHORIZATION TO CONSTRUCT by: Date: Existing System Inspected by:

APPROVED AUG 09 2016

Health Dept. Copy - WHITE Applicant (Final Approval) - YELLOW Applicant (Conditional Approval) - PINK