IREDELL COUNTY HEALTH DEPARTMENT - *ENVIRONMENTAL HEALTH* ☐ STATESVILLE OFFICE 704-878-5305 ☐ MOORESVILLE OFFICE 704-664-5281

IMPROVEMENT PERMIT / AUTHORIZATION TO CONSTRUCT / OPERATION PERMIT / EXISTING SYSTEM INSPECTION

PERMIT # 165179 PIN # 4779 17 1838 DATE July 1, 2011

OWNER Harmony Meadows LLC APPLICANT: PHONE: Home/Cell # Business #

SITE ADDRESS 121 BelAire Dr. Harmony OWNER / APPLICANT ADDRESS

SITE DIRECTIONS US 21 N R BelAire Dr. 1st lot on left

SUBDIVISION Harmony Meadows BLOCK / SECTION LOT # 9 LOT AREA DESIGN FLOW 240gpd L.T.A.R.

Septic Tank Existing Gallons: STB Date

Pump Tank Gallons: P T Date

Pump Make Model Serial #

No. Nitrification Fields: 1 No. Lines Linear Feet

Trench Width Existing Max. Trench Bottom Depth Gravel Depth

☐ New System ☐ Repair ☐ Expansion System Type I II III IV V Vi

System Description: Existing

Repair System Description:

Maintenance Agreement Required ☐ YES ☐ NO

☐ GRAVITY ☐ PRESSURE

☐ Residence No. Bedrooms 2

☐ Business No. Persons

☐ Other No. Employees

☐ Slab ☐ Crawl Space

☐ Basement w/plumbing ☐ Basement w/o plumbing


Water Supply: ☐ Private ☒ Public ☐ Community

Comments / Conditions

Existing system not showing any sign of malfunction. Driveway re-leveled and drainage ditch filled in to get to septic system per T. Higgins on 7-1-11

INITIAL SITE SKETCH

AS BUILT SKETCH

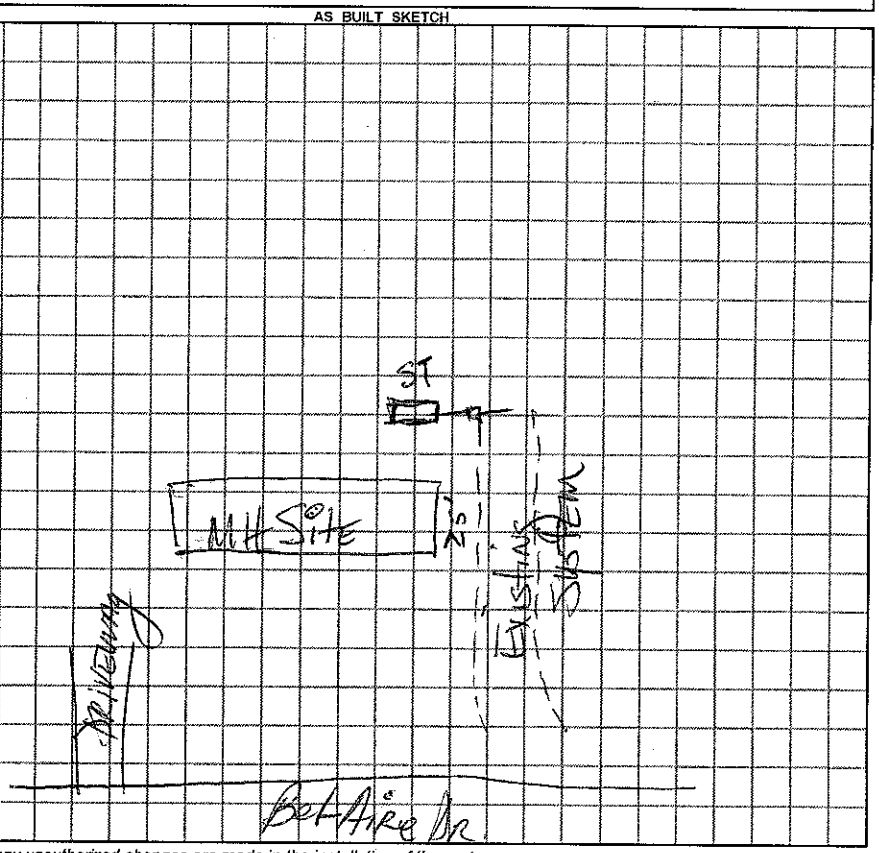

Permit can be suspended or revoked if any false information is supplied toward securing the permit / any unauthorized changes are made to the site / any unauthorized changes are made in the installation of the system.

☐ ***IMPROVEMENT PERMIT*** with plat valid without expiration. ☐ ***IMPROVEMENT PERMIT*** with ~~plat valid without expiration.~~ site plan valid 60 mo. ☐ ***AUTHORIZATION TO CONSTRUCT*** valid for period equal to IMPROVEMENT PERMIT--not to exceed 60 mo.

Owner / Applicant Signature: Date 7-1-11 Installed by:

IMPROVEMENT PERMIT by: ***REHS*** Date OPERATION PERMIT by: ***REHS*** Date

AUTHORIZATION TO CONSTRUCT by: ***REHS*** Date Existing System Inspected by: ***REHS*** Date 7-1-11

YOU SHOULD CONTACT A LOCATOR SERVICE PRIOR TO ANY EXCAVATION

White Copy – Environmental Health YELLOW COPY (Final) Owner / Applicant PINK COPY (Initial) Owner / Applicant