IREDELL COUNTY HEALTH DEPARTMENT

Statesville Office (704) 878-5305 Mooresville Office (704) 660-3625 PERMIT # 2466071

SEPTIC IMPROVEMENT PERMIT / AUTHORIZATION TO CONSTRUCT / OPERATION PERMIT / EXISTING SYSTEM

PIN # 4779185316 ✓

APPLICANT/OWNER: ~~Gary Staley~~ Lewis Godfrey APPLICANT ADDRESS: 230 S Miami Blvd, Durham

SITE ADDRESS: ~~120~~ 120 Darline Ln, Harmony 28634 PHONE: 336-762-2856 ALT. PHONE —

SITE DIRECTIONS: 21 → L on Bel Aire → R on Darline → end of cul-de-sac on R SAP CONTROLLED: ☐ YES ☒ EXT ☐ NO

SUBDIVISION: Harmony Meadows MHP SECTION: 1 LOT # 4 LOT AREA: 1.745ac DESIGN FLOW: 240gpd L.T.A.R.: ext

Septic Tank ____ (gal) STB ____ Date ____
Pump Tank ____ (gal) PT ____ Date ____
Pump Make ____ Model existing Serial # ____
Nitrification Fields ____ # Lines ____ Linear Ft ____
Trench Width ____ Trench Bottom Depth(Low side) ____ Gravel Depth ____


☐ New System ☐ Repair ☐ Expansion System Type: I (II) III IV V VI
System Description: existing
Repair System Description:
Maintenance Agreement Required: ☐ YES ☒ NO
☒ GRAVITY ☐ PRESSURE

☒ Residence No. Bedrooms 2
☐ Business No. Persons 4
☐ Other No. Employees
☐ Slab ☒ Crawl Space
☐ Basement w/ plumbing ☐ Basement w/o plumbing


Water Supply: ☐ Private ☐ Public ☒ Community

Comments / Conditions: Existing system seems to be functioning properly at time of inspection. Maintain minimum 8' setback with any part of new home.

INITIAL SITE SKETCH

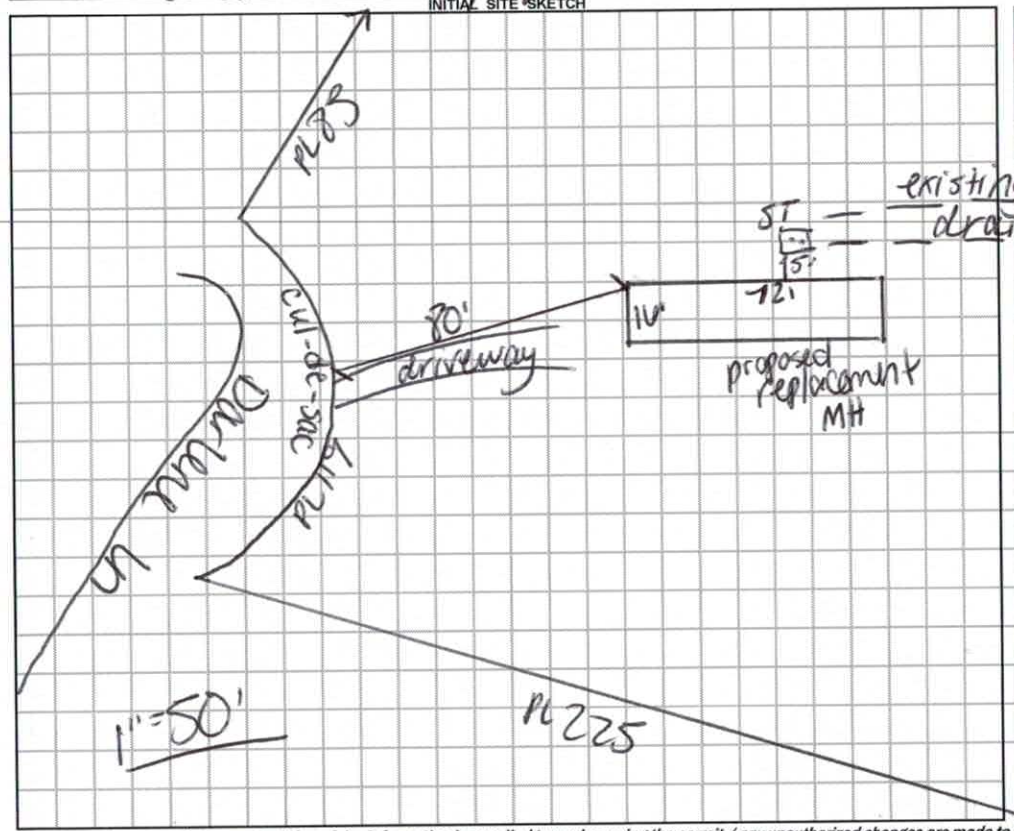

AS BUILT SKETCH

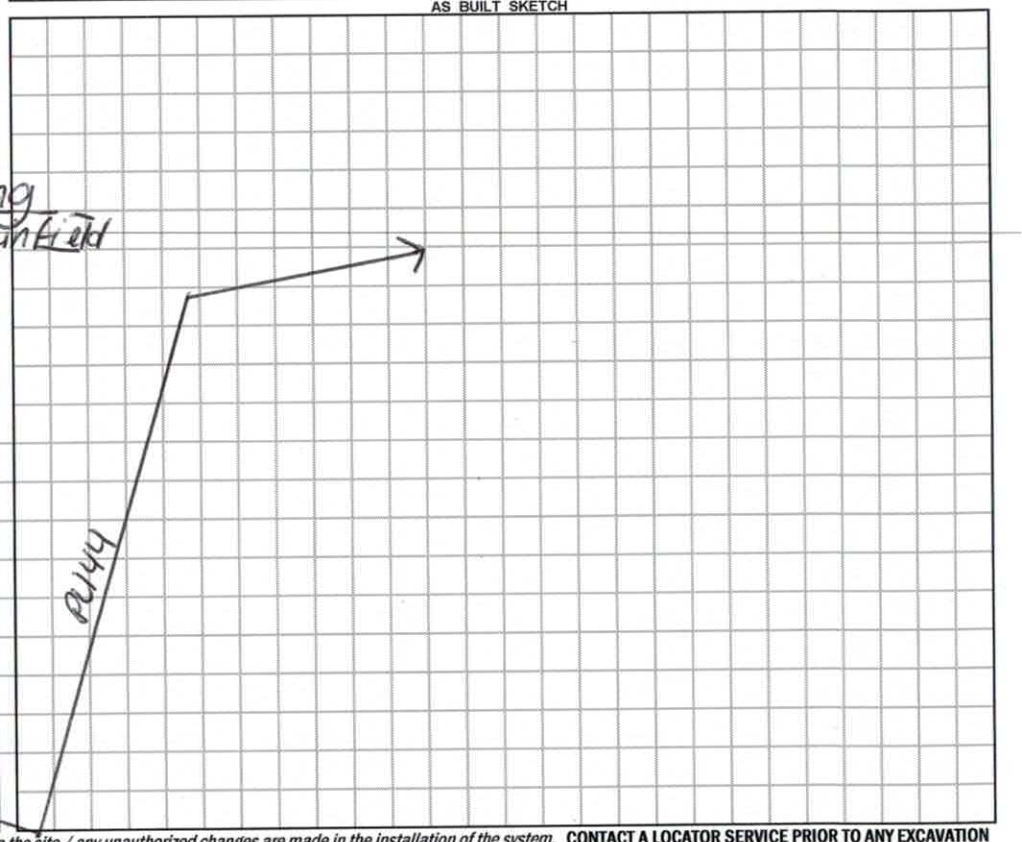

Permit can be suspended or revoked if any false information is supplied toward securing the permit / any unauthorized changes are made to the site / any unauthorized changes are made in the installation of the system. **CONTACT A LOCATOR SERVICE PRIOR TO ANY EXCAVATION**

☐ **IMPROVEMENT PERMIT** *with plat valid without expiration.* ☐ **IMPROVEMENT PERMIT** *with site plan valid for 60 mos.* ☐ **AUTHORIZATION TO CONSTRUCT** *valid for period equal to IMPROVEMENT PERMIT--not to exceed 60 mo.*

Owner / Applicant Signature: Lewis Godfrey Date: 7-19-19 Installed by: ____

IMPROVEMENT PERMIT by: ____ Date: ____ OPERATION PERMIT by: ____ Date: ____

AUTHORIZATION TO CONSTRUCT by: ____ Date: ____ Existing System Inspected by: Charles C. Cave Date: 8/16/19

FOR SEPTIC FINAL INSPECTION: CALL 704-664-3703 between 8am-9am the day the inspection is needed. Be sure to speak with an inpsector to confirm your inspection time.

SVL

APPLICATION MUST BE FILLED OUT COMPLETELY & BE LEGIBLE OR IT WILL NOT BE PROCESSED

24671
Pd $250

Iredell County Health Department – Environmental Health Division

PAGE 1: *APPLICATION FORM*

Application For: ( ) New Well Permit (X) Well Repair Permit ( ) Well Abandonment
( ) Septic Improvement Permit (X) Authorization to Construct (X) Existing System Inspection ( ) Septic System Repair

THE ABOVE PERMIT DOCUMENTS WILL BECOME INVALID IF INFORMATION PROVIDED ON THIS APPLICATION IS FALSIFIED OR CHANGED, OR IF THE SITE IS ALTERED. THE IMPROVEMENT PERMIT IS VALID FOR EITHER 60 MONTHS OR WITHOUT EXPIRATION DEPENDING UPON DOCUMENTATION SUBMITTED. APPLICATION WITH SITE PLAN 60 MONTHS, APPLICATION WITH COMPLETE, SCALED PLAT WITHOUT EXPIRATION. SEE ISA NCAC 18A .1937(f) FOR DETAILS.

Page 2: *Site Plan Worksheet* form MUST accompany this application

The following optional attachments may also be submitted: ( ) Survey Plat, scaled no more than 1 inch = 60 feet
Place an (X) beside whichever is submitted if applicable ( ) Custom Site Plan, scaled no more than 1 inch = 60 feet

Applicant Information: (PRINT CLEARLY)

Applicant Name: Gary Stickley Address: 2310S Miami Blvd Durham Zip: 27703
Applicant Email: gary@rentstackhouse.com Phone: 336-762-2856 Alt. Phone: Same
Owner Name: Stackhouse properties Address: 2810S Miami Blvd Durham Zip: 27703
Owner Email: gary@rentstackhouse.com Phone: 336 762-2856 Alt. Phone: _____

Property Information:

Street Address: 620 DARLENE LN
Subdivision Name: Harmony Meadows Section/Phase: _____ Lot Number: 120
Driving Directions: 77N to Hwy 21 Turnerstown Cmi Park on left 1st street To Right

Site Development Information: *(check or complete ALL that apply*

(X) New Single Family Residence
( ) New Multi-Family Residence
( ) Accessory Building
( ) Bedroom(s) Addition
( ) Repair to failing septic system ___ Tank ___ Drain lines Describe Problem: _____

Maximum Number of Bedrooms: 2
Maximum Number of Occupants: 4
( ) Swimming Pool
( ) Other Addition/Structure: _____

CHECK FOUNDATION TYPE
(X) Crawl Space Foundation
( ) Concrete Slab Foundation
( ) Basement with Plumbing
( ) Basement without Plumbing

Non-Residential Site Development: Type of Business: _____
Square Footage of Building: _____ Max. Number of Employees: _____ Max. Number of Seats/Beds/Other: _____

Water Supply: ( ) Replacement Well – Reason: _____
( ) Multi-connection Well Number of Houses: 15 Number of Persons: 60
( ) New Well ( ) Existing Well (X) Community Well ( ) City Water ( ) Other Public Water

Desired Septic System Type: *(you may rank in order of preference)* Year existing system installed: _____
( ) No Preference ( ) Alternative (X) Conventional ( ) Innovative ( ) Modified Conventional ( ) Other: _____

Please answer the following to the best of your ability:
( ) Yes (X) No Does the site contain any jurisdictional wetlands?
( ) Yes (X) No Is any non-domestic sewage (i.e. industrial) to be generated?
( ) Yes (X) No Is the site subject to approval by any other public agency?


I have read this application and certify that the information provided herein is true, complete, and correct. Authorized county and state officials are granted right of entry to conduct necessary inspections to determine compliance with applicable laws and rules. I understand that I am solely responsible for the proper identification and labeling of all property lines and corners and making the site accessible so that a complete site evaluation can be performed.

Signature: _____ 7-29
Property owner or owner's legal representative signature (SIGNATURE REQUIRED) DATE

IREDELL COUNTY DEPARTMENT of ENVIRONMENTAL HEALTH

SITE PLAN WORKSHEET

SEE THE "SAMPLE SITE PLAN" BELOW. ***INCOMPLETE SITE PLANS WILL BE RETURNED TO YOU FOR COMPLETION AND MAY RESULT IN A DELAY IN THE ISSUANCE OF YOUR SEPTIC SYSTEM OR WELL PERMIT!!!***

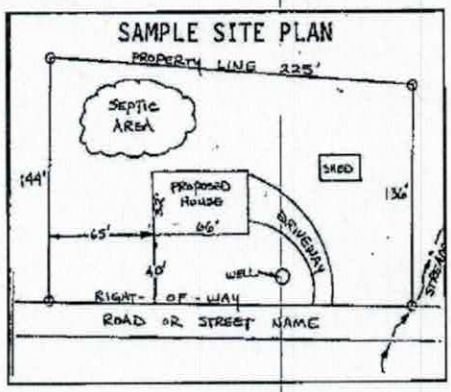

Place an (X) beside each item as you complete the site plan:


( ) **Property Line measurements are clearly identified**
( ) **All proposed structures are indicated**
( ) **Front and side setbacks from property line**
( ) **Preferred driveway location**
( ) **Preferred well location**
( ) **Preferred septic system location**
( ) **North arrow, or other sufficient indicator of direction**

Circle N/A on the following if appropriate:

Location of septic systems and wells within 100' of your property	**N/A**
Location of easements and rights of ways on your property	**N/A**
Location of any designated wetlands on the property	**N/A**

USE THIS SPACE TO DRAW YOUR SITE PLAN

Show: proposed house or business footprint, wells, water lines, patios, pools and decks, and any other item that will occupy space on the site

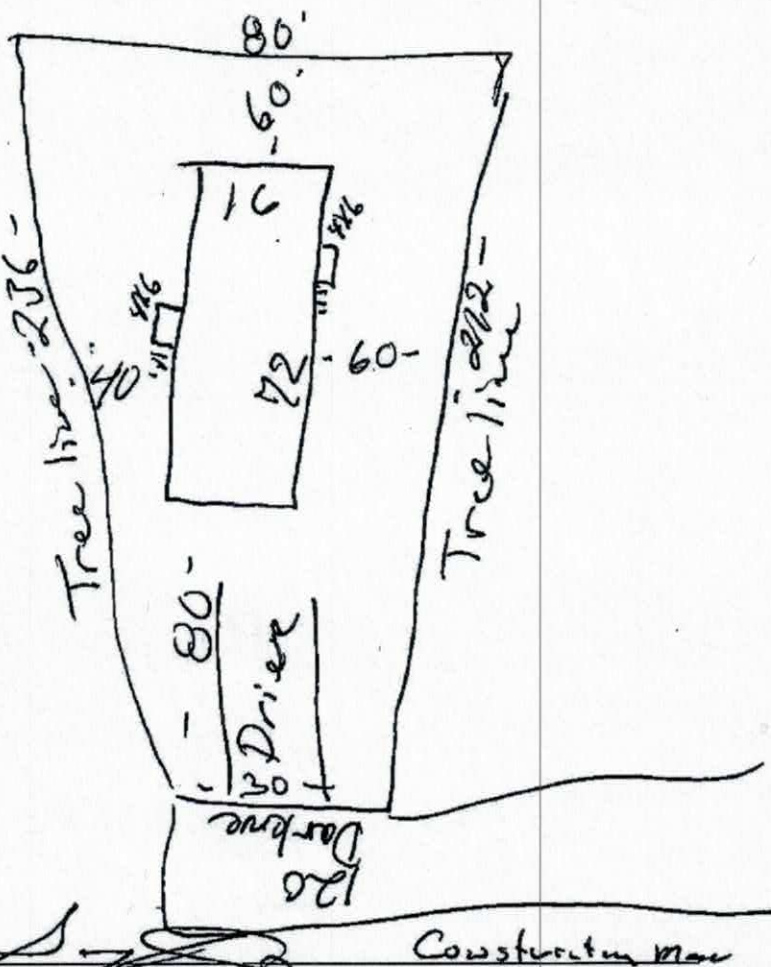

Signature: Construction Mgr **7/15/19**

Property owner or owner's legal representative signature (SIGNATURE REQUIRED) **DATE**

IREDELL COUNTY HEALTH DEPARTMENT

(SEPTIC TANK) IMPROVEMENTS PERMIT AND CERTIFICATE OF COMPLETION
(Ground Absorption Sewage Disposal System -- G. S. Chapter 130-Article 13C)

12843

OWNER OR CONTRACTOR WILLIAM P. BREWER DATE 8/19/91 PERMIT NO. 2H-A-41

PHONE: Business _____ Home _____

LOCATION US 21 N, TL BEL-AIRE DR JUST BEFORE HARMONY CHIROPRACTIC, TR DARLENE LANE, AT END ON (R) S. R. No. _____

SUBDIVISION NAME HARMONY MEADOWS LOT NO. 4 SECTION OR BLOCK NO. I

House ( ) Mobile Home (✓) Business ( ) Other _____

No. Bedrooms 2 No. Bathrooms 2

Garbage Disposal Unit Yes ( ) No (✓)
Auto. Dishwasher Yes (✓) No ( )
Auto. Wash. Machine Yes (✓) No ( )
Site Suitable Yes (✓) No ( )

Lot Area 1.[illegible]745 Ac


Character & Porosity of Soil PS
Percolation Rate .4 GPD / FT²
Topography 10-15% SS
Depth to Water Table > 4'
Rock or other impervious formations NONE

_____ Basement with Plumbing _____ Basement without Plumbing ✓ No Basement

Size of Tank 1000 Gals.

Nitrification Field:
No. of Lines 2
Sq. Ft. 600 Linear Ft. 200
Depth of Stone in Lines 12"

Water Supply: Individual ( )
Public (✓)

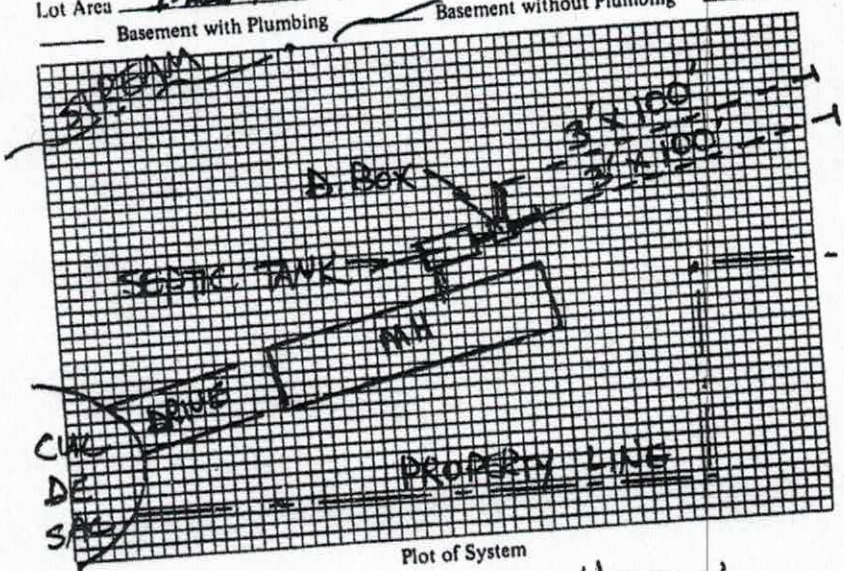

Plot of System

Installed by _____

I understand and agree to install septic tank system as specified on this Improvements Permit.

Signed: X Dennis Gaither

IMPROVEMENTS PERMIT BY STEVE HEDRICK

COMMENTS: ① KEEP SYSTEM MINIMUM 5' FROM MH, 50' FROM STREAM, 10' FROM PROPERTY LINE
② INSTALL LINES ON CONTOUR, NO DEEPER THAN 34", 9' ON CENTER


CERTIFICATE OF COMPLETION BY _____ DATE _____

EXISTING SYSTEM CHECKED BY: _____ DATE _____

CONSTRUCTION MUST COMPLY WITH ALL OTHER APPLICABLE STATE AND LOCAL REGULATIONS.

Permit is VOID if any unauthorized changes are made in installation of system and/or if any false information is supplied in making Improvements Permit. THIS PERMIT IS VALID FOR 60 MONTHS AFTER ISSUE DATE

Health Dept. Copy: White Inspection Dept. Copy: Yellow Sanitarian's Copy: Pink Owner's Copy: Gold

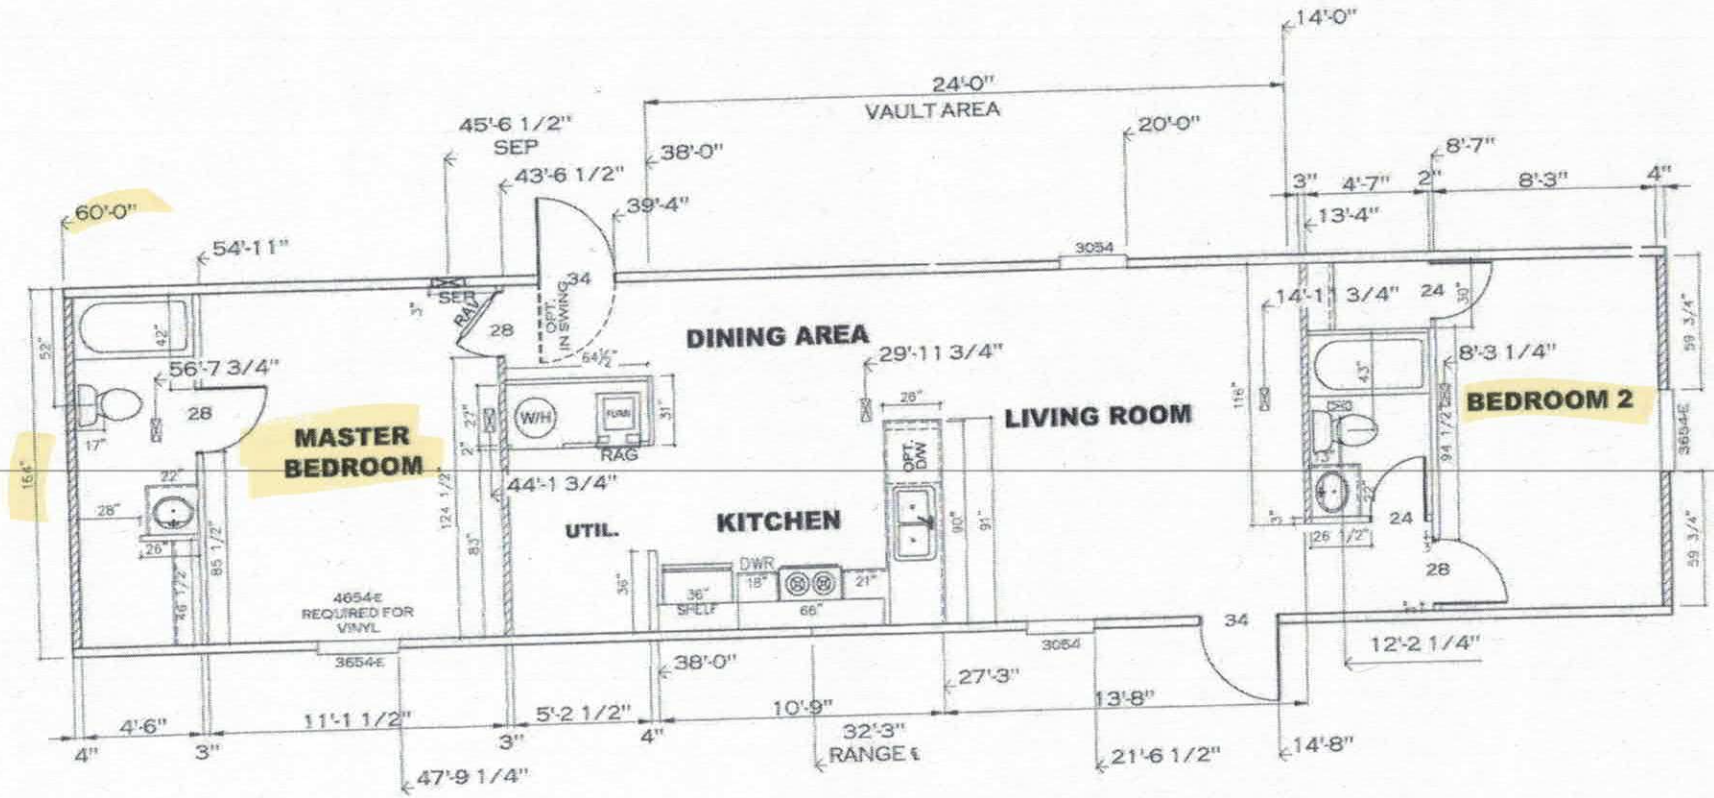

Acknowledgement Of
Plans Submittal ONLY!

Carla C. Cave Date 8-16-19

Date 8-19-19

820 SQ.FT. (STD PLAN "CONDITIONED")
N/A SQ.FT. (W/OPT. PORCH/RECESS "CONDITIONED")

TRU HOMES	Model # TRU14GD2A	Drawing #: TRU-5002-60-2
Product Designer: Hastings	Date: 1.31.14 Scale: 0.75	14' x 60' Delight
Floor Plan		REV:

IREDELL COUNTY DEPARTMENT OF ENVIRONMENTAL HEALTH

DOCUMENTATION TO AUTHORIZE AN OWNER'S LEGAL REPRESENTATIVE

Applications for permits require the "signature of the owner or owner's legal representative". (15A NCAC 18A .1937). If the owner does not sign the application himself or herself, they can submit any one of the following documents to designate their legal representative:

Power of Attorney; Real Estate Contract; Estate executor; Bankruptcy trustee; Court ordered guardianship

In the absence of the above documentation, the property owner may provide the local health department with documentation that designates a legal representative. A property owner may:

Complete this form to document his or her legal representative, or provide his or her own form that contains the information in this form.

If there are multiple property owners, then all property owners must sign the form that designates a legal representative.

By signing a form that designates a legal representative for purposes of 15A NCAC 18A .1937, the property owner authorizes that representative to act on their behalf in matters pertaining to the application and permitting process, including signing or receiving any application, document or permit. The owner retains full responsibility to meet all permit conditions specified by the local health department.

I, Jonathon Rinker, am the legal owner(s) of the property located at 120 Dockside, identified as PIN (Parcel Identification Number) _____, located in Iredell County, North Carolina.

I do hereby authorize (print legal representative/company name) Joe Pitman Lewis Autry Rocy Applekamp, to act as an agent on my behalf in applying for/signing/obtaining any of the documents described below.

- Application for Improvement Permit (IP) / Authorization to Construct (AC)
- Improvement Permit (IP) / Authorization to Construct (AC)
- Application for soil-site evaluation (new/repair)
- Application/permit for private drinking water well/well abandonment
- Application for Compliance Inspection

I agree to abide by all decisions and/or conditions between the legal representative acting on my behalf and the Iredell County Department of Public Health, Environmental Health Division.

Signature of Owner(s) 7/31/19 Date

Signature of Witness 7/31/19 Date

Please return this signed form to the appropriate office:

Mooresville - Environmental Health
ronda.hart@co.iredell.nc.us
Fax: 704-662-3239
610 E. Center Avenue, Mooresville, NC 28115

Statesville - Environmental Health
adrienne.shea@co.iredell.nc.us
Fax: 704-871-3483
349 N. Center Street, Statesville, NC 28677

IREDELL COUNTY

PO Box 788
349 North Center St.
Statesville, NC 28677

APPLICATION NUMBER
246671
Issue Date: 07/15/2019

ZONING PERMIT
Open Space

Parcel Number	Street Address	Jurisdiction
4779185366.000	120 DARLENE LANE, HARMONY, NC	IREDELL COUNTY

Owner Information		Applicant Information	
Owner:	HARMONY MEADOWS LLC	Applicant:	JONES ESTATES
Address:	3480 JIM JOHNSON RD CONCORD, NC 28027	Address:	2310 MAIMIE DURHAM, NC 27703
Phone:		Phone:	

Use Requested	Zone Code
MOBILE HOME SINGLEWIDE	RA

Lot Acreage	F Setback	B Setback	L Setback	R Setback	Watershed	Flood Zone	
1.745	35.00	35.00	15.00	15.00	NOT		X

Remarks:


Must meet requirement R10 of the LDC. Must remove the towing apparatus, if it cannot be removed, it shall be screened; Must have a continuous underpinning; Must have 36 square foot front porch constructed within 12 inches of the floor elevation; Must have approved steps at all other secondary entrances and exits; Must face front property line and be no less than 20 degrees from parallel to the front property line. Original home must be removed before Certificate of Occupancy can be approved.

The applicant certifies that there are no deed restrictions, contractual agreements or governmental regulations of any kind that interfere with or prohibit the use of the property or the use for which this permit is requested. The applicant further acknowledges that enforcement of deed restrictions, plat conditions and other contractual agreements will not be undertaken by Iredell County and is the sole responsibility of the affected parties.

Applicant: _____ Date: _____

Permit Number	185185	TOTAL FEES:	$ 77.25

ZONING DISCLAIMER

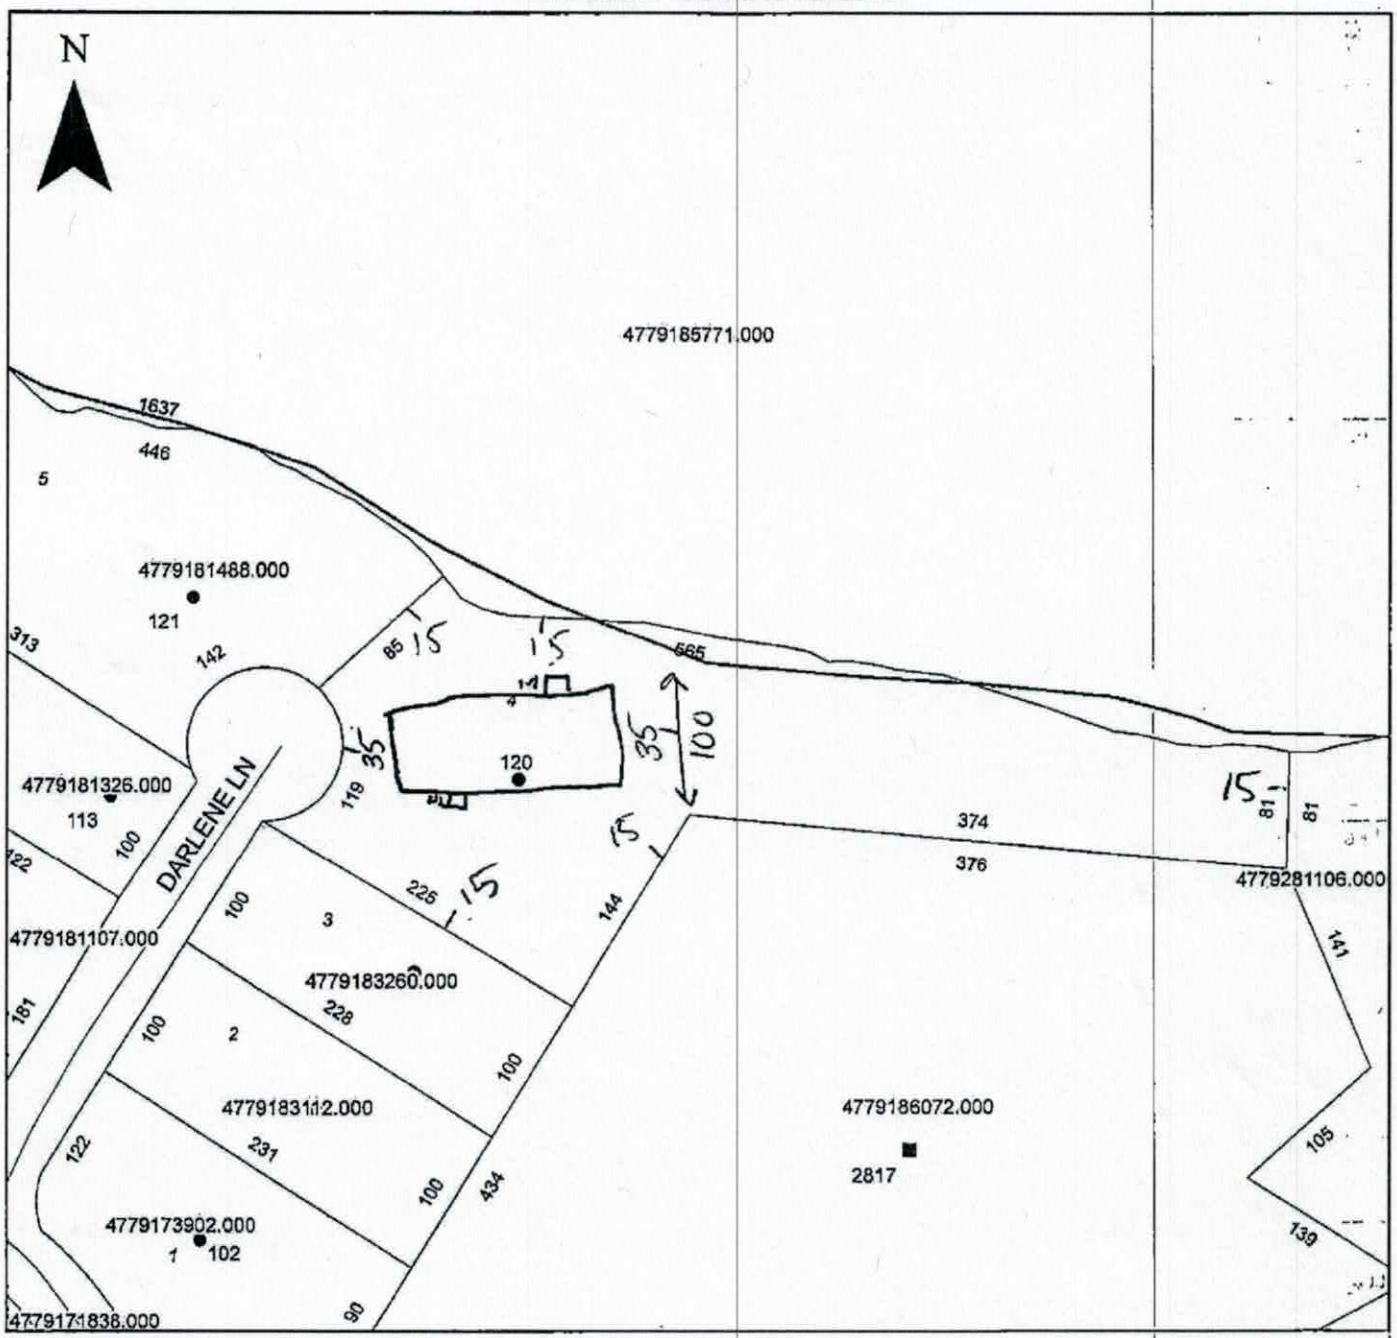

Property Address 120 Darlene

The applicant certifies that there are no deed restrictions, contractual agreements or governmental regulations of any kind that interfere with or prohibit the use of the property or the use for which this permit is requested. Applicant further acknowledges that the enforcement of deed restrictions, plat conditions, and other contractual agreements will not be undertaken by Iredell County and is the sole responsibility of the affected parties.

X _____
Applicant

X 7/15/19
Date