IREDELL COUNTY HEALTH DEPARTMENT

STATESVILLE 704-878-5305 MOORESVILLE 704-664-5281

IMPROVEMENT PERMIT / CERTIFICATE OF COMPLETION / OPERATION PERMIT / EXISTING SYSTEM INSPECTION

PROPERTY DESCRIPTION NO. 21754 DATE 7-24-95 TAX MAP NO. 12H - A - 102 Watershed: ☐ Yes ☑ No

OWNER OR CONTRACTOR G & G BUILDING PHONE: Business Home 871-7295

ADDRESS 184 SERENITY DR MOCKSVILLE, NC 27028

LOCATION US 21 N, TR BETHEL RD, TR MARSHALL FARM ROAD, AT END OFF ROAD ~ 1800 FT.

SUBDIVISION BLOCK / SECTION LOT LOT AREA 71 ACRES SITE CLASS. PS DESIGN FLOW 360 L.T.A.R. 0.35 GPD/FT²

Septic Tank: 1000 Gallons; STB 1012 Date 6-27-95

Pump Tank: Gallons; PT Date

Pump Make: Model Serial No.

Nitrification Field: No Fields 1 Square Feet 1035 Linear Feet 345

No Lines 3 Trench Width 36" Max Trench Bottom Depth 18-36" Gravel Depth 12"

☑ New System ☐ Repair System Type: I, II, III, IV, V, VI

System Description: ③ NUDONAL GRAVITY

Repair System Description: CONV. GRAVITY

Maintenance Agreement Required: ☐ Yes ☑ No

☑ House/Mod. Home ☐ Mobile Home ☐ Business ☐ Other

No. Bedrooms No. Bathrooms No. Employees


☐ Slab ☐ Crawl Space ☑ Basement w/plumbing ☐ Basement wo/plumbing

Water Supply: ☑ Individual ☐ Community ☐ Public WELL

Comments: ① KEEP SYSTEM MINIMUM 100' FROM WELL, 20' FROM BASEMENT FOUNDATION DRAIN ② INSTALL LINES ON CONTOUR, NO DEEPER THAN 36" ③ MH TO BE REMOVED UPON OCCUPANCY OF HOUSE

Comments:

INITIAL SITE SKETCH

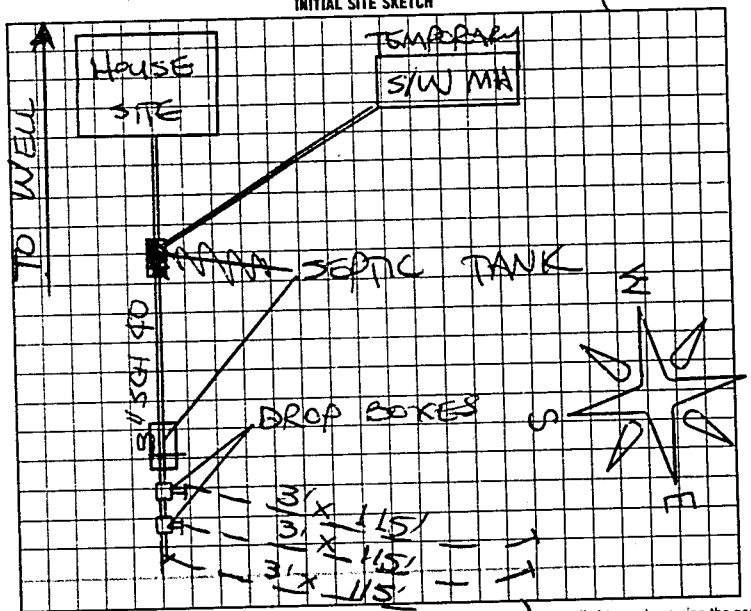

AS BUILT SKETCH

SYSTEM INSTALLED ACCORDING TO INITIAL SITE SKETCH

I understand that this permit can be suspended or revoked if any false information is supplied toward securing the permit/any unauthorized changes are made to the site/any unauthorized changes are made in the installation of the system. Improvement Permit is valid for 60 months from date of issuance.

Signed: Michael L. Bartha Improvement Permit by: STEVE HENDRICK date 7-24-95

Existing System Inspection by: date

Installed by: DAVID YOUNTZ STEVE HENDRICK date 9-7-95

Certificate of Completion by: Operation Permit by date

HEALTH DEPT. COPY: WHITE INSPECTION COPY (FINAL): GREEN OWNER COPY (FINAL): YELLOW INSPECTION COPY (INITIAL): PINK OWNER COPY (INITIAL): GOLD

182000