IREDELL COUNTY HEALTH DEPARTMENT

STATESVILLE 704-878-5305 (C1) MOORESVILLE 704-664-5281

IMPROVEMENT PERMIT / AUTHORIZATION TO CONSTRUCT / OPERATION PERMIT / EXISTING SYSTEM INSPECTION

PERMIT# 110344 PIN# 4779-27-3244 DATE 12-31-02

OWNER OR CONTRACTOR FLEETWOOD HOMES OF TROUTMAN PHONE: Business 704-528-7120 Home 704-363-6964

ADDRESS 1040 CHARLOTTE HWY, TROUTMAN, NC 28166

LOCATION US 21 NORTH, TR MT. BETHEL ROAD, TR ARROWBROOK ROAD, ON RIGHT AT BOX #166

SUBDIVISION _____ BLOCK / SECTION _____ LOT _____ LOT AREA 0.63 ACRE SITE CLASS. PS DESIGN FLOW 480 L.T.A.R. EXISTING

NEW

Septic Tank: 1000 Gallons; STB 1012 Date 6-11-02

Pump Tank: _____ Gallons; PT _____ Date _____

Pump Make: _____ Model _____ Serial No. _____

Nitrification Field: No Fields 1 Square Feet _____ Linear Feet EXISTING 480

No Lines 4 EXISTING Trench Width _____ Max Trench Bottom Depth _____ Gravel Depth _____

☑ New System ☐ Repair System Type: I, II, III, IV, V, VI

System Description: CONVENTIONAL, GRAVITY

Repair System Description: _____

Maintenance Agreement Required: ☐ Yes ☑ No

☑ House/Mod. Home No. Bedrooms 4

☐ Mobile Home No. Bathrooms 2

☐ Business No. Employees _____

☐ Other _____


☐ Slab ☑ Crawl Space ☐ Basement w/plumbing ☐ Basement wo/plumbing

Water Supply: ☐ Individual ☑ Public ☐ Community

Comments/Conditions: INSTALL NEW SEPTIC TANK AS SHOWN, OPEN DISTRIBUTION BOX AND SET EQUAL DISTRIBUTION USING 1" SPEED LEVELERS

Comments/Conditions: ① SEPTIC TANK WITH MARKER INSTALLED USING "TUFFITE" FILTER ② NEW DIST. BOX INSTALLED, DEEP (4')

INITIAL SITE SKETCH

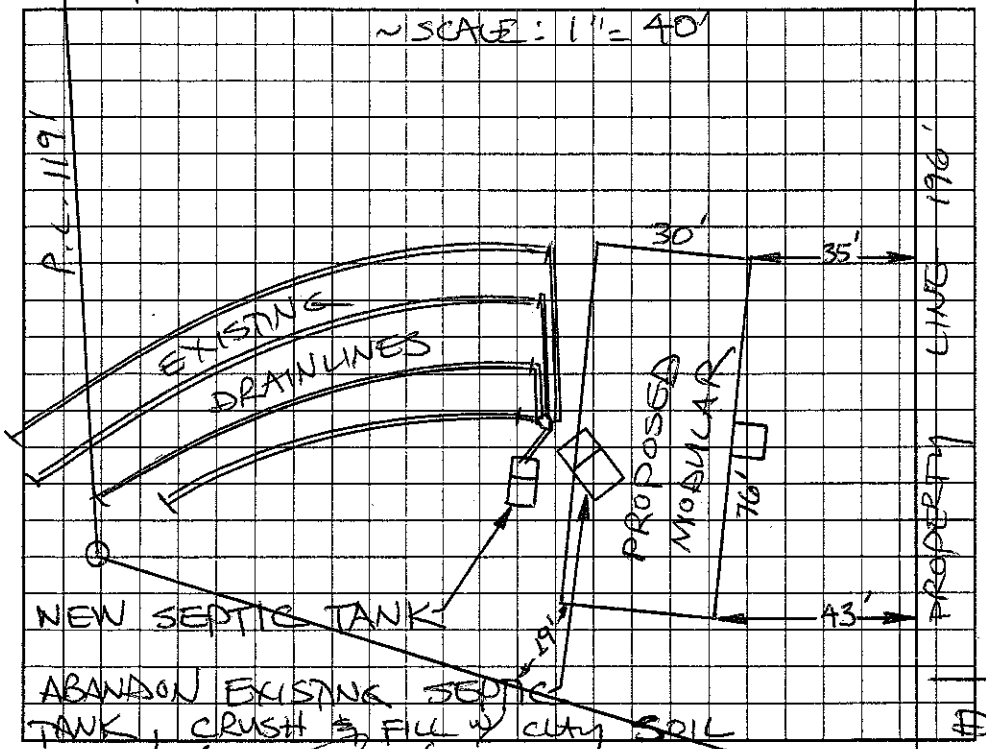

AS BUILT SKETCH

SEPTIC TANK INSTALLED ACCORDING TO INITIAL SITE SKETCH

Permit can be suspended or revoked if any false information is supplied toward securing the permit/any unauthorized changes are made to the site/any unauthorized changes are made in the installation of the system. Improvement Permit with plat valid without expiration/Improvement Permit with site plan valid for sixty months/Authorization to Construct is valid for a period equal to that of Improvement Permit – not to exceed sixty months.

Signed: _____ date 12-31-02 Installed by: A-1 BACKHOE

Improvement Permit by: STEVE HEDRICK date 12-31-02 Operation Permit by: STEVE HEDRICK date 1-7-03

Authorization to Construct by: STEVE HEDRICK date 12-31-02 Existing System Inspection by: _____ date _____

HEALTH DEPT. COPY: WHITE OWNER COPY (FINAL): YELLOW OWNER COPY (INITIAL): PINK