IREDELL COUNTY HEALTH DEPARTMENT

STATESVILLE 704-878-5305 MOORESVILLE 704-664-5281

IMPROVEMENT PERMIT / AUTHORIZATION TO CONSTRUCT / OPERATION PERMIT / EXISTING SYSTEM INSPECTION

PERMIT# 084274 PIN# 4779 27 3244 DATE 10-22-99

OWNER OR CONTRACTOR MARION COFFEY PHONE: Business 546-7965 Home 546-5082

ADDRESS P.O. BOX 15, TURNERSBURG, NC 28688

LOCATION US 21 N, TR MT. BETHEL ROAD, TR ARROWBROOK ROAD, on RIGHT AT BOX #166

SUBDIVISION BLOCK / SECTION LOT LOT AREA 0.63 ACRE SITE CLASS PS1 DESIGN FLOW 360 L.T.A.R. EXISTING

Septic Tank: 1500 Gallons; STB Date

Pump Tank: Gallons; PT Date

Pump Make: Model Serial No

Nitrification Field: No Fields 1 Square Feet Linear Feet 480

No Lines FOUR Trench Width Max Trench Bottom Depth Gravel Depth

New System Repair System Type: I II III IV V VI

System Description: CONVENTIONAL GRAVITY

Repair System Description

Maintenance Agreement Required Yes ✓ No

Slab ✓ Crawl Space Basement w/plumbing Basement w/o plumbing

✓ House/Mod. Home No. Bedrooms 3

✓ Mobile Home No. Bathrooms 2

Business No. Employees


Other

Water Supply: ☐ Individual ☒ Public ☐ Community


Comments/Conditions

Comments/Conditions SYSTEM UNDERSIZED BY TODAY'S STANDARDS LINES INSTALLED OUT OF CONTOUR.

INITIAL SITE SKETCH

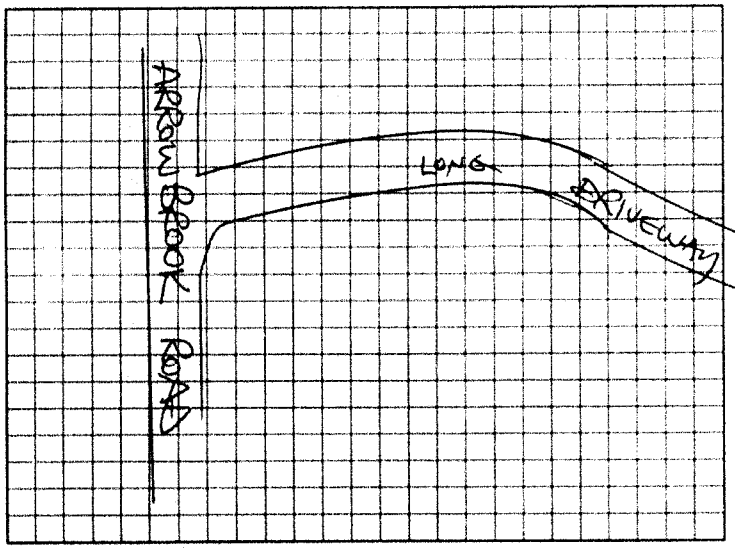

AS BUILT SKETCH

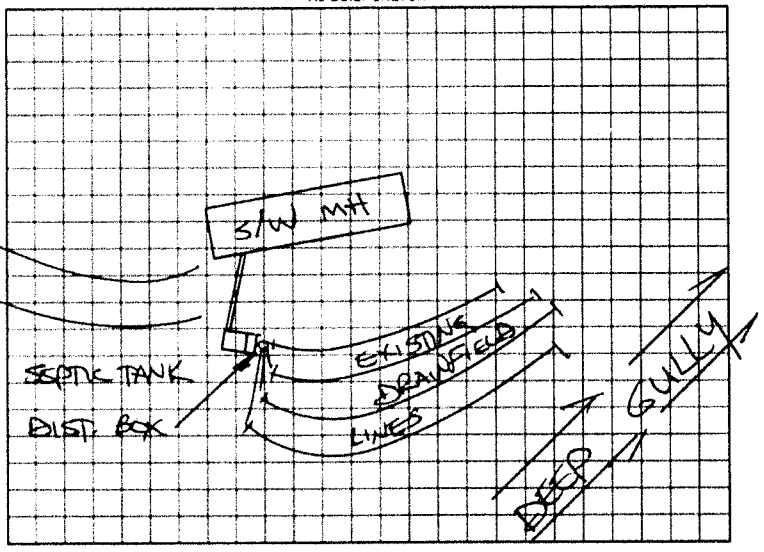

Permit can be suspended or revoked if any false information is supplied toward securing the permit; any unauthorized changes are made to the site; any unauthorized changes are made in the installation of the system. Improvement Permit with plat valid without expiration. Improvement Permit with site plan valid for sixty months. Authorization to Construct is valid for a period equal to that of Improvement Permit -- not to exceed sixty months.

Signed: date

Improvement Permit by: date

Authorization to Construct by: date

Installed by

Operation Permit by date

Existing System Inspection by STEVE HEDRICK date 10-22-99

HEALTH DEPT COPY WHITE OWNER COPY (FINAL) YELLOW OWNER COPY (INITIAL) PINK