IREDELL COUNTY HEALTH DEPARTMENT - *ENVIRONMENTAL HEALTH* ☑ STATESVILLE OFFICE 704-878-5305 ☐ MOORESVILLE OFFICE 704-664-5281

IMPROVEMENT PERMIT / AUTHORIZATION TO CONSTRUCT / OPERATION PERMIT / EXISTING SYSTEM INSPECTION

PERMIT # 165597 PIN # 4779-27-3211 DATE 1 Apr 2011

OWNER Jeffrey Parsons APPLICANT: Ashley Mann PHONE: Home/Cell # (704) 902-3116 Business #

SITE ADDRESS 166 Arrowbrook Rd. OWNER / APPLICANT ADDRESS

SITE DIRECTIONS Hwy 21 N TR Mt. Bethel TR Arrowbrook Rd. - ON RT

SUBDIVISION BLOCK / SECTION LOT # LOT AREA 0.63ac. DESIGN FLOW 360gpd L.T.A.R. Existing

Existing — Septic Tank 1000 Gallons: STB Date
Pump Tank Gallons: P T Date
Pump Make Model Serial #
Existing — No. Nitrification Fields: 1 No. Lines 4 Linear Feet 360ft
Trench Width Exist. Max. Trench Bottom Depth Exist Gravel Depth Exist.

☐ New System ☐ Repair ☐ Expansion System Type I ☑ II IV V VI
System Description: Conventional gravity
Repair System Description:
Maintenance Agreement Required ☐ YES ☑ NO
☑ GRAVITY ☐ PRESSURE

☑ Residence No. Bedrooms 3
☐ Business No. Persons
☐ Other No. Employees
☐ Slab ☑ Crawl Space
☐ Basement w/plumbing ☐ Basement w/o plumbing


Water Supply: ☐ Private ☑ Public ☐ Community

Comments / Conditions: Exist. line cut back 10' from property line. Approved for 3BR Hand dug.

* This permit replaces one issued 1-7-03.

INITIAL SITE SKETCH

AS BUILT SKETCH

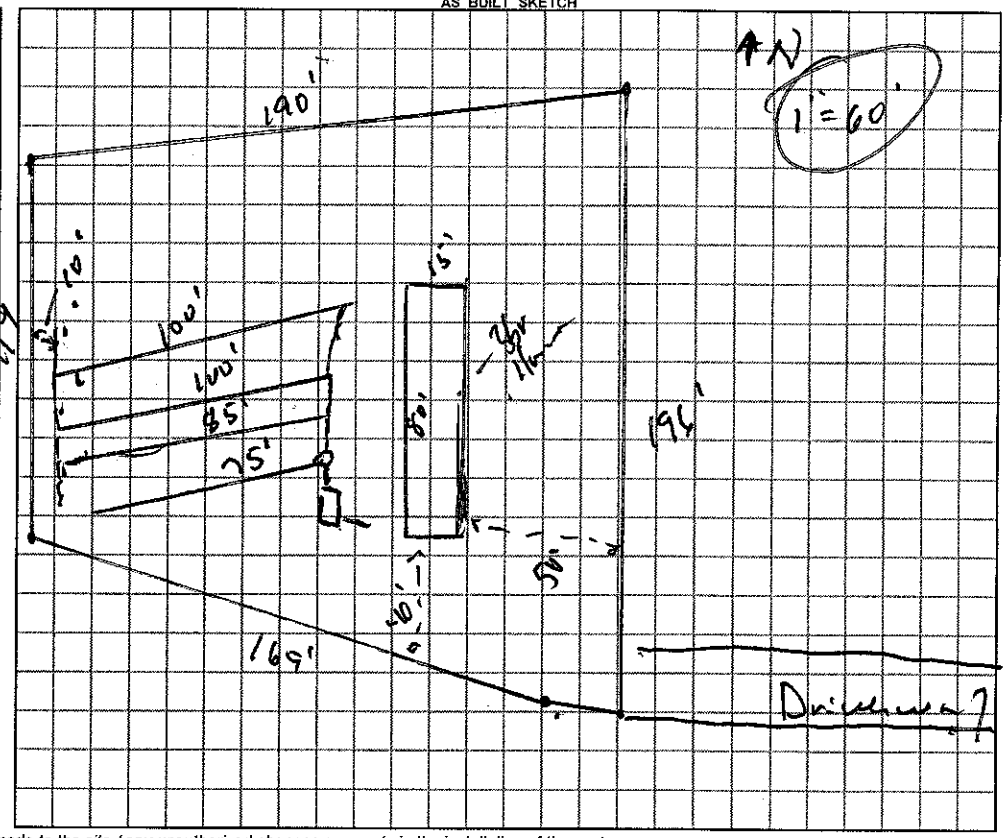

Permit can be suspended or revoked if any false information is supplied toward securing the permit / any unauthorized changes are made to the site / any unauthorized changes are made in the installation of the system.

☐ ***IMPROVEMENT PERMIT*** with plat valid without expiration. ☐ ***IMPROVEMENT PERMIT*** with plat valid ~~without expiration~~ site plan valid 60 mo. ☐ ***AUTHORIZATION TO CONSTRUCT*** valid for period equal to IMPROVEMENT PERMIT--not to exceed 60 mo.

Owner / Applicant Signature: Date 4-1-11 Installed by:

IMPROVEMENT PERMIT by: REHS Date OPERATION PERMIT by: REHS Date

AUTHORIZATION TO CONSTRUCT by: REHS Date Existing System Inspected by: REHS Date 1 Apr 2011

YOU SHOULD CONTACT A LOCATOR SERVICE PRIOR TO ANY EXCAVATION

White Copy – Environmental Health YELLOW COPY (Final) Owner / Applicant PINK COPY (Initial) Owner / Applicant